

CONSTRUCTION SUMMARY  
Legacy Hill - Trinigroup Development Inc.

RECEIVED  
OCT 18 2023

PURCHASER: Tengda GAO TEL:

|                       |             |                              |  |  |
|-----------------------|-------------|------------------------------|--|--|
| LOT / PHASE<br>78 / 1 | REG. PLAN # | HOUSE TYPE<br>Villa 7 Elev 3 |  |  |
|-----------------------|-------------|------------------------------|--|--|

CONSTRUCTION

|  |  |
|--|--|
| 1 - LOWER LEVEL - BASEMENT 8 FOOT 6 INCH CONCRETE POUR - MEASURED FROM TOP OF FOOTING TO TOP OF FOUNDATION WALL<br>17Oct23 Note: |  |
| 1 - FIRST FLOOR INCREASE CEILING HEIGHT FROM 9 FEET TO 10 FEET<br>17Oct23 Note:  |  |
| 3 - ENLARGED BASEMENT WINDOWS (MAY REQUIRE WINDOW WELLS) - WINDOW IS 30 INCHES X 24 INCHES<br>17Oct23 Note:                      |  |

PROMOTIONAL

|  |  |
|--|--|
| 1 - LESS CREDIT FROM PURCHASER EXTRA SHEET IN OFFER<br>17Oct23 Note: |  |
|--|--|

EXTRAS AS PER OFFER

|   |  |
|---|--|
| The Vendor agrees that notwithstanding any other term or provision in this Agreement included in the Purchase Price and in addition to those items detailed in Schedule GP to the Agreement of Purchase and Sale, the Purchaser is entitled to a credit of Ten<br>Worksheet Note: |  |
|---|--|

This Document is Extremely Time Sensitive - Printed 18 Oct 23 at 9:22






# Villa 7 36' Lot

Elev. 1: 2,783 sq.ft. Elev. 2: 2,783 sq.ft. Elev. 3: 2,783 sq.ft.  
Includes 20 sq.ft. of Open Area

EH

LOT #78

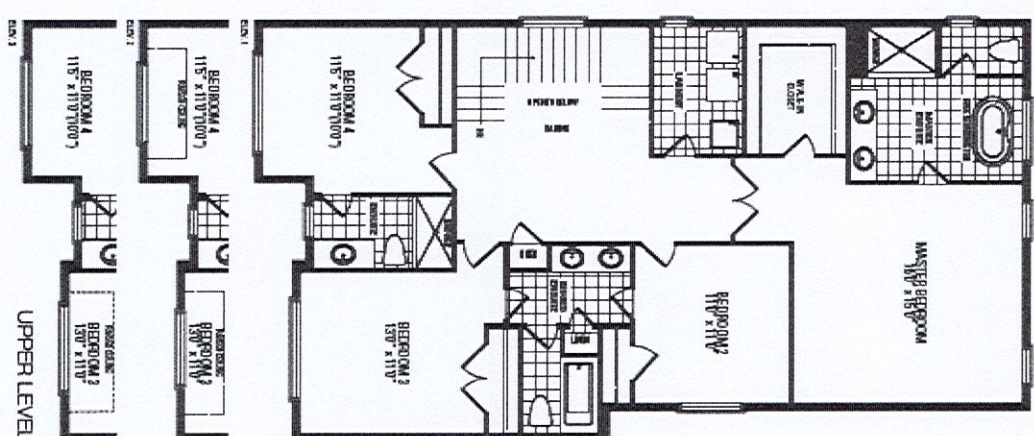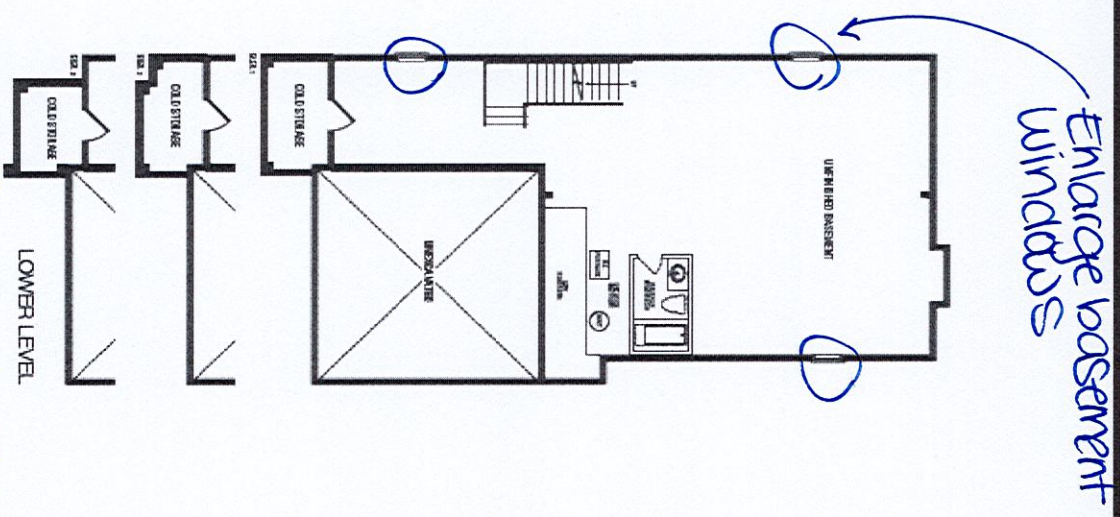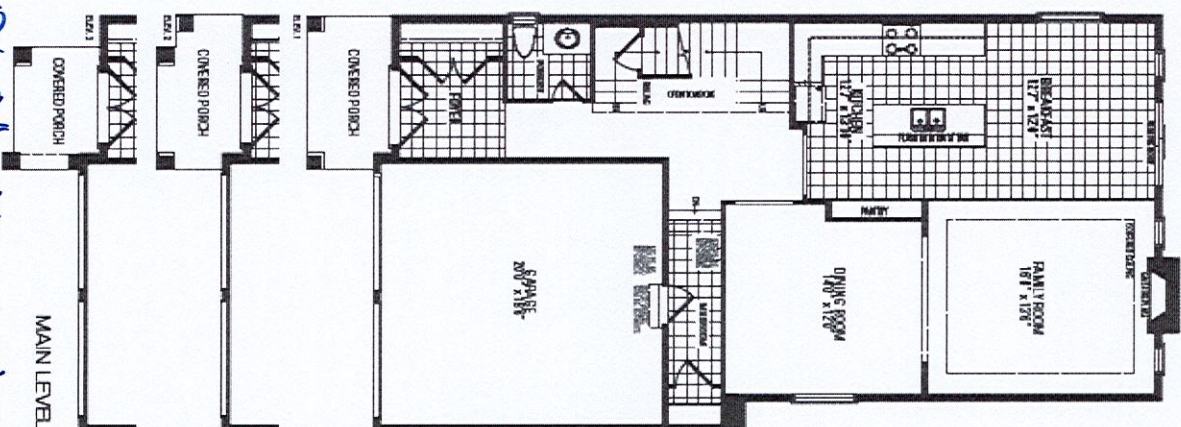

\*10'-0" ceiling height  
Orientation of home may be reversed and purchaser agrees to accept the same. Steps and porches may vary at any exterior entrance ways due to grading variance. Actual usable floor space may vary from the stated floor areas. All renderings are artist's concept. Dimensions, specifications and architectural detailing subject to modifications. Roofline and adjoining model types may vary due to siting. E. & O. E. September 2023