



CORPORATION OF THE CITY OF OSHAWA  
TRUE COPY  
OF PERMIT PLANS  
Nov 15 2023  
PER: *C. M...*  
CHIEF BUILDING OFFICIAL

MHP 23028

BUILDING PERMIT COVER PAGE  
Development Services Department  
Building Permit and Inspection Services

BUILDING PERMIT PLANS REVIEW	ACCEPTED AS NOTED	
	REVIEWED BY	DATE
ZONING		
PLANNING		
ARCHITECTURAL	CM	NOV 15, 2023
STRUCTURAL		
FIRE		
PLUMBING	CARD	
MECHANICAL		
PLANS REVIEW COMPLETED	CM	NOV 15, 2023

SOIL CONDITIONS

SOIL CONDITIONS SHALL BE VERIFIED BY A PROFESSIONAL ENGINEER COMPETENT IN THE FIELD OF SOIL ENGINEERING, PRIOR TO PLACING ANY FOUNDATION.

THE PERMIT PLANS HAVE BEEN REVIEWED FOR ONE (1) DWELLING UNIT. ANY FUTURE CHANGES WILL REQUIRE A SEPARATE BUILDING PERMIT

PLUMBING INSTALLATIONS

ALL PLUMBING INSTALLATIONS ARE TO BE DONE BY A PLUMBING CONTRACTOR POSSESSING AN ONTARIO COLLEGE OF TRADES MEMBERSHIP. NO PLUMBING IS TO BE COVERED UNTIL INSPECTED AND APPROVED BY A PLUMBING INSPECTOR. TELEPHONE 905-436-5658 WHEN READY FOR AN INSPECTION AND TESTING.

ALL STANDARDS REFERRED TO IN THESE BUILDING PERMIT DOCUMENTS SHALL BE THE EDITION DESIGNATED IN OBC 2012 AS AMENDED.

FUTURE ALTERATIONS

A SEPARATE BUILDING PERMIT IS REQUIRED FOR ANY PROPOSED INTERIOR PARTITIONS AND/OR ALTERATIONS.

NOTE:

IT IS RECOMMENDED THAT CRUSHED CONCRETE OR SLAG AGGREGATE **NOT** TO BE USED FOR BACKFILL UNDER CONCRETE SLABS, AROUND SEWER LATERALS OR WEEPERS.

RAIN WATER DOWNSPOUTS ARE TO BE DISCHARGED AT GRADE AND NOT CONNECTED TO WEEPING TILES.

COPY OF THE STAMPED/REVIEWED DRAWINGS MUST REMAIN ON SITE DURING CONSTRUCTION.

MHP CERTIFICATION

ALL MARKUPS AND STAMPS APPLIED TO BASE MODEL AND BASE ELEVATION SHALL APPLY AS APPLICABLE TO THE ENTIRE MODEL HOUSE PLAN

AS BUILT SURVEY

UPON COMPLETION OF THE FOUNDATION, A SURVEY PREPARED BY AN ONTARIO LAND SURVEYOR INDICATING THE LOCATION OF THE BUILDING TO ALL PROPERTY LINES IS REQUIRED TO BE SUBMITTED TO THE BUILDING DEPARTMENT

IMPORTANT NOTE

NEITHER THE ISSUANCE OF A PERMIT NOR THE CARRYING OUT OF INSPECTIONS BY THE CITY RELIEVE THE APPLICANT FROM FULL RESPONSIBILITY FOR COMPLIANCE WITH THE PROVISIONS OF THE BUILDING CODE ACT AND THE ONTARIO BUILDING CODE, BOTH AS AMENDED, AS WELL AS OTHER APPLICABLE STATUTES AND REGULATIONS OF THE PROVINCE OF ONTARIO AND ALL RELEVANT BY-LAWS OF THE CITY OF OSHAWA AND THE REGIONAL MUNICIPALITY OF DURHAM.

OBC 9.10.14.5 - CLADDING

CLADDING ON THE EXPOSING BUILDING FACE IS PERMITTED TO BE VINYL WHEN WITHIN 600mm OF PROPERTY LINE, PROVIDED THAT THE VINYL CONFORMS TO OBC DIV. B. 9.27.13. IS INSTALLED OVER SHEATHING PAPER AND 12.7mm DRYWALL, HAS A FLAME SPREAD RATING NOT GREATER THAN 25, AND IS NOT MORE THAN 2mm THICK AND THE ENTIRE EXTERIOR WALL HAS A MINIMUM FIRE RESISTANCE RATING OF ¾ HOURS.

PREFABRICATED WOOD TRUSSES

FABRICATION AND ERECTION DRAWINGS WITH DESIGN DATA, PREPARED AND SEALED BY A PROFESSIONAL ENGINEER, MUST BE AVAILABLE ON SITE FOR REVIEW BY THE BUILDING INSPECTOR

ROOF CEILING INSULATION

ROOF FRAMING OR TRUSS HEEL JOINT MUST PERMIT SUFFICIENT SPACE FOR THE EXTENSION OF THE ROOF-CEILING INSULATION OVER EXTERIOR WALLS MINIMIZE THERMAL BRIDGES. AN UNOBSTRUCTED VENTILATION SPACE MUST BE PROVIDED OVER EXTERIOR WALLS TO ALLOW UNIMPEDED AIR FLOW FORM SOFFIT VENTS TO ROOF VENTS.

ALL ELECTRICAL WIRING MUST BE INSPECTED BY THE ELECTRICAL SAFETY AUTHORITY. SEPARATE INSPECTION APPLICATIONS (PERMITS) MUST BE FILED. WE RECOMMEND YOU USE A QUALIFIED ELECTRICAL CONTRACTOR. FOR MORE INFORMATION PLEASE CALL:



ELECTRICAL  
SAFETY  
AUTHORITY

1-877-ESA-SAFE  
OR VISIT  
WWW.ESASAFE.COM

BEDROOM WINDOWS

- (1) EVERY FLOOR LEVEL CONTAINING BEDROOMS IN A *SUITE* SHALL BE PROVIDED WITH AT LEAST 1 OUTSIDE WINDOW THAT CAN BE OPENED FROM THE INSIDE WITHOUT THE USE OF TOOLS, AND EACH SUCH WINDOW SHALL PROVIDE AN INDIVIDUAL, UNOBSTRUCTED OPEN PORTION HAVING A MINIMUM AREA OF 0.35M<sup>2</sup> (3.8 SQ.FT.) WITH NO DIMENSION LESS THAN 380 MM (15 IN).
- (2) EXCEPT FOR *BASEMENT* AREAS, THE WINDOW DESCRIBED IN SENTENCE (1) SHALL HAVE A MAXIMUM SILL HEIGHT OF 1M (3 FT 3 IN) ABOVE THE FLOOR.
- (3) WHEN SLIDING WINDOWS ARE USED, THE MINIMUM DIMENSION DESCRIBED IN SENTENCE (1) SHALL APPLY TO THE OPENABLE PORTION OF THE WINDOW.

ATTIC HATCHES SHALL NOT BE LESS THAN 550mm (21 5/8") BY 900mm (35")

OBC 9.26.4.1.

FLASHING REQUIRED AT ALL ROOF-WALL JUNCTIONS

INTERIOR FINISH OF EXITS

THE FLAME SPREAD RATING OF WALL OR CEILING FINISH IN AN EXIT MUST NOT EXCEED 25.

INTERIOR FINISH (EXCEPT EXITS)

FLAME SPREAD RATING OF INTERIOR FINISH MATERIALS SHALL NOT EXCEED 150 ON WALLS AND 150 ON CEILINGS. COMBUSTIBLE WALL AND CEILING FINISHES SUCH AS WOOD, PLYWOOD, PLASTIC, FABRIC, CARPET, ETC. MUST BE APPROVED BY THE INSPECTOR PRIOR TO THE INSTALLATION.

DIV.B. 9.10.14.1 EXPOSING BUILDING FACE OF HOUSES

UNPROTECTED OPENINGS IN THE EXPOSING BUILDING FACE SHALL NOT BE PERMITTED IF THE LIMITING DISTANCE IS LESS THAN 1.2m (3'11") AND SHALL BE LIMITED IN CONFORMANCE WITH THE REQUIREMENTS FOR UNPROTECTED OPENINGS IN DIV. B ARTICLE 9.10.15.1. WHERE THE LIMITING DISTANCE IS 1.2m (3'11") OR GREATER.

THE EXPOSING BUILDING FACE SHALL HAVE A FIRE RESISTANCE RATING OF NOT LESS THAN 45 MINUTES WHERE THE LIMITING DISTANCE IS LESS THAN 1.2m.

RESISTANCE TO FORCED ENTRY  
2012 O.B.C. DIV B. 9.7.5.2. & 9.7.5.3.

1. SWINGING DOORS PROVIDING ACCESS TO DWELLING UNITS SHALL SATISFY THE REQUIREMENTS FOR RESISTANCE TO FORCED ENTRY AS DESCRIBED IN SUBSECTION 9.7.5.2.
2. WINDOWS IN DWELLING UNITS THAT ARE LOCATED WITHIN 2M OF ADJACENT GROUND LEVEL SHALL CONFORM TO THE REQUIREMENTS FOR RESISTANCE TO FORCED ENTRY AS DESCRIBED IN CLAUSE 5.3.5.OF AAMA/WDMA/CSA 101/I.S.2/A440.

A return air inlet shall be located in any room where at least 1/2 of the floor area is located over an unconditioned space (e.g. room over a garage)

2012 Code

9.8.8.1.(8)(a)(b) Windows over Stairs, Ramps and Landings

- (2) In *dwelling units*, glazing installed over stairs, ramps and landings that extend to less than 900 mm (2 ft 11 in) above the surface to the treads, ramp or landing shall be,
- (a) protected by *guards*, in accordance with this Subsection, or
  - (b) non-openable and designed to withstand the specified lateral loads for *guards* as provided in Article 4.1.5.14.

2012 OBC DIV. B, 9.8.2.1. to 9.8.4.7. STAIR DIMENSIONS						
STAIR TYPE	MAX. RISE, mm, ALL STEPS	MIN. RISE, mm, ALL STEPS	MAX. RUN, mm RECTANGULAR TREADS	MIN. RUN, mm RECTANGULAR TREADS	STAIR WIDTH, mm	HEADROOM, mm
PRIVATE STAIRS	200	125	355	255	860	1950
PUBLIC STAIRS	180	125	NO LIMIT	280	900	2050
SERVICE STAIRS	NO LIMIT	125	355	NO LIMIT	900	2050
STAIR TO UNOCCUPIED ATTIC SPACE	NO LIMIT	125	355	NO LIMIT	860	1950
STAIRS TO CRAWL SPACE	NO LIMIT	125	355	NO LIMIT	860	1950
STAIRS THAT SERVE MEZZANINES NOT EXCEEDING 20 m <sup>2</sup> WITHIN LIVE/WORK UNITS	NO LIMIT	125	355	NO LIMIT	WIDTH AS PER DIV B 9.8.2.1.(3)	2050
<b>NOTE:</b> THE CURVED EDGES OF TREADS SHALL NOT REDUCE THE REQUIRED TREAD DEPTH BY MORE THAN 15mm AND SHALL NOT EXCEED 25mm HORIZONTALLY.						

STRUCTURAL ALTERATIONS

ALL STRUCTURAL ALTERATIONS MUST BE FIELD REVIEWED BY A PROFESSIONAL ENGINEER IF REQUIRED BY THE BUILDING INSPECTOR

FINISHED SITE GRADING

THE BUILDING SHALL BE LOCATED AND THE BUILDING SITE GRADED SO THAT WATER WILL NOT ACCUMULATE AT OR NEAR THE BUILDING AND WILL NOT ADVERSELY AFFECT ANY ADJACENT PROPERTIES.

A CURSORY REVIEW OF THE STRUCTURAL ELEMENTS HAS BEEN COMPLETED AND IS RELIANT ON ENGINEER'S CERTIFICATION OF DRAWINGS.

9.5.2.3. STUD WALL REINFORCEMENT

- (1) IF WOOD WALL STUDS OR SHEET STEEL WALL STUDS ENCLOSE THE MAIN BATHROOM IN A DWELLING UNIT, REINFORCEMENT SHALL BE INSTALLED TO PERMIT THE FUTURE INSTALLATION OF A GRAB BAR ON A WALL ADJACENT TO,
- (a) A WATER CLOSET IN THE LOCATION REQUIRED BY CLAUSE 3.8.3.8.(1)(d), AND
  - (b) A SHOWER OR BATHTUB IN THE LOCATION BY CLAUSE 3.8.3.13.(1)(f).

(SEE APPENDIX A.)

## Strip Footings

For Singles and Semi-Detached Houses up to 2 storeys

For 8" or 10" foundation walls with 2x8 / 2x10 floor joists  
20" wide x 6" thick concrete strip footings below foundation walls.  
24" wide x 8" thick concrete strip footing

Foundation walls with engineered joist:

24" wide x 8" thick concrete strip footings below party walls.

### Footings on engineered fill

24" wide x 8" thick concrete strip footings with reinforcing below exterior walls.  
30" wide x 8" thick concrete strip footings with reinforcing below party walls.  
(refer to the footings details on engineered fill)

Assume the larger footing size when two conditions apply.

Assumed 120 kPa (18 psi) soil bearing capacity or 90 kPa engineered soil fill. Bearing capacity to be verified on site.

## Concrete Pad Footing Sizes

120 kPa Native Soil 90 kPa Engineered Fill

F1 = 42" x 42" x 18" F1 = 48" x 48" x 20"

F2 = 36" x 36" x 16" F2 = 40" x 40" x 16"

F3 = 30" x 30" x 12" F3 = 34" x 34" x 14"

F4 = 24" x 24" x 12" F4 = 28" x 28" x 12"

F5 = 16" x 16" x 8" F5 = 18" x 18" x 8"

Refer to the floor plans for non-standard footing sizes.

## Brick Veneer Cuts

When the brick veneer cut is greater than 26" a 10" thick poured concrete foundation wall is required.

## Exterior Concrete Slabs

All garage slabs, porch slabs, poured concrete stairs and exposed concrete flat work to be 32 MPa with 5-8% air entrainment.

## Ceramic Tile over Joists

Space conventional floor joists @ 12" o/c below all ceramic tile areas. Provide 1 row of bridging for spans of 5'-7" and 2 rows for spans greater than 7'-0".

## Engineered Roof Trusses

Refer to the roof truss shop drawings for all roof framing information.

## Engineered Floor Joists

Refer to the floor framing shop drawings for engineered framing layouts, hardware and details.

## Steel Column Notes

C1 = 4" x 4" x 1/4" HSS w/ 10" x 8" x 1/2" base plate and 2 - 3/4" dia. anchor bolts.  
C2 = 5" x 5" x 1/4" HSS w/ 12" x 12" x 1/2" base plate and 4 - 3/4" dia. anchor bolts.

Use 4 bolts for moment connection.

"M" = Moment connection at beam and column = 35 kN-m

## Grading

Plans and elevations are not drawn to accurate grade elevations. Refer to final grading plan.

## Door Schedule

No.	Width	Ceiling Heights 8' to 9' 10' or more	Type
1	2'-10" (34")	6'-8" 8'-0"	Insulated entrance door
1A	2'-8" (32")	6'-8" 8'-0"	Insulated entrance door
2	2'-8" (32")	6'-8" 8'-0"	Wood and glass door
3	2'-8" (32")	6'-8" 8'-0"	Exterior slab door
4	2'-8" (32")	6'-8" 8'-0"	Interior slab door
5	2'-6" (30")	6'-8" 8'-0"	Interior slab door
6	2'-2" (26")	6'-8" 8'-0"	Interior slab door
7	1'-6" (18")	6'-8" 8'-0"	Interior slab door

## Garage Wall - 2x4 Stud Design


Studs	Spacing	Maximum Height
2x4	16" o/c	8'-0 (2.44m)
2x4	12" o/c	8'-10" (2.69m)
2-2x4	16" o/c	10'-1" (3.07m)
2-2x4	12" o/c	10'-9" (3.28m)
3-2x4	16" o/c	11'-2" (3.40m)
3-2x4	12" o/c	12'-4" (3.76m)

### Notes

- For roof design snow loads of 2.6kPa
- Supported roof truss length of 6.0m
- Supported floor joist length of 2.5m
- Studs exceeding 3.0m in height shall be installed per OBC 9.23.10.1.(2)

## Two Storey Height Wall Details - max. 18'-0" tall


2 - 2 x 6 stud wall nailed together and spaced at 12" o/c full height c/w solid blocking @ 48" o/c vertical and 3/4" OSB exterior wall sheathing.

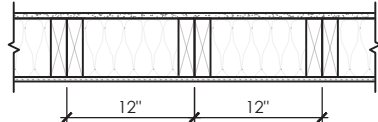

Note: maximum height of wall for this detail is 18'-0" and maximum length is 40'-0".

## Two Storey Height Wall Detail - max. 20'-2" tall


2 - 1 1/2" x 5 1/2" Laminated strand lumber (LSL) 1.5E stud wall glued and nailed together and spaced at 10" o/c full height c/w solid blocking @ 8'-0" o/c vertical and 3/4" OSB exterior wall sheathing.

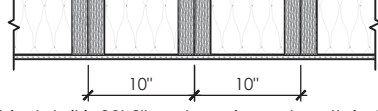

Note: maximum height of wall for this detail is 20'-2" and maximum length is 40'-0".

## Two Storey Height Wall Detail - max. 21'-5" tall

2 - 1 1/2" x 5 1/2" Laminated strand lumber (LSL) 1.5E stud wall glued and nailed together and spaced at 9" o/c full height c/w solid blocking @ 8'-0" o/c vertical and 3/4" OSB exterior wall sheathing.

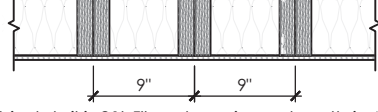

Note: maximum height of wall for this detail is 21'-5" and maximum length is 40'-0".

## Steel Angles and Wood Beam Schedules

### Brick Veneer Steel Lintels + Wood Lintels and Beams

Label	Steel Angle Size (v x h x t)	Wood Size (members + w + h)
WL1	= 3 1/2" x 3 1/2" x 1/4" (89 x 89 x 6.4) [2]	+ 2 - 2 x 8 (2 - 38 x 184) S.P.F. No. 2
WL2	= 4" x 3 1/2" x 3/8" (102 x 89 x 7.9) [?] +	2 - 2 x 8 (2 - 38 x 184) S.P.F. No. 2
WL3	= 5" x 3 1/2" x 3/8" (127 x 89 x 7.9) [4] +	2 - 2 x 10 (2 - 38 x 235) S.P.F. No. 2
WL4	= 6" x 3 1/2" x 3/8" (152 x 89 x 9.5) [?] +	2 - 2 x 12 (2 - 38 x 286) S.P.F. No. 2
WL5	= 6" x 4" x 3/8" (152 x 102 x 9.5) [?] +	2 - 2 x 12 (2 - 38 x 286) S.P.F. No. 2
WL6	= 5" x 3 1/2" x 3/8" (127 x 89 x 7.9) [4] +	2 - 2 x 12 (2 - 38 x 286) S.P.F. No. 2
WL7	= 5" x 3 1/2" x 3/8" (127 x 89 x 7.9) [4] +	3 - 2 x 10 (3 - 38 x 235) S.P.F. No. 2
WL8	= 5" x 3 1/2" x 3/8" (127 x 89 x 7.9) [4] +	3 - 2 x 12 (3 - 38 x 286) S.P.F. No. 2
WL9	= 6" x 4" x 3/8" (152 x 102 x 9.5) [?] +	3 - 2 x 12 (3 - 38 x 286) S.P.F. No. 2

### Wood Lintels and Beams

Label	Beam Size (members + w + h)
WB1	= 2 - 2 x 8 (2 - 38 x 184) S.P.F. No. 2
WB2	= 3 - 2 x 8 (3 - 38 x 184) S.P.F. No. 2
WB3	= 2 - 2 x 10 (2 - 38 x 235) S.P.F. No. 2
WB4	= 3 - 2 x 10 (3 - 38 x 235) S.P.F. No. 2
WB5	= 2 - 2 x 12 (2 - 38 x 286) S.P.F. No. 2
WB6	= 3 - 2 x 12 (3 - 38 x 286) S.P.F. No. 2
WB7	= 5 - 2 x 12 (5 - 38 x 286) S.P.F. No. 2
WB11	= 4 - 2 x 10 (4 - 38 x 235) S.P.F. No. 2
WB12	= 4 - 2 x 12 (4 - 38 x 286) S.P.F. No. 2

### Laminated Veneer Lumber (LVL) Beams

Label	Beam Size (members + w + h)
LVL1A	= 1 - 1 3/4" x 7 1/2" (1 - 45 x 184)
LVL1	= 2 - 1 3/4" x 7 1/2" (2 - 45 x 184)
LVL2	= 3 - 1 3/4" x 7 1/2" (3 - 45 x 184)
LVL3	= 4 - 1 3/4" x 7 1/2" (4 - 45 x 184)
LVL4A	= 1 - 1 3/4" x 9 1/2" (1 - 45 x 240)
LVL4	= 2 - 1 3/4" x 9 1/2" (2 - 45 x 240)
LVL5	= 3 - 1 3/4" x 9 1/2" (3 - 45 x 240)
LVL5A	= 4 - 1 3/4" x 9 1/2" (4 - 45 x 240)
LVL6A	= 1 - 1 3/4" x 11 7/8" (1 - 45 x 300)
LVL6	= 2 - 1 3/4" x 11 7/8" (2 - 45 x 300)
LVL7	= 3 - 1 3/4" x 11 7/8" (3 - 45 x 300)
LVL7A	= 4 - 1 3/4" x 11 7/8" (4 - 45 x 300)
LVL8	= 2 - 1 3/4" x 14" (2 - 45 x 356)
LVL9	= 3 - 1 3/4" x 14" (3 - 45 x 356)
LVL9A	= 2 - 1 3/4" x 16" (2 - 45 x 406)
LVL9B	= 3 - 1 3/4" x 16" (3 - 45 x 406)
LVL10	= 2 - 1 3/4" x 18" (2 - 45 x 456)

### Loose Steel Lintels

Label	Steel Size (v x h x t)
L1	= 3 1/2" x 3 1/2" x 1/4" (89 x 89 x 6.4) [2]
L2	= 4" x 3 1/2" x 3/8" (102 x 89 x 7.9) [?]
L3	= 5" x 3 1/2" x 3/8" (127 x 89 x 7.9) [4]
L4	= 6" x 3 1/2" x 3/8" (152 x 89 x 9.5) [?]
L5	= 6" x 4" x 3/8" (152 x 102 x 9.5) [?]
L6	= 7" x 4" x 3/8" (178 x 102 x 9.5) [?]

### Glue-Laminated Floor Beams

Label	Beam Size (w x h)
GLU1	= 3 1/8" x 11 7/8" (80 x 300)
GLU2	= 5 1/8" x 11 7/8" (130 x 300)

## Minimum Thermal Performance

The minimum thermal performance of building envelope and equipment shall conform to the following.

### Prescriptive Package A1

Space Heating Fuel Gas

Component	R Max. Nominal	Max. U	R Min. Effective
Ceiling with Attic Space	60	0.017	59.22
Ceiling without Attic Space	31	0.036	27.65
Exposed Floor	31	0.034	29.80
Walls Above Grade	22	0.059	17.03
Basement Walls	20 ci	0.047	21.12

Below Grade Slab Entire Surface  
> 600 mm Below Grade

Heated Slab or Slab  
<= 600 mm Below Grade

Edge of Below Grade Slab  
<= 600 mm Below Grade

Windows and Sliding Glass Doors Energy rating: 25 Max. U: 0.28  
Skylights Max. U: 0.49  
Space Heating Equipment Min. AFAU: 96%  
HRV Min. SRE: 75%  
Domestic Water Heater Min. EF: 0.80

## Area Calculations

### Rose 2-1

Ground Floor	1317 sq ft, 122.35 sq m
Second Floor	1688 sq ft, 156.82 sq m
Total floor area	3005 sq ft, 279.17 sq m

Total open to below	0 sq ft, 0.00 sq m
Finished basement	0 sq ft, 0.00 sq m
Total gross floor area	3005 sq ft, 279.17 sq m

Coverage Areas	
Ground floor	1317 sq ft, 122.35 sq m
Garage	397 sq ft, 36.88 sq m
Porch	58 sq ft, 5.39 sq m
Other structures	0 sq ft, 0.00 sq m
Coverage w/o porch	1714 sq ft, 159.24 sq m
Coverage w/ porch	1772 sq ft, 164.62 sq m

## Area Calculations

### Rose 2-2

Ground Floor	1317 sq ft, 122.35 sq m
Second Floor	1682 sq ft, 156.26 sq m
Total floor area	2999 sq ft, 278.62 sq m

Total open to below	0 sq ft, 0.00 sq m
Finished basement	0 sq ft, 0.00 sq m
Total gross floor area	2999 sq ft, 278.62 sq m

Coverage Areas	
Ground floor	1317 sq ft, 122.35 sq m
Garage	397 sq ft, 36.88 sq m
Porch	58 sq ft, 5.39 sq m
Other structures	0 sq ft, 0.00 sq m
Coverage w/o porch	1714 sq ft, 159.24 sq m
Coverage w/ porch	1772 sq ft, 164.62 sq m

## Area Calculations

### Rose 2-3

Ground Floor	1317 sq ft, 122.35 sq m
Second Floor	1681 sq ft, 156.17 sq m
Total floor area	2998 sq ft, 278.52 sq m

Total open to below	0 sq ft, 0.00 sq m
Finished basement	0 sq ft, 0.00 sq m
Total gross floor area	2998 sq ft, 278.52 sq m

Coverage Areas	
Ground floor	1317 sq ft, 122.35 sq m
Garage	397 sq ft, 36.88 sq m
Porch	59 sq ft, 5.48 sq m
Other structures	0 sq ft, 0.00 sq m
Coverage w/o porch	1714 sq ft, 159.24 sq m
Coverage w/ porch	1773 sq ft, 164.72 sq m

## SB-12 Calculations

### Rose 2-1

Elevation	Wall Area	Window Area	Percentage
Front	714.5 sq ft (66.4 sq m)	98.1 sq ft (9.1 sq m)	13.72%
Left side	1097.2 sq ft (101.9 sq m)	65.4 sq ft (6.1 sq m)	5.96%
Right side	1101.6 sq ft (102.3 sq m)	0.0 sq ft (0.0 sq m)	0.00%
Rear	704.9 sq ft (65.5 sq m)	88.0 sq ft (8.2 sq m)	12.48%
Total	3618.2 sq ft (336.1 sq m)	251.5 sq ft (23.4 sq m)	6.95%

## SB-12 Calculations

### Rose 2-2

Elevation	Wall Area	Window Area	Percentage
Front	714.5 sq ft (66.4 sq m)	107.4 sq ft (10.0 sq m)	15.03%
Left side	1097.2 sq ft (101.9 sq m)	65.4 sq ft (6.1 sq m)	5.96%
Right side	1101.6 sq ft (102.3 sq m)	0.0 sq ft (0.0 sq m)	0.00%
Rear	704.9 sq ft (65.5 sq m)	88.0 sq ft (8.2 sq m)	12.48%
Total	3618.2 sq ft (336.1 sq m)	260.8 sq ft (24.2 sq m)	7.21%

## SB-12 Calculations

### Rose 2-3

Elevation	Wall Area	Window Area	Percentage
Front	704.9 sq ft (65.5 sq m)	107.3 sq ft (10.0 sq m)	15.23%
Left side	1097.2 sq ft (101.9 sq m)	65.4 sq ft (6.1 sq m)	5.96%
Right side	1097.2 sq ft (101.9 sq m)	0.0 sq ft (0.0 sq m)	0.00%
Rear	704.9 sq ft (65.5 sq m)	88.0 sq ft (8.2 sq m)	12.48%
Total	3604.2 sq ft (334.8 sq m)	260.7 sq ft (24.2 sq m)	7.23%

# Rose 2

Compliance Package A1

### Revisions

#	Description	Date	By
1.	Issued for client review	2023-04-28	JM
2.	Issued for p. eng. review	2023-06-19	JM
3.	Issued for permit	2023-06-30	JM

Contractor shall check all dimensions and elevations before commencing with work and report any discrepancies to the Designer. Prints are not to be scaled.

The undersigned has reviewed and takes responsibility for this design, as well as having the qualifications and requirements mandated by the Ontario Building Code (O.B.C.) to be a Designer.

### Qualification Information

Jamie Mack	35923	Signature
Name	BCIN	
Registration Information	Mackitecture	103532



www.mackitecture.ca

975A Elgin Street West, Suite 353  
Cobourg, ON K9A 5J3

Tel: 416-735-8190 Email: info@mackitecture.ca

## General Notes and Charts

### Elevation 1


scale	by	area	sheet no.
	JM	-	0
date	type	project no.	
2023-06-30	40' Single	22-012	



www.greenparkgroup.ca

project name  
Zadorra Estates Inc.

MHP 23028

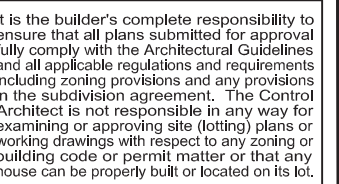

**JOHN G. WILLIAMS LTD., ARCHITECT**  
**ARCHITECTURAL CONTROL REVIEW**  
**AND APPROVAL**

APPROVED BY: \_\_\_\_\_

DATE: 11/31/2023

This stamp certifies compliance with the applicable Design Guidelines only and bears no further professional responsibility.

STRUDET INC.



## Rose 2

### Compliance Package A1

### Qualification Information

BCIN

## Mackitecture

975A Elgin Street West, Suite 353

Cobourg, ON K9A 5J3  
Tel: 416-735-8190 Email: [info@mackitector.ca](mailto:info@mackitector.ca)

### Basement Floor Plan Elevation 1

1-1

project no.	22-012
-------------	--------

**www.greenparkgroup.ca**

**Zadorra Estates Inc.**

Drawing created with MacKitecture v.1.0.0 (build 2654). File P:\2022\22-012-GREENPARK-ZADORRA-OSHAWA\UNITS\WORKING\22-012-ROSE 2-WD-V1.DWG plotted on 2023-06-30 at 12:53:13 PM by JMACK

MHP 23028

This is to certify that these plans comply with the applicable Architectural Design Guidelines approved by the City of OSHAWA.

Architectural floor plan of a basement. The plan shows various rooms and structural details. Key areas include:

- Unexcavated Area:** A large central area labeled "Unexcavated" with the instruction "Remove top soil only". It contains a "Low headroom" section and a "Recess the foundation for the sunken mudroom floor, refer to approved siting." note.
- Unfinished Basement:** A section on the left side of the plan.
- Cold Storage:** A room on the right side of the plan.
- Rooms and Features:**
  - Furnace:** Located in the upper left area.
  - Headroom:** A section in the upper middle area.
  - Rough-in bath:** A bathroom area in the lower left.
  - Full height at cold cellar:** A section in the lower right.
- Structural Details:**
  - Rebar:** 2-20M rebar in the top of the foundation wall for lateral support at the sunken floor. Extend bars 24" beyond opening each side.
  - Blocking:** Provide solid blocking @ 24" o.c. where floor joists are parallel to foundation wall (typ.).
  - Floor Joists:** 11 7/8" eng. floor joists.
  - Foundation Wall:** 42"x72"x18" conc. pad footing.
  - Windows:** 30" x 16" structural steel frame basement window (typ.).
  - Electrical:** Proposed electrical breaker panel location.
  - Vents:** Vent with screen.
  - Parsons:** Parsons precast steps above.
- Dimensions:** The plan includes numerous dimensions for walls, openings, and overall room sizes. For example, the overall width is 58'-8" and the overall depth is 33'-10".
- Professional Seal:** The plan is signed by John G. Williams, Architect, with a professional seal. The seal includes the text "JOHN G. WILLIAMS LTD., ARCHITECT", "ARCHITECTURAL CONTROL REVIEW AND APPROVAL", "APPROVED BY:", "DATE: JUL 31, 2023", and "This stamp certifies compliance with the applicable Design Guidelines only and bears no further professional responsibility."

STRUDET INC.

REGISTERED PROFESSIONAL ENGINEER  
B. MARINKOVIC  
PROVINCE OF ONTARIO  
FOR STRUCTURE ONLY

July 6, 2023

# Rose 2

## Compliance Package A1

**Zadorra Estates Inc.**

Drawing created with Mackitecture v.1.0.0 (build 2654). File P:\2022\22-012-GREENPARK-ZADORRA-OSHAWA\UNITS\WORKING\22-012-ROSE 2-WD-V1.DWG plotted on 2023-06-30 at 12:53:14 PM by JMACK

MHP 23028

This is to certify that these plans comply with the applicable Architectural Design Guidelines approved by the City of OSHAWA.

APPROVED BY: \_\_\_\_\_  
DATE: JUL 31, 2023

This stamp certifies compliance with the applicable  
Design Guidelines only and bears no further  
professional responsibility.



FOR STRUCTURE ONLY

## Rose 2

### Compliance Package A1

The undersigned has reviewed and takes responsibility for this design, as well as having the qualifications and requirements mandated by the Ontario Building Code (O.B.C.) to be a Designer.

### Qualification Information

Mackitecture

•



**www.mackitecture.ca**  
975A Elgin Street West, Suite 353  
Cobourg, ON K9A 5J3  
Tel: 416-735-8190 Email: info@mackitecture.com

### Basement Floor Plan Elevation 3

sheet no.
-----------

project no.	22-012
-------------	--------

1-3

[www.greenparkgroup.ca](http://www.greenparkgroup.ca)

project name
--------------

**Zadorra Estates Inc.**

Contractor shall check all dimensions and elevations before commencing with work and report any discrepancies to the Designer. Prints are not to be scaled.


Drawing created with Mackitecture v.1.0.0 (build 2654). File P:\2022\22-012-GREENPARK-ZADORRA-OSHAWA\UNITS\WORKING\22-012-ROSE 2-WD-V1.DWG plotted on 2023-06-30 at 12:53:15 PM by JMACK

CORPORATION OF THE CITY OF OSHAWA  
TRUE COPY  
OF PERMIT PLANS  
Nov 15 2023  
PER: *Charr*  
CHIEF BUILDING OFFICIAL

MHP 23028



45 minute fire rated wall assembly

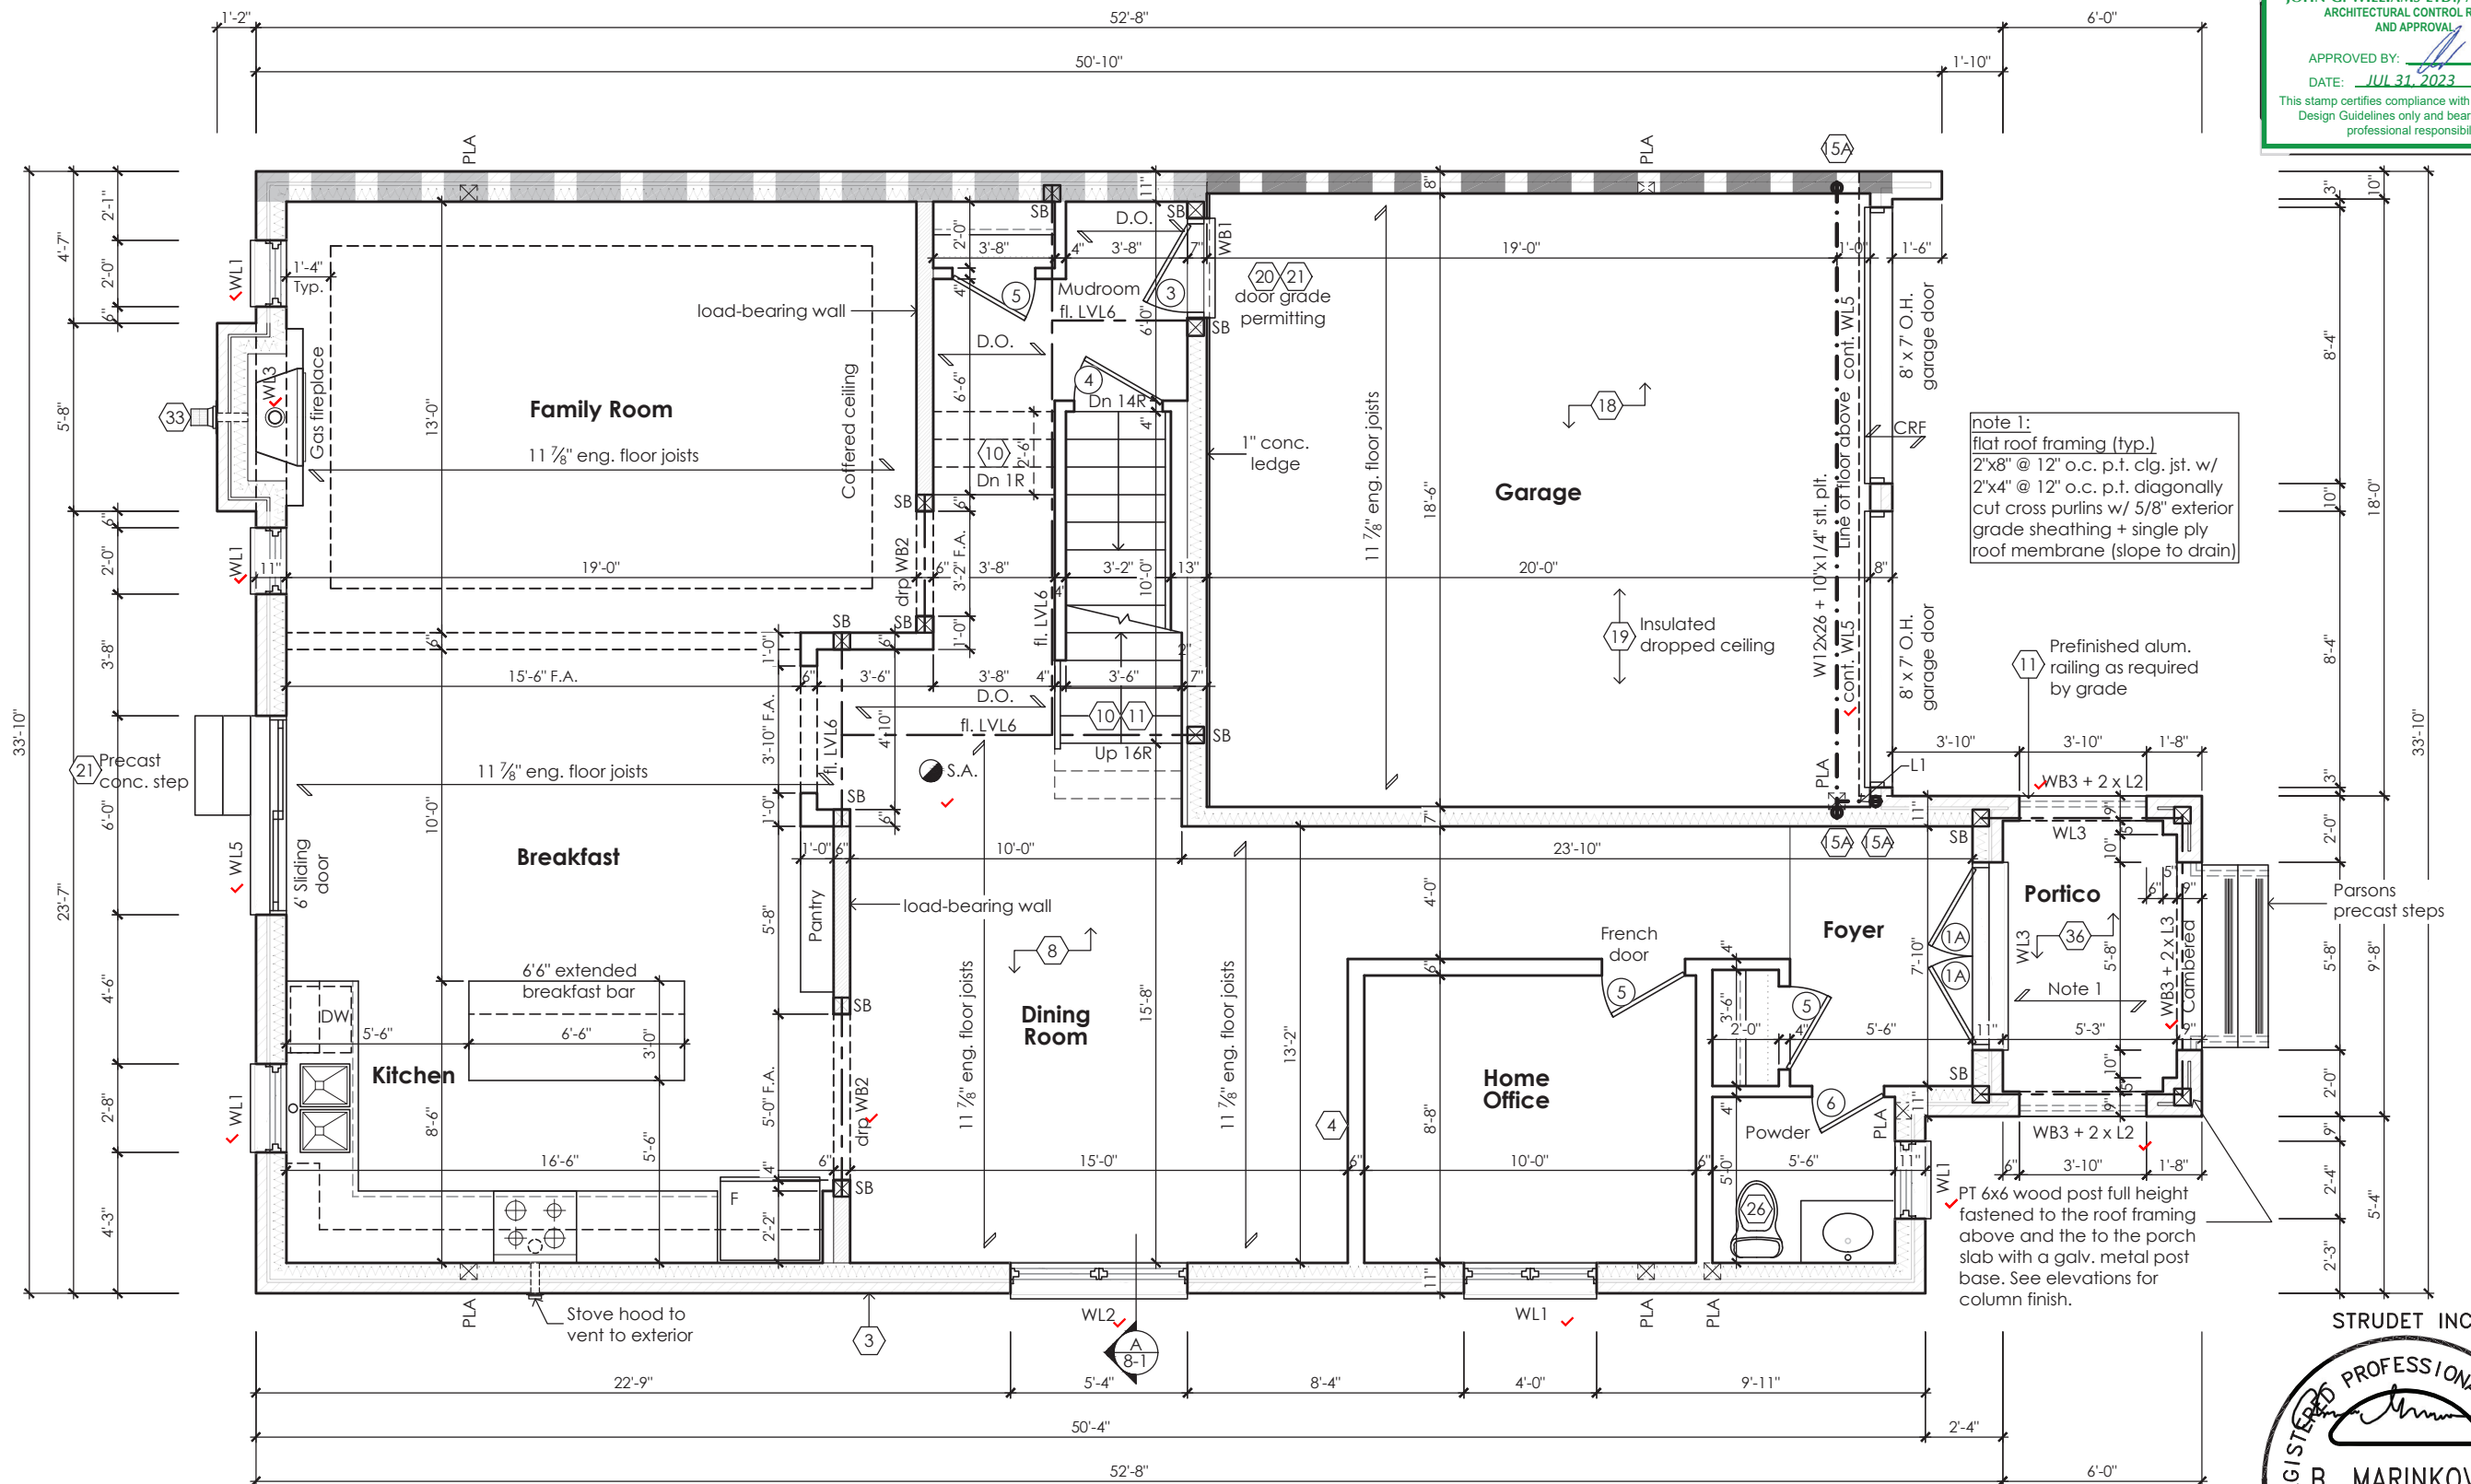

Ground Floor Plan '1'

It is the builder's complete responsibility to ensure that all plans submitted for approval fully comply with the Architectural Guidelines and all applicable regulations and requirements including zoning provisions and any provisions in the subdivision agreement. The Control Architect is not responsible in any way for examining or approving site (lotting) plans or working drawings with respect to any zoning or building code or permit matter or that any house can be properly built or located on its lot.

This is to certify that these plans comply with the applicable Architectural Design Guidelines approved by the City of OSHAWA.

JOHN G. WILLIAMS LTD., ARCHITECT  
ARCHITECTURAL CONTROL REVIEW  
AND APPROVAL  
APPROVED BY: *[Signature]*  
DATE: JUL 31, 2023  
This stamp certifies compliance with the applicable Design Guidelines only and bears no further professional responsibility.

STRUDET INC.



FOR STRUCTURE ONLY

Rose 2

Compliance Package A1

Contractor shall check all dimensions and elevations before commencing with work and report any discrepancies to the Designer. Prints are not to be scaled.

The undersigned has reviewed and takes responsibility for this design, as well as having the qualifications and requirements mandated by the Ontario Building Code (O.B.C.) to be a Designer.  
**Qualification Information**  
Jamie Mack 35923  
Name BCIN  
Registration Information **Mackitecture** 103532

**Mackitecture**  
www.mackitecture.ca  
975A Elgin Street West, Suite 353  
Cobourg, ON K9A 5J3  
Tel: 416-735-8190 Email: info@mackitecture.ca


Ground Floor Plan Elevation 1			
scale 3/16" = 1'-0"	by JM	area 3005 sq ft	sheet no. 2-1
date 2023-06-30	type 40' Single	project no. 22-012	

**Greenpark**  
www.greenparkgroup.ca  
project name  
**Zadorra Estates Inc.**

CORPORATION OF THE CITY OF OSHAWA  
TRUE COPY  
OF PERMIT PLANS  
Nov 15 2023  
PER:   
CHIEF BUILDING OFFICIAL

MHP 23028

45 minute fire rated wall assembly

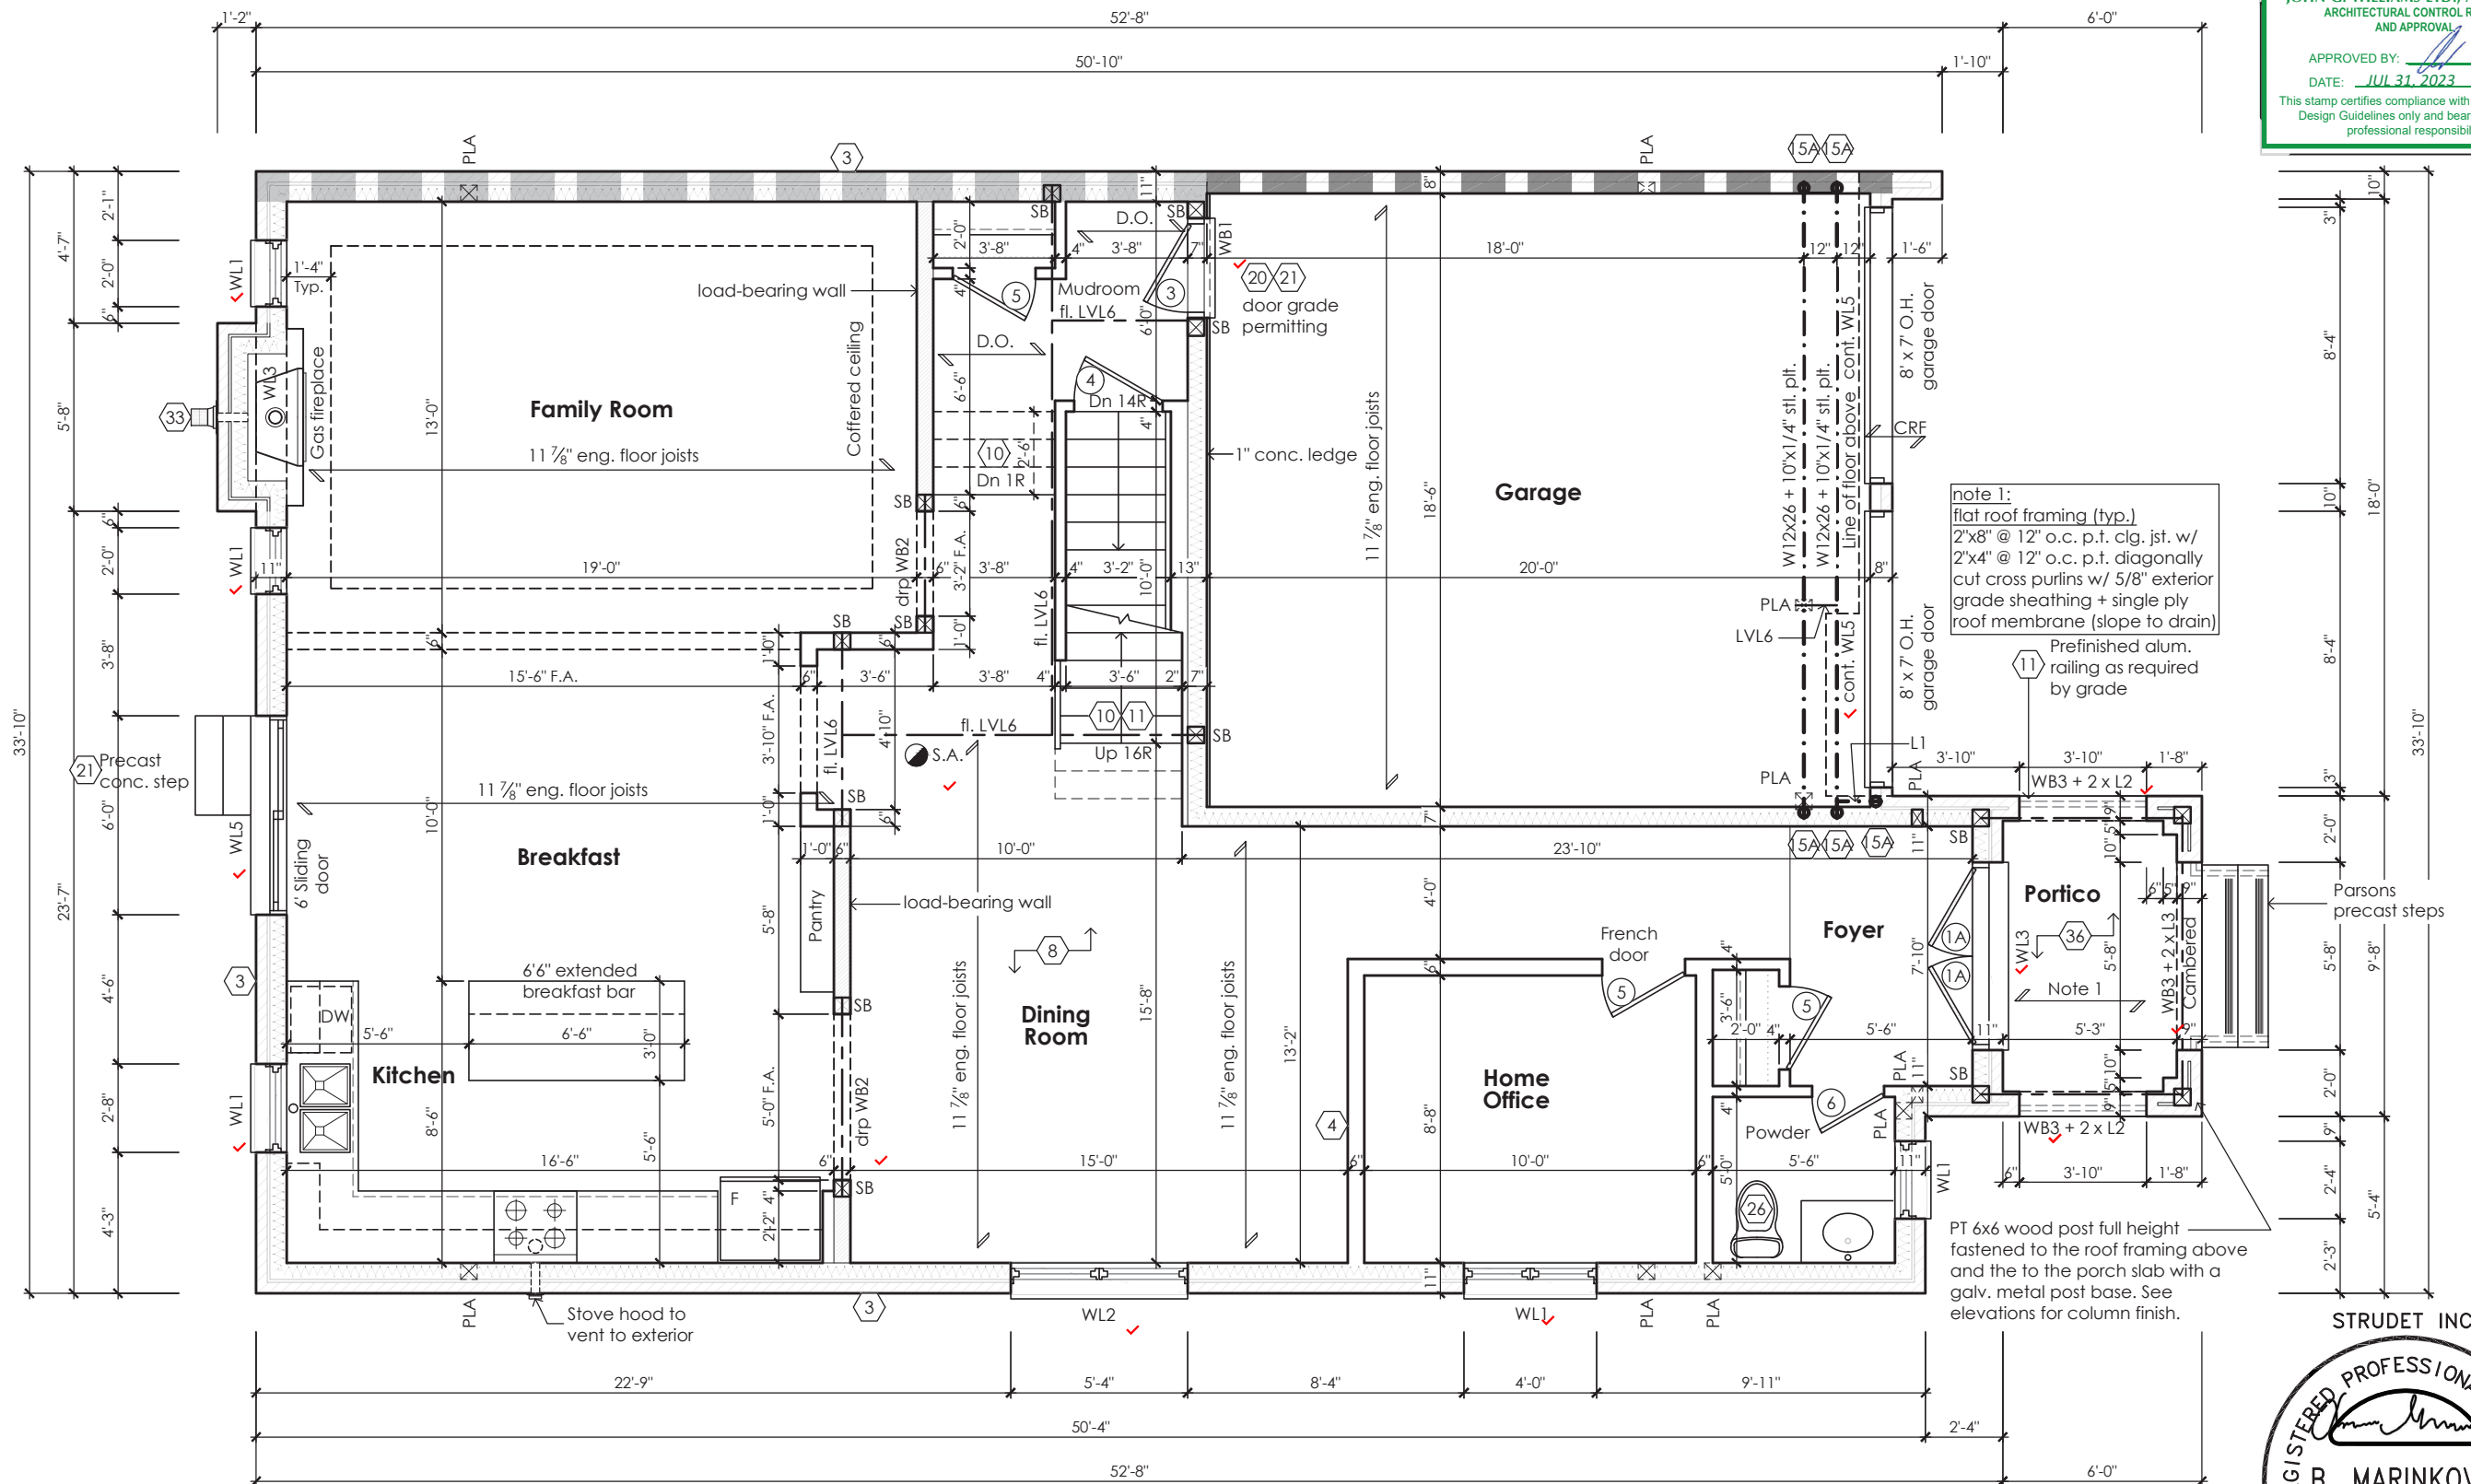

Ground Floor Plan '2'

It is the builder's complete responsibility to ensure that all plans submitted for approval fully comply with the Architectural Guidelines and all applicable regulations and requirements, including zoning provisions and any provisions in the subdivision agreement. The Control Architect is not responsible in any way for examining or approving site (lotting) plans or working drawings with respect to any zoning or building code or permit matter or that any house can be properly built or located on its lot.

This is to certify that these plans comply with the applicable Architectural Design Guidelines approved by the City of OSHAWA.

JOHN G. WILLIAMS LTD., ARCHITECT  
ARCHITECTURAL CONTROL REVIEW  
AND APPROVAL  
APPROVED BY:   
DATE: JUL 31, 2023  
This stamp certifies compliance with the applicable Design Guidelines only and bears no further professional responsibility.

STRUDET INC.



FOR STRUCTURE ONLY

Rose 2  
Compliance Package A1

Contractor shall check all dimensions and elevations before commencing with work and report any discrepancies to the Designer. Prints are not to be scaled.

The undersigned has reviewed and takes responsibility for this design, as well as having the qualifications and requirements mandated by the Ontario Building Code (O.B.C.) to be a Designer.  
**Qualification Information**  
Jamie Mack 35923  
Name BCIN  
Registration Information Mackitecture 103532

  
**www.mackitecture.ca**  
975A Elgin Street West, Suite 353  
Cobourg, ON K9A 5J3  
Tel: 416-735-8190 Email: info@mackitecture.ca

Ground Floor Plan  
Elevation 2  
scale 3/16" = 1'-0"  
by JM  
area 2303 sq ft  
date 2023-06-30  
type 40' Single  
project no. 22-012  
sheet no. 2-2

  
**www.greenparkgroup.ca**  
project name Zadorra Estates Inc.

MHP 23028

This is to certify that these plans comply with the applicable Architectural Design Guidelines approved by the City of OSHAWA.

[illegible]

STRUDET INC.



## Rose 2

### Compliance Package A1

### Qualification Information

## Mackitecture

Cobourg, ON K9A 5J3  
Tel: 416-735-8190 Email: [info@mackitecture.ca](mailto:info@mackitecture.ca)

**2-3**

**Zadorra Estates Inc.**


Drawing created with MacKilature v.1.0.0 (build 2654). File P:\2022\22-012-GREENPARK-ZADORRA-OSHAWA\UNITS\WORKING\22-012-ROSE 2-WD-V1.DWG plotted on 2023-06-30 at 12:53:18 PM by JMAG

CORPORATION OF THE CITY OF OSHAWA  
TRUE COPY  
OF PERMIT PLANS  
Nov 15 2023  
PER: *C. Morris*  
CHIEF BUILDING OFFICIAL

MHP 23028



45 minute fire rated wall assembly

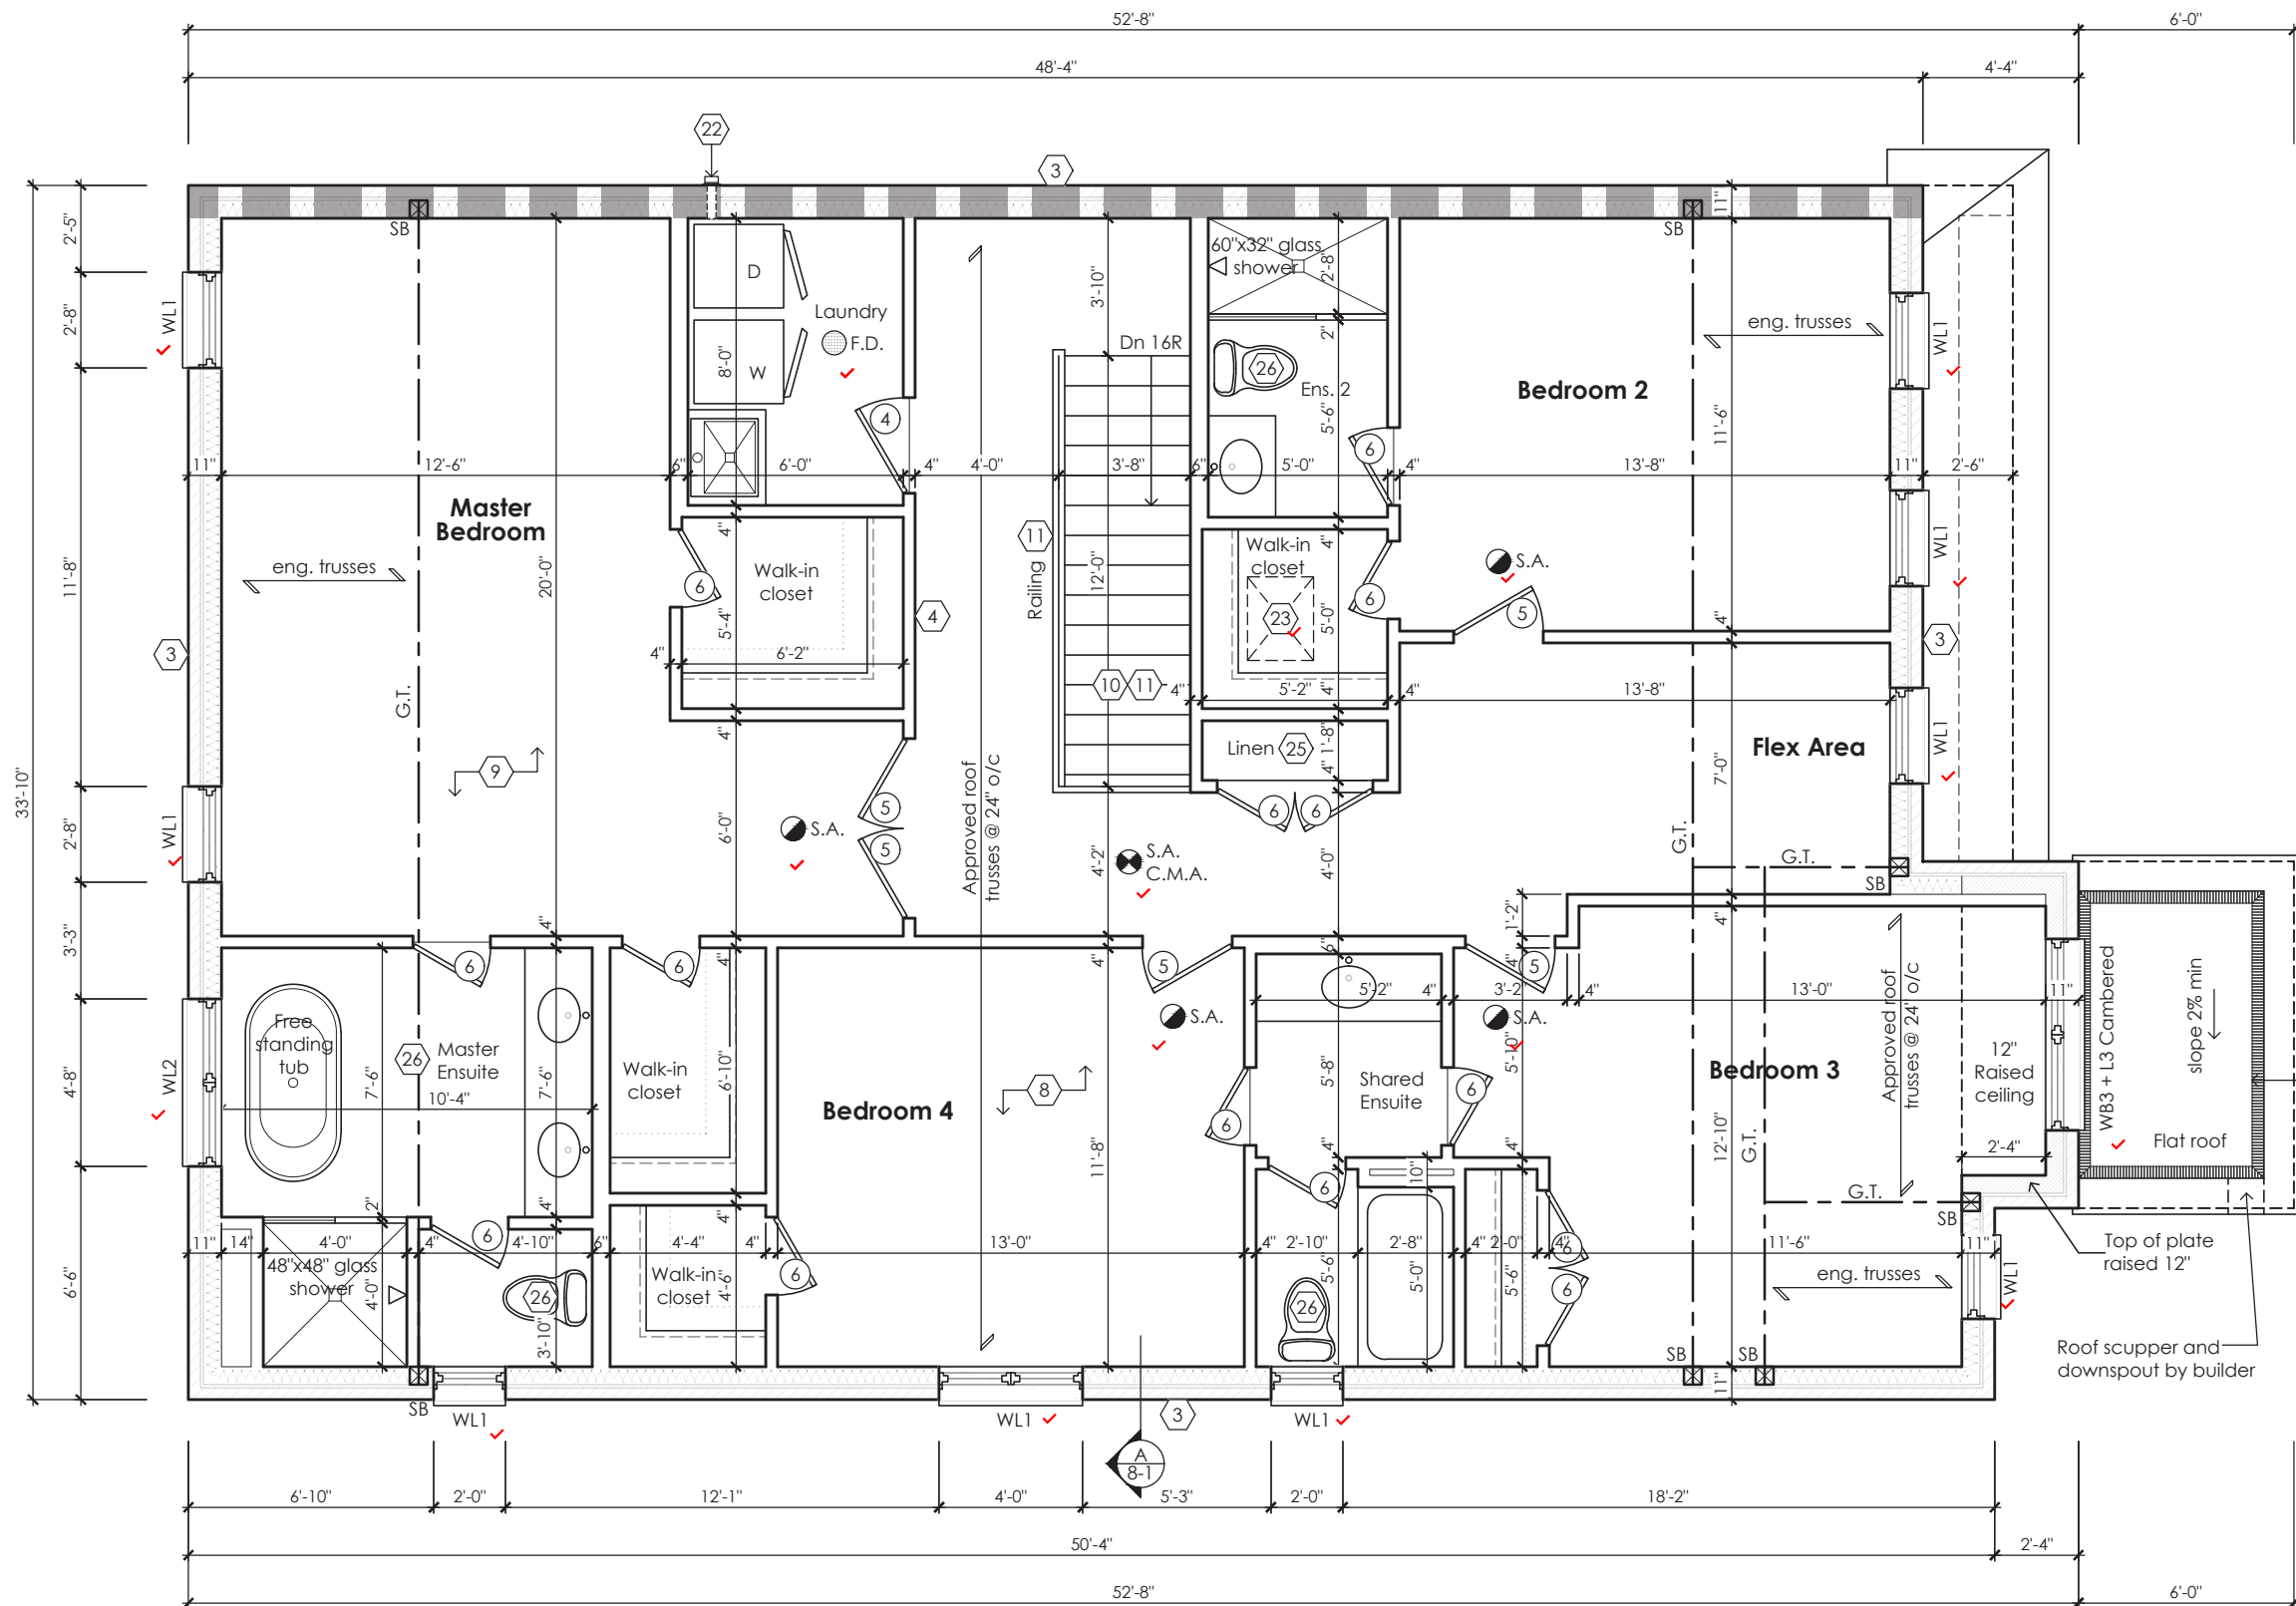


Second Floor Plan '1'

It is the builder's complete responsibility to ensure that all plans submitted for approval fully comply with the Architectural Guidelines and all applicable regulations and requirements, including zoning provisions and any provisions in the subdivision agreement. The Control Architect is not responsible in any way for examining or approving site (lotting) plans or working drawings with respect to any zoning or building code or permit matter or that any house can be properly built or located on its lot.

This is to certify that these plans comply with the applicable Architectural Design Guidelines approved by the City of OSHAWA.

JOHN G. WILLIAMS LTD., ARCHITECT  
ARCHITECTURAL CONTROL REVIEW  
AND APPROVAL  
APPROVED BY: *[Signature]*  
DATE: JUL 31, 2023  
This stamp certifies compliance with the applicable Design Guidelines only and bears no further professional responsibility.

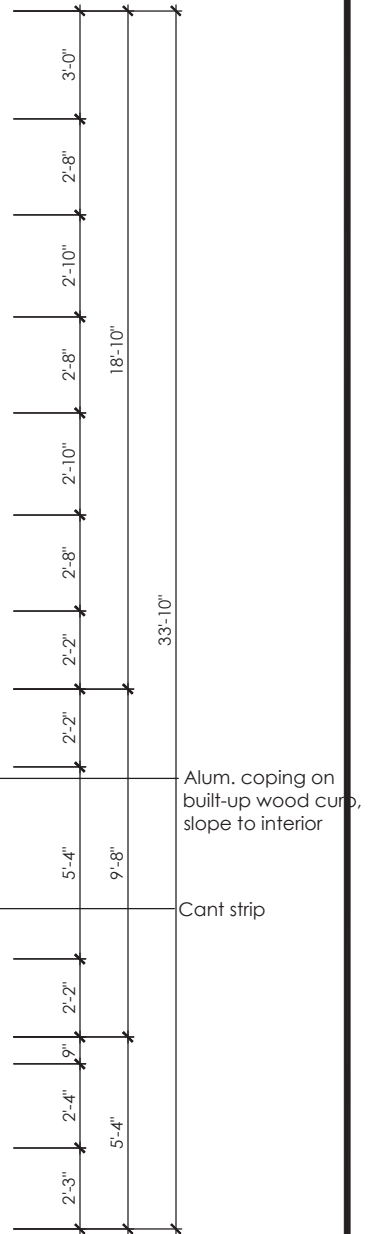

STRUDET INC.



FOR STRUCTURE ONLY

Rose 2  
Compliance Package A1

Contractor shall check all dimensions and elevations before commencing with work and report any discrepancies to the Designer. Prints are not to be scaled.

The undersigned has reviewed and takes responsibility for this design, as well as having the qualifications and requirements mandated by the Ontario Building Code (O.B.C.) to be a Designer.  
**Qualification Information**  
Jamie Mack 35923  
Name BCIN  
Registration Information **Mackitecture** 103532  
*[Signature]*

**M**  
**www.mackitecture.ca**  
975A Elgin Street West, Suite 353  
Cobourg, ON K9A 5J3  
Tel: 416-735-8190 Email: info@mackitecture.ca

Second Floor Plan Elevation 1			
scale <b>3/16" = 1'-0"</b>	by <b>JM</b>	area <b>3005 sq ft</b>	sheet no. <b>3-1</b>
date <b>2023-06-30</b>	type <b>40' Single</b>	project no. <b>22-012</b>	

**Greenpark**  
**www.greenparkgroup.ca**  
project name  
**Zadorra Estates Inc.**


CORPORATION OF THE CITY OF OSHAWA  
TRUE COPY  
OF PERMIT PLANS  
Nov 15 2023  
PER: *C. Morris*  
CHIEF BUILDING OFFICIAL

MHP 23028

It is the builder's complete responsibility to ensure that all plans submitted for approval fully comply with the Architectural Guidelines and all applicable regulations and requirements, including zoning provisions and any provisions in the subdivision agreement. The Control Architect is not responsible in any way for examining or approving site (lotting) plans or working drawings with respect to any zoning or building code or permit matter or that any house can be properly built or located on its lot.

This is to certify that these plans comply with the applicable Architectural Design Guidelines approved by the City of OSHAWA.

JOHN G. WILLIAMS LTD., ARCHITECT  
ARCHITECTURAL CONTROL REVIEW  
AND APPROVAL  
APPROVED BY: *[Signature]*  
DATE: JUL 31, 2023  
This stamp certifies compliance with the applicable Design Guidelines only and bears no further professional responsibility.

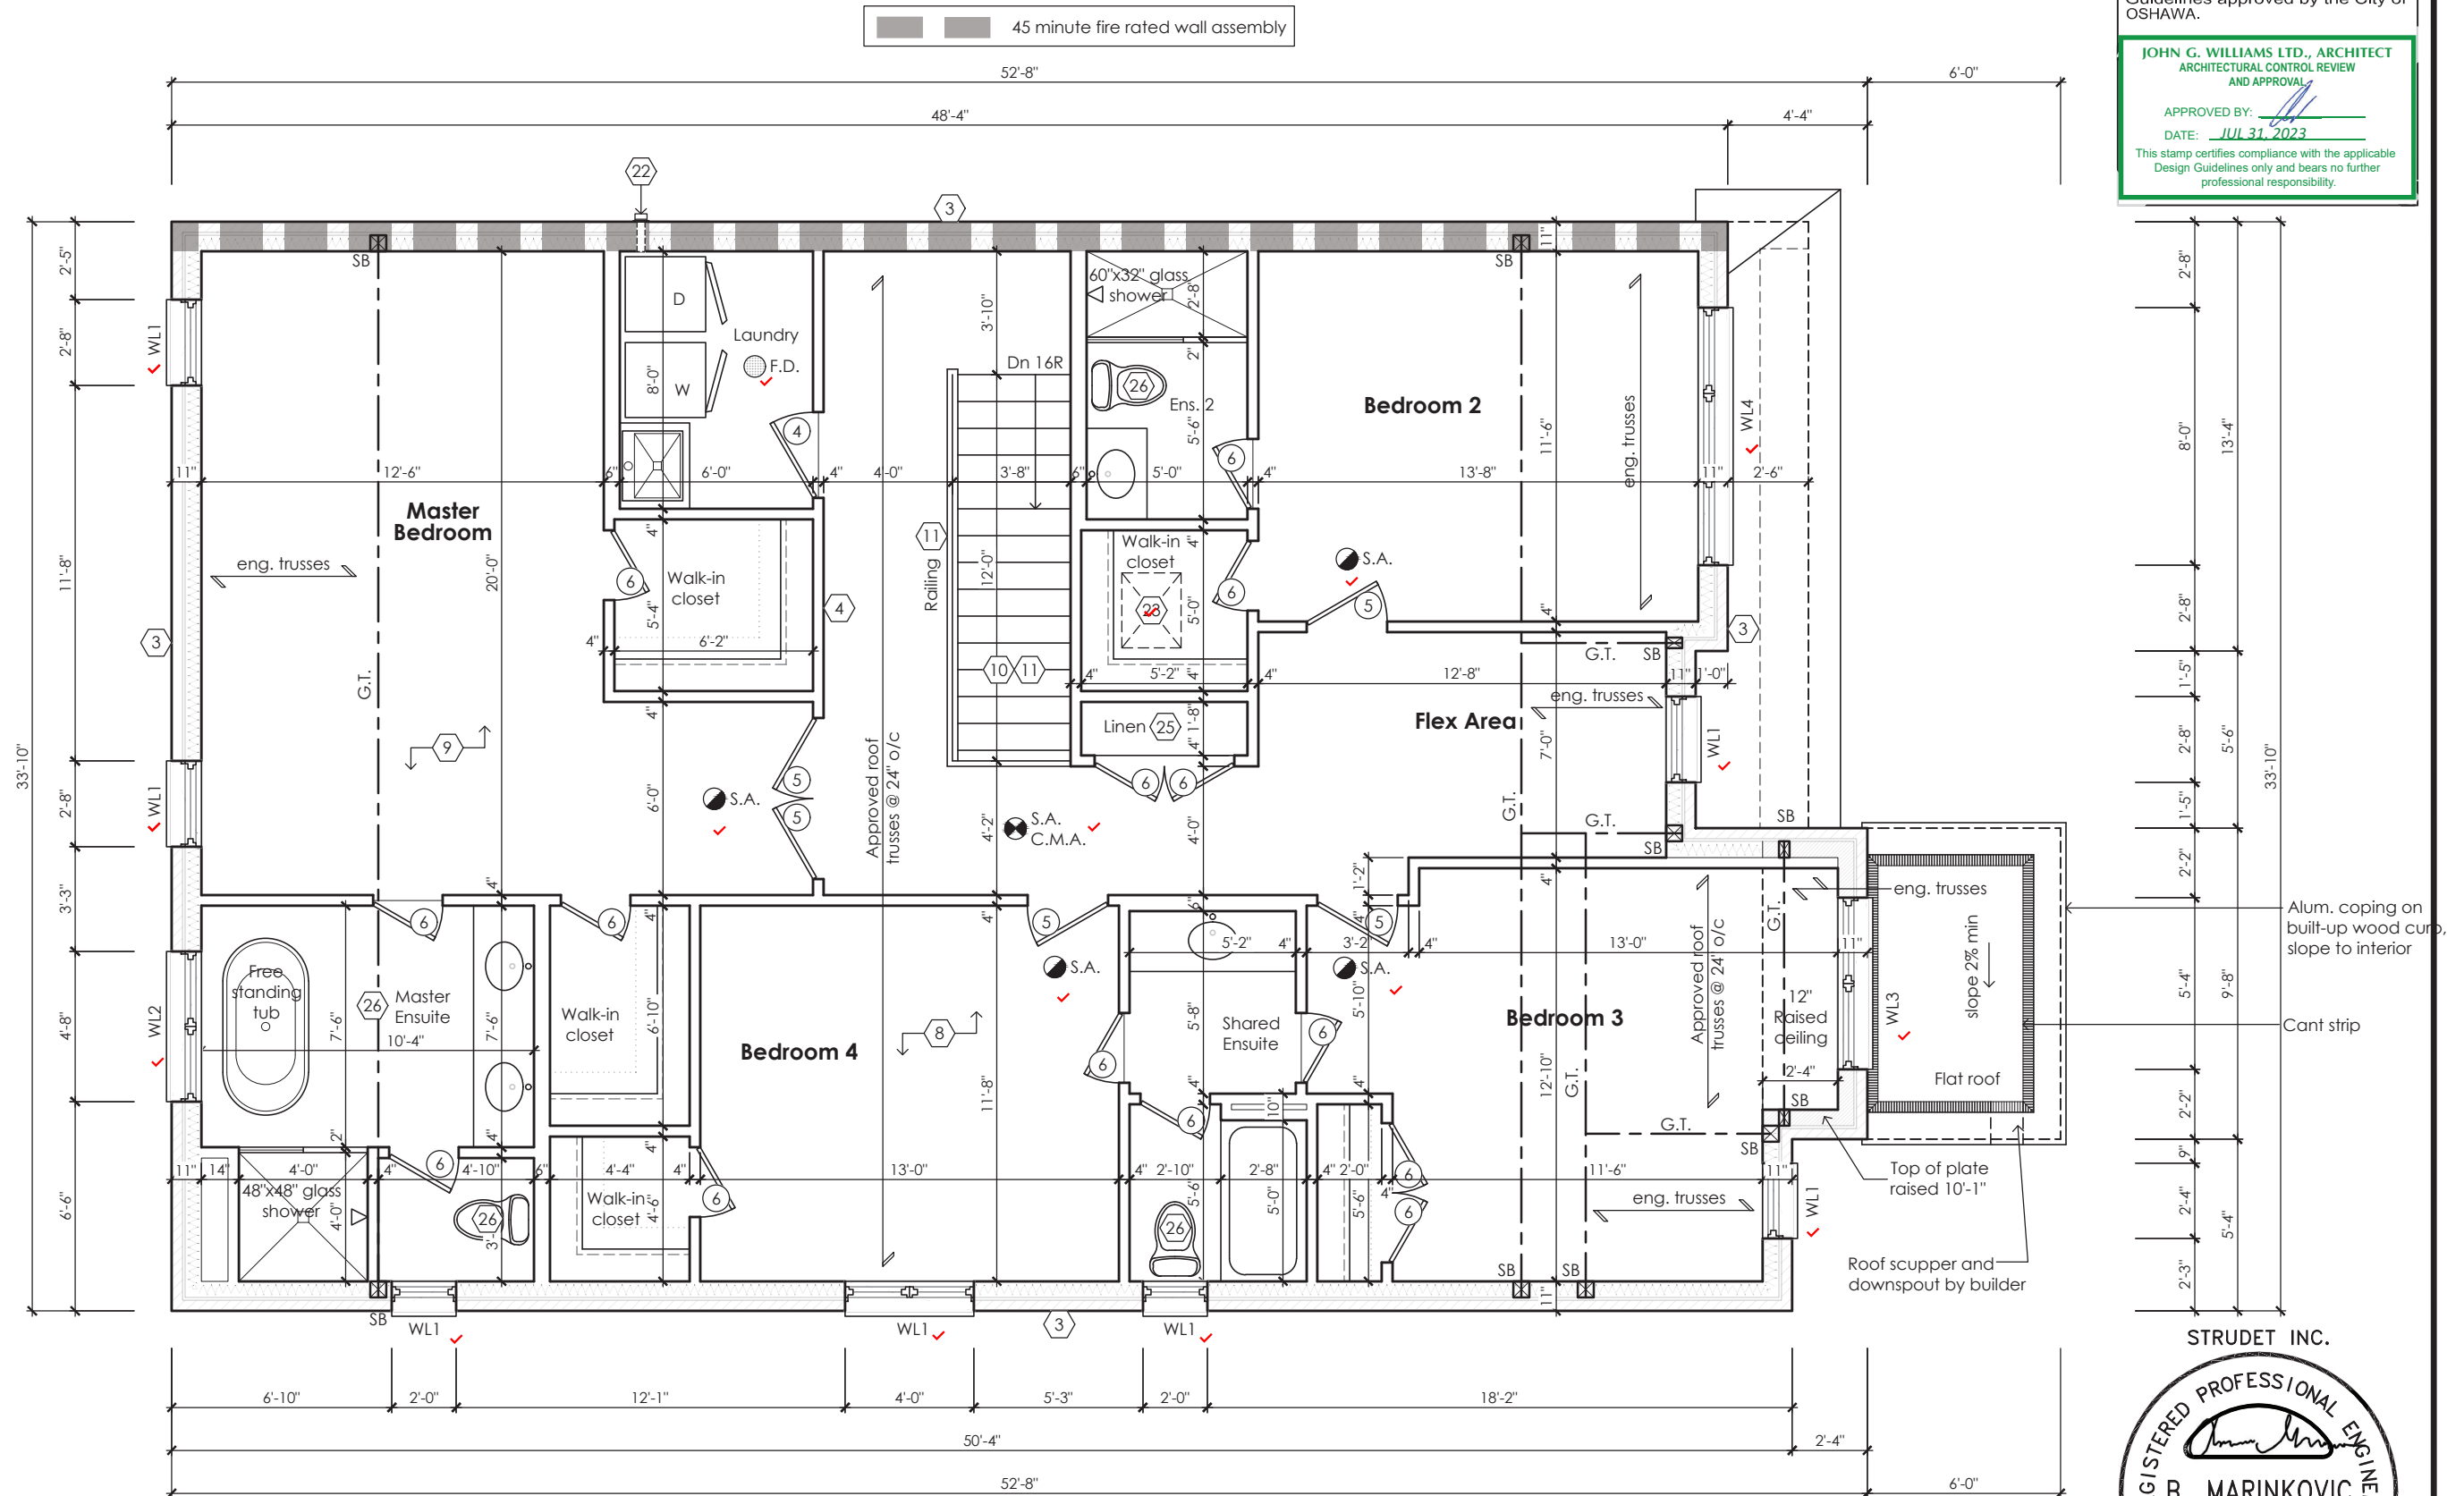

STRUDET INC.



FOR STRUCTURE ONLY

Rose 2  
Compliance Package A1

Contractor shall check all dimensions and elevations before commencing with work and report any discrepancies to the Designer. Prints are not to be scaled.

The undersigned has reviewed and takes responsibility for this design, as well as having the qualifications and requirements mandated by the Ontario Building Code (O.B.C.) to be a Designer.

**Qualification Information**

Jamie Mack 35923  
Name BCIN  
Registration Information **Mackitecture** 103532

*[Signature]*

**Mackitecture**  
www.mackitecture.ca  
975A Elgin Street West, Suite 353  
Cobourg, ON K9A 5J3  
Tel: 416-735-8190 Email: info@mackitecture.ca

Second Floor Plan  
Elevation 2

scale	3/16" = 1'-0"	by	JM	area	2999 sq ft	sheet no.	3-2
date	2023-06-30	type	40' Single	project no.	22-012		


**Greenpark**  
www.greenparkgroup.ca

project name  
**Zadorra Estates Inc.**

CORPORATION OF THE CITY OF OSHAWA  
TRUE COPY  
OF PERMIT PLANS  
Nov 15 2023  
PER: *C. Morris*  
CHIEF BUILDING OFFICIAL

MHP 23028

45 minute fire rated wall assembly

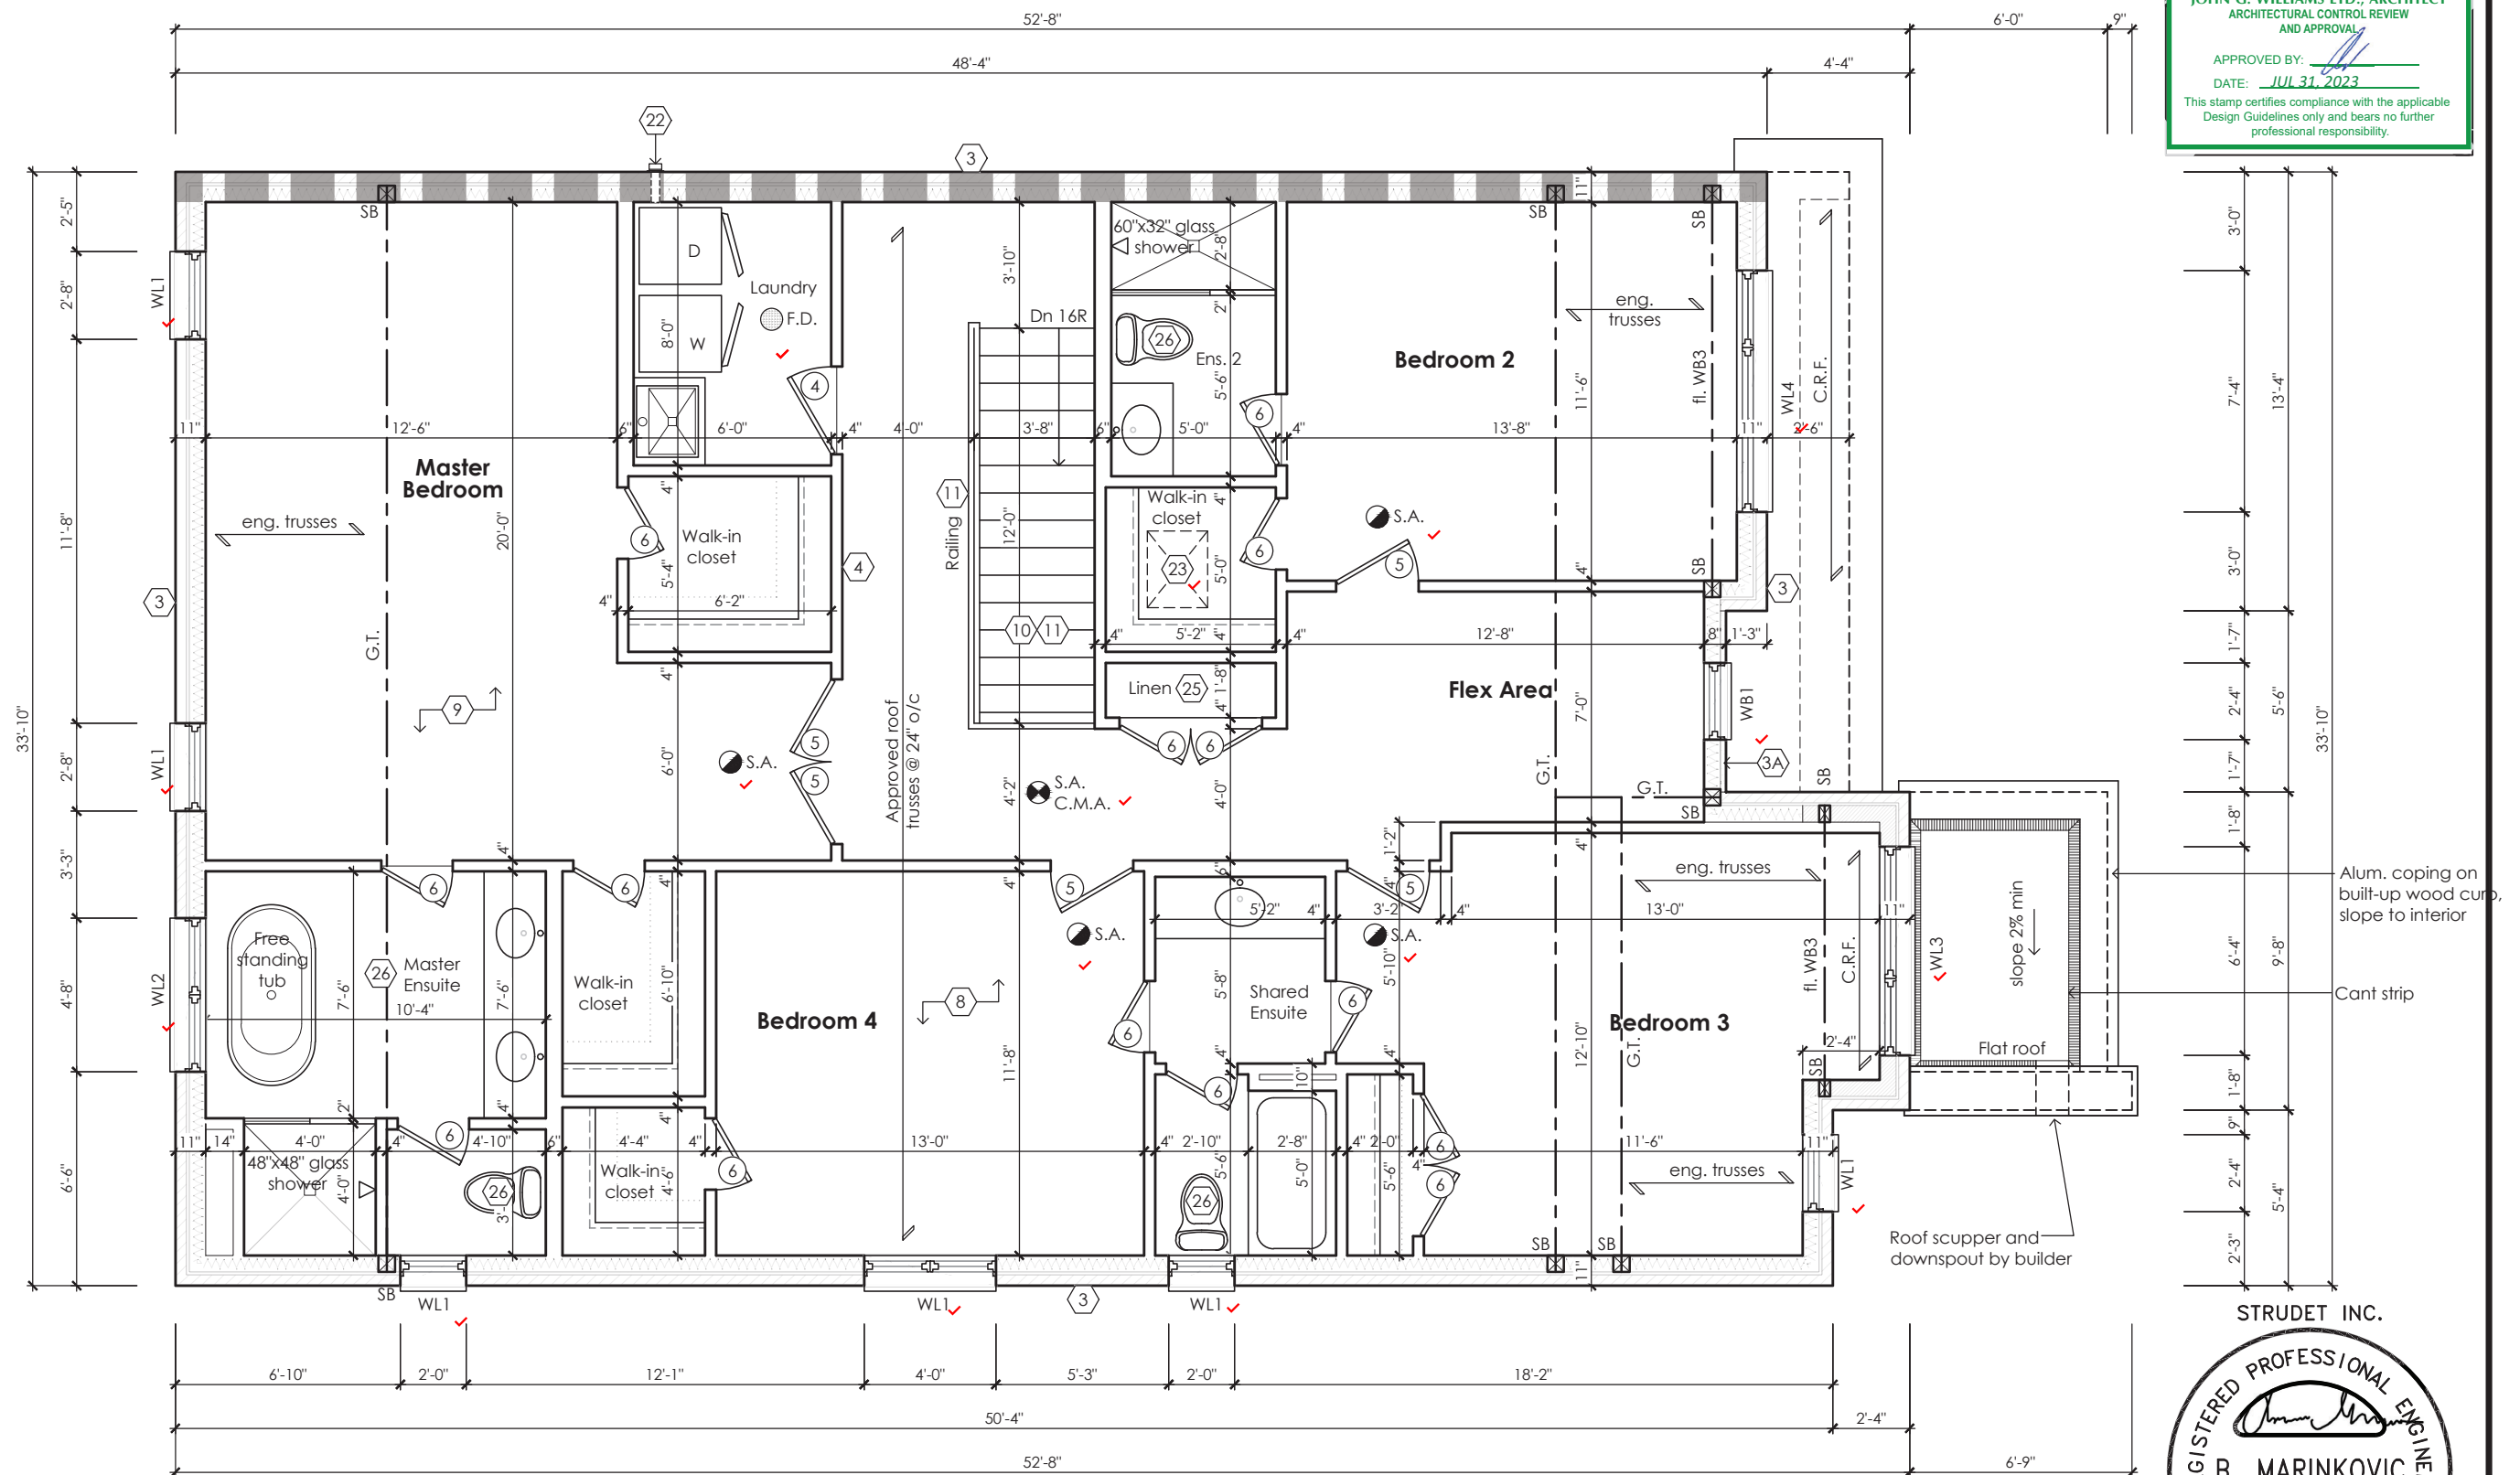


Second Floor Plan '3'

It is the builder's complete responsibility to ensure that all plans submitted for approval fully comply with the Architectural Guidelines and all applicable regulations and requirements including zoning provisions and any provisions in the subdivision agreement. The Control Architect is not responsible in any way for examining or approving site (lotting) plans or working drawings with respect to any zoning or building code or permit matter or that any house can be properly built or located on its lot.

This is to certify that these plans comply with the applicable Architectural Design Guidelines approved by the City of OSHAWA.

JOHN G. WILLIAMS LTD., ARCHITECT  
ARCHITECTURAL CONTROL REVIEW  
AND APPROVAL  
APPROVED BY: *[Signature]*  
DATE: JUL 31, 2023  
This stamp certifies compliance with the applicable Design Guidelines only and bears no further professional responsibility.

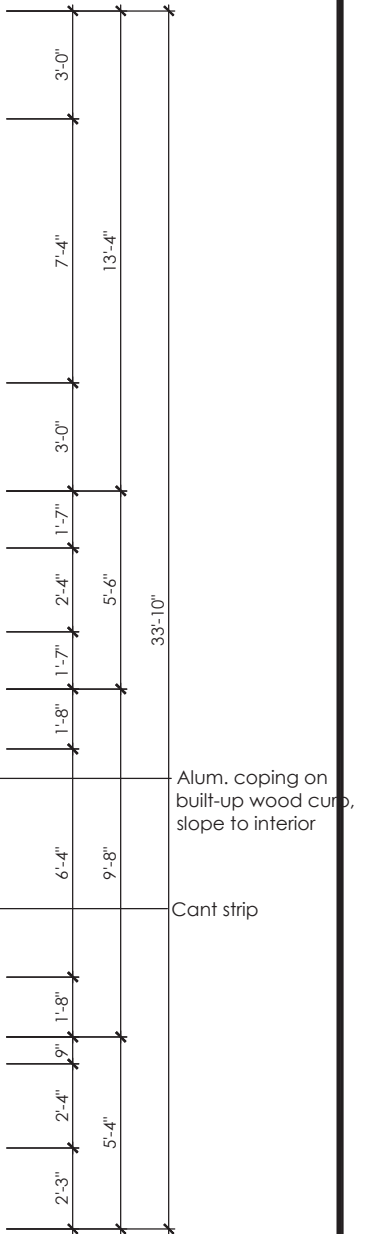

STRUDET INC.



FOR STRUCTURE ONLY

Rose 2  
Compliance Package A1

Contractor shall check all dimensions and elevations before commencing with work and report any discrepancies to the Designer. Prints are not to be scaled.

The undersigned has reviewed and takes responsibility for this design, as well as having the qualifications and requirements mandated by the Ontario Building Code (O.B.C.) to be a Designer.  
**Qualification Information**  
Jamie Mack 35923  
Name BCIN  
Registration Information **Mackitecture** 103532  
*[Signature]*




**Mackitecture**  
www.mackitecture.ca  
975A Elgin Street West, Suite 353  
Cobourg, ON K9A 5J3  
Tel: 416-735-8190 Email: info@mackitecture.ca

**Second Floor Plan  
Elevation 3**  
scale 3/16" = 1'-0"  
by JM  
area 2998 sq ft  
sheet no. 3-3  
date 2023-06-30  
type 40' Single  
project no. 22-012

**Greenpark**  
www.greenparkgroup.ca  
project name **Zadorra Estates Inc.**

CORPORATION OF THE CITY OF OSHAWA  
TRUE COPY  
OF PERMIT PLANS  
Nov 15 2023  
PER: *Charr*  
CHIEF BUILDING OFFICIAL

MHP 23028

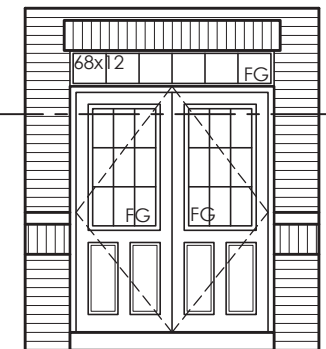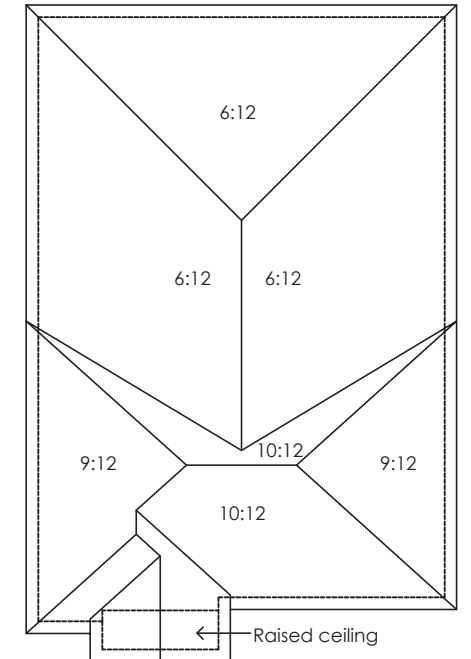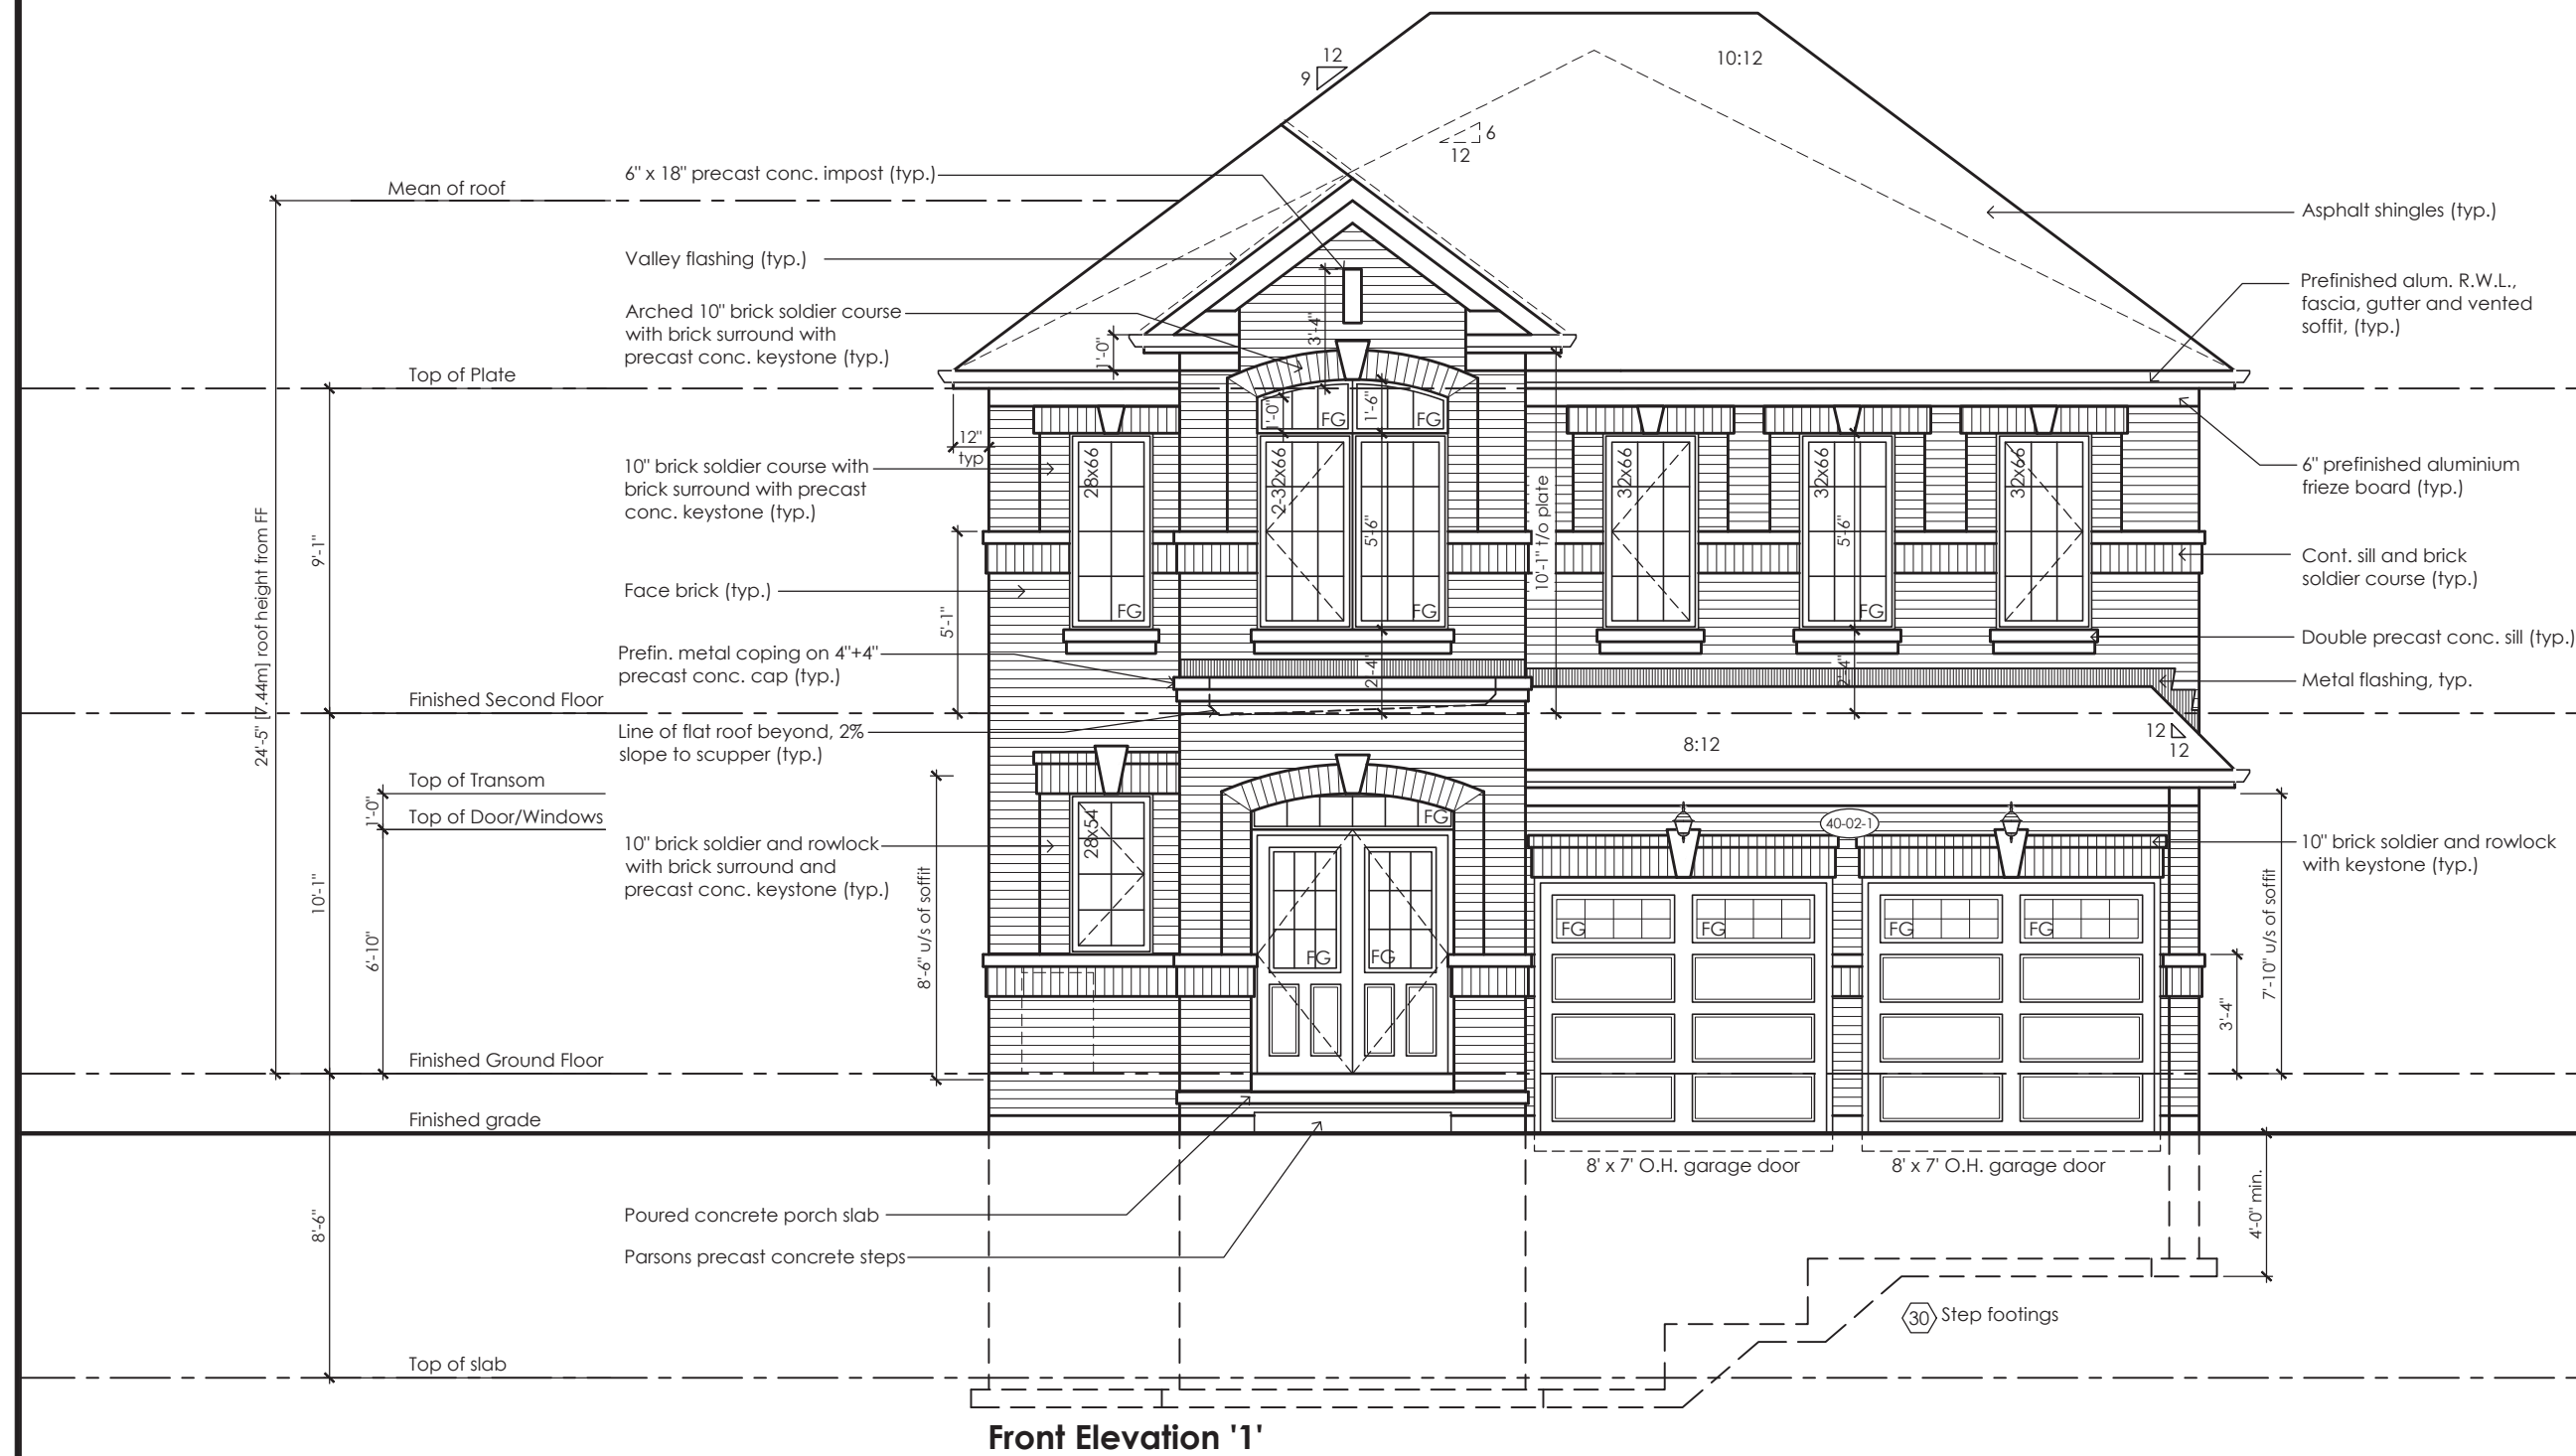

Inside Portico Elev. '1'

It is the builder's complete responsibility to ensure that all plans submitted for approval fully comply with the Architectural Guidelines and all applicable regulations and requirements including zoning provisions and any provisions in the subdivision agreement. The Control Architect is not responsible in any way for examining or approving site (lotting) plans or working drawings with respect to any zoning or building code or permit matter or that any house can be properly built or located on its lot.

This is to certify that these plans comply with the applicable Architectural Design Guidelines approved by the City of Oshawa

JOHN G. WILLIAMS LTD., ARCHITECT  
ARCHITECTURAL CONTROL REVIEW  
AND APPROVAL  
APPROVED BY: *[Signature]*  
DATE: JUL 31, 2023  
This stamp certifies compliance with the applicable Design Guidelines only and bears no further professional responsibility.

Rose 2

Compliance Package A1

	<p>The undersigned has reviewed and takes responsibility for this design, as well as having the qualifications and requirements mandated by the Ontario Building Code (O.B.C.) to be a Designer.</p> <p><b>Qualification Information</b></p> <table><tr><td>Jamie Mack</td><td>35923</td><td></td></tr><tr><td>Name</td><td>BCIN</td><td>Signature</td></tr><tr><td>Registration Information</td><td><b>Mackitecture</b></td><td>103532</td></tr></table>	Jamie Mack	35923		Name	BCIN	Signature	Registration Information	<b>Mackitecture</b>	103532	 <p><b>www.mackitecture.ca</b> 975A Elgin Street West, Suite 353 Cobourg, ON K9A 5J3 Tel: 416-735-8190 Email: info@mackitecture.ca</p>	<table><tr><td colspan="4">title</td></tr><tr><td colspan="4">Front Elevation Elevation 1</td></tr><tr><td>scale</td><td>by</td><td>area</td><td rowspan="2">sheet no.  <b>4-1</b></td></tr><tr><td><b>3/16" = 1'-0"</b></td><td><b>JM</b></td><td><b>3005 sq ft</b></td></tr><tr><td>date</td><td>type</td><td>project no.</td><td></td></tr><tr><td><b>2023-06-30</b></td><td><b>40' Single</b></td><td><b>22-012</b></td><td></td></tr></table>	title				Front Elevation Elevation 1				scale	by	area	sheet no.  <b>4-1</b>	<b>3/16" = 1'-0"</b>	<b>JM</b>	<b>3005 sq ft</b>	date	type	project no.		<b>2023-06-30</b>	<b>40' Single</b>	<b>22-012</b>		 <p><b>www.greenparkgroup.ca</b></p> <p>project name <b>Zadorra Estates Inc.</b></p>
Jamie Mack	35923																																			
Name	BCIN	Signature																																		
Registration Information	<b>Mackitecture</b>	103532																																		
title																																				
Front Elevation Elevation 1																																				
scale	by	area	sheet no.  <b>4-1</b>																																	
<b>3/16" = 1'-0"</b>	<b>JM</b>	<b>3005 sq ft</b>																																		
date	type	project no.																																		
<b>2023-06-30</b>	<b>40' Single</b>	<b>22-012</b>																																		
<p>Contractor shall check all dimensions and elevations before commencing with work and report any discrepancies to the Designer. Prints are not to be scaled.</p>																																				

MHP 23028



This is to certify that these plans comply with the applicable Architectural Design Guidelines approved by the City of Oshawa

This stamp certifies compliance with the applicable  
Design Guidelines only and bears no further  
professional responsibility.

## Rose 2

**Compliance Package A1**



project name
--------------


Zadorra Estates Inc.

	project no.	22-012
--	-------------	--------


Drawing created with Mackitecture v.1.0.0 (build 2654). File P:\2022\22-012-GREENPARK-ZADORRA-OSHAWA\UNITS\WORKING\22-012-ROSE 2-WD-V1.DWG plotted on 2023-06-30 at 12:53:24 PM by JMACK



MHP 23028

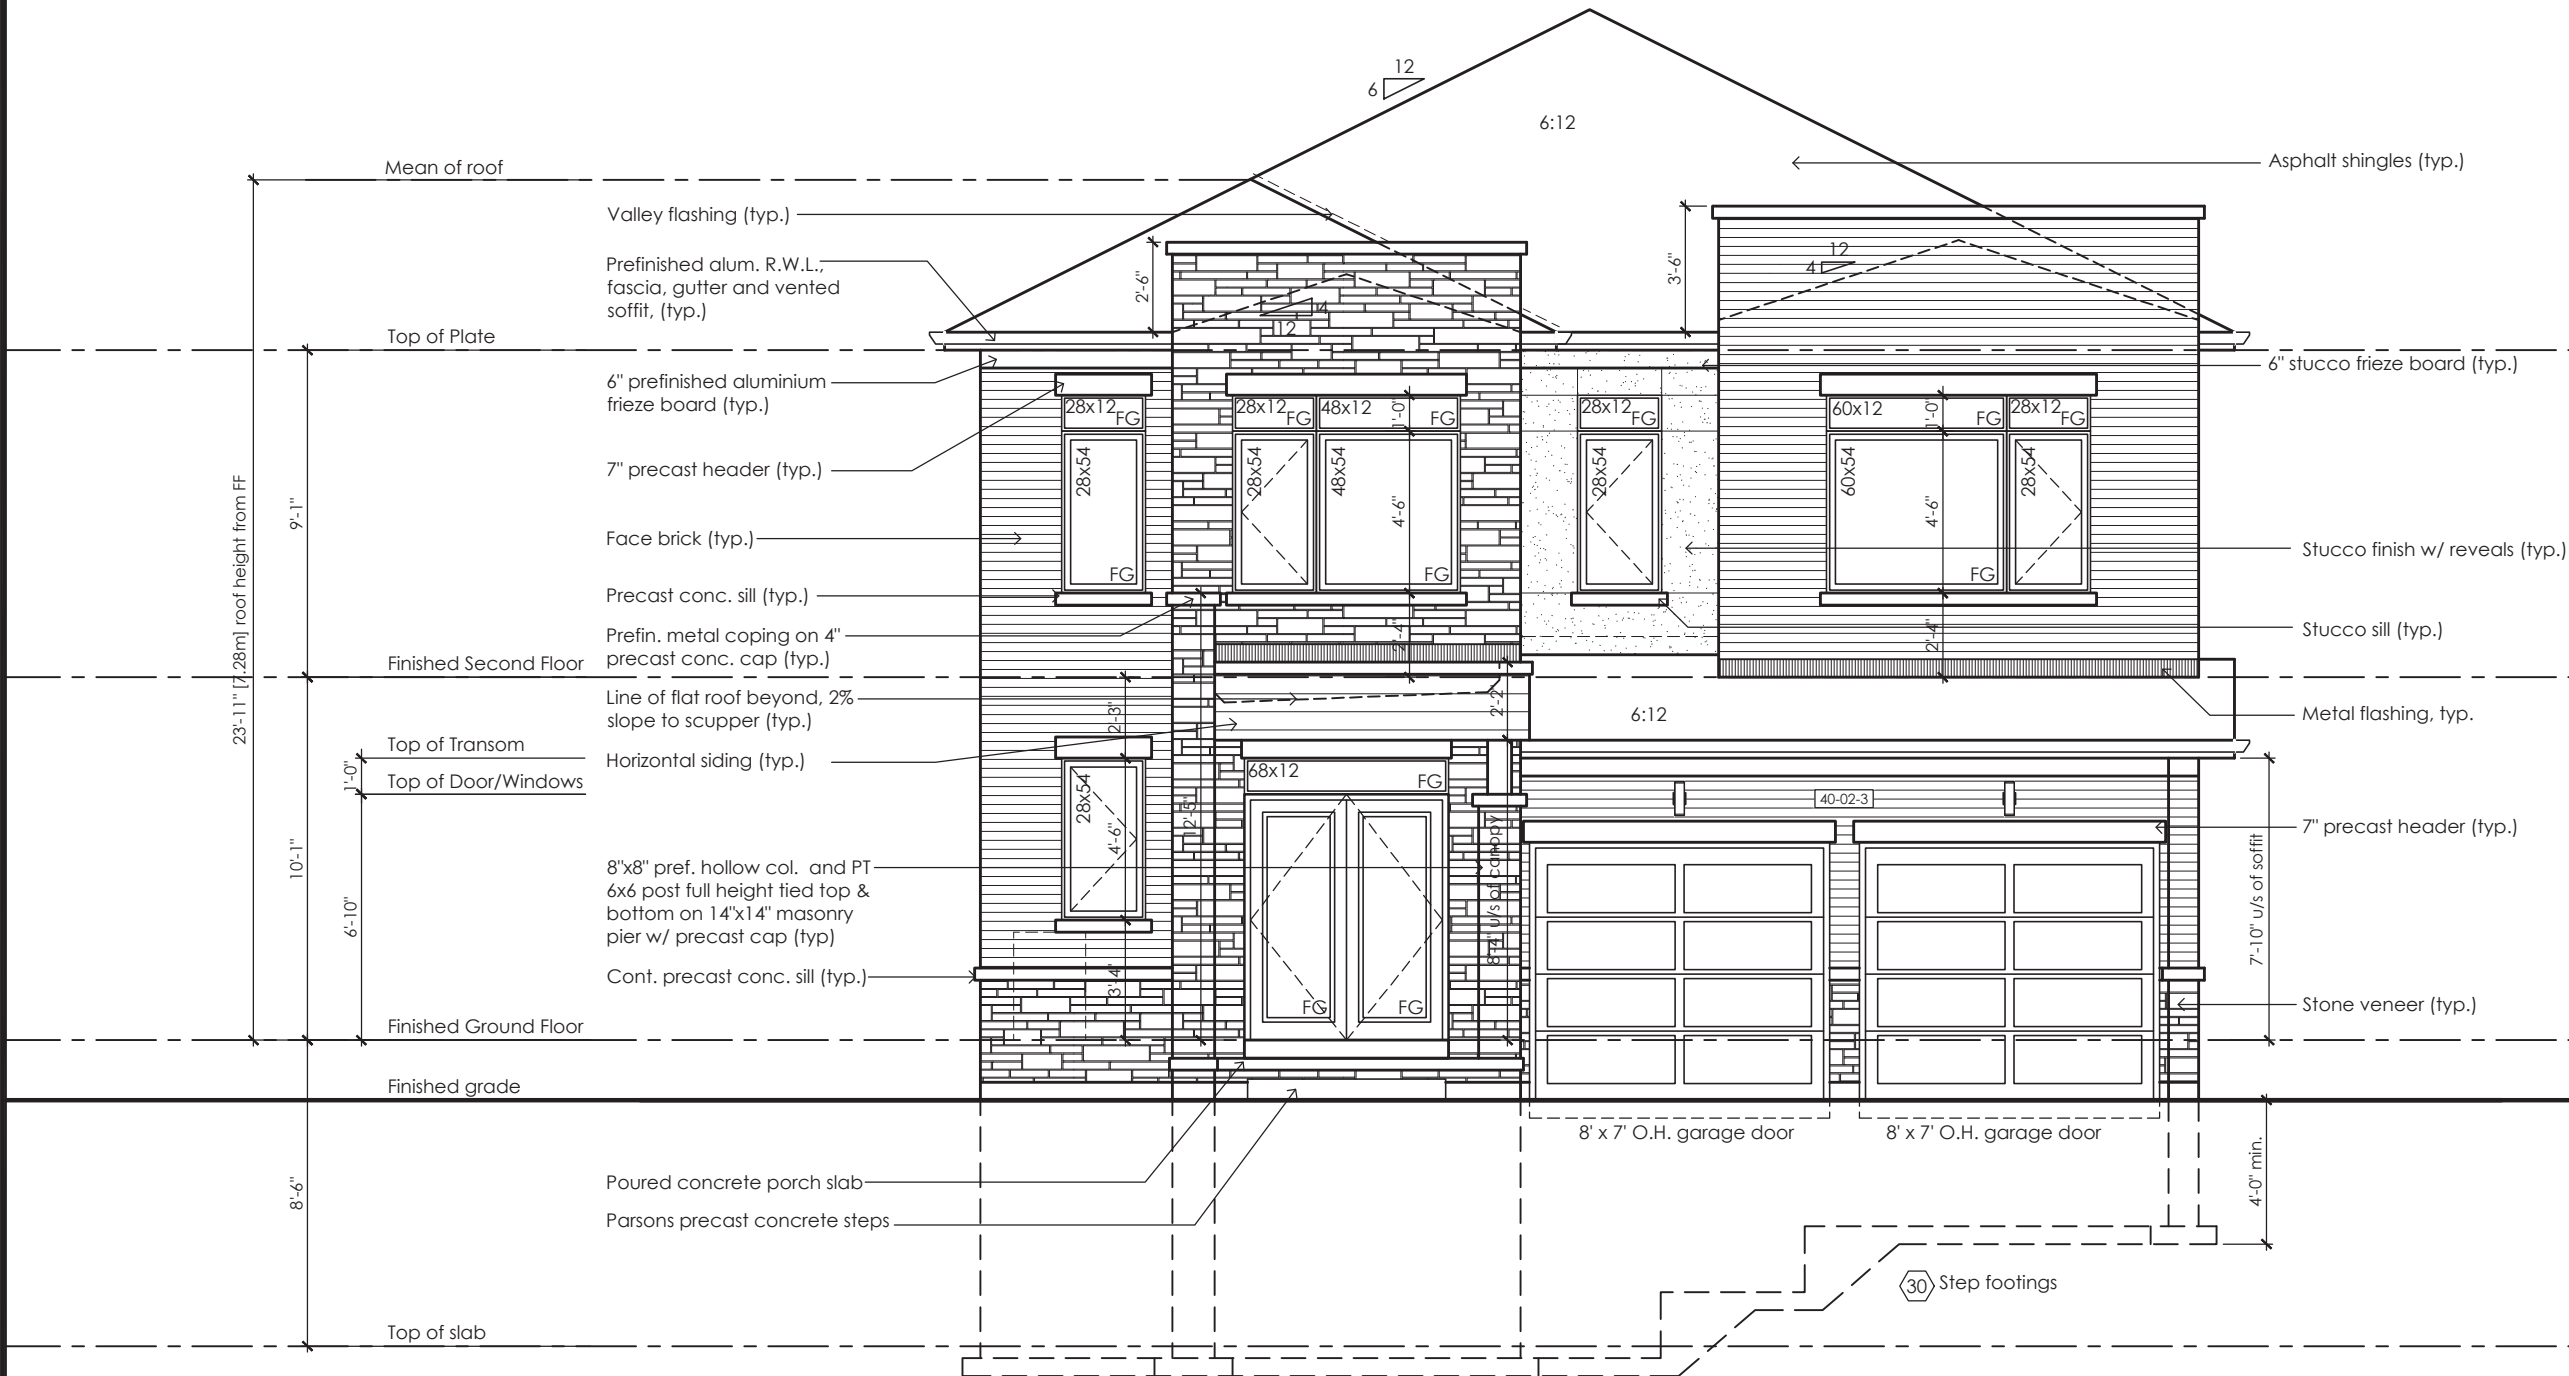


Front Elevation '3'

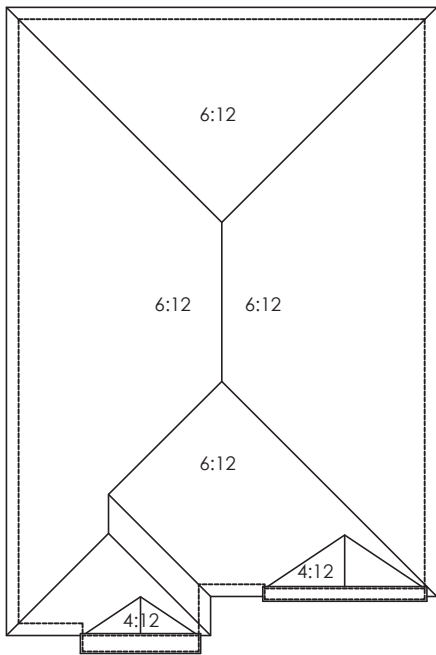

Roof Plan '3'

It is the builder's complete responsibility to ensure that all plans submitted for approval fully comply with the Architectural Guidelines and all applicable regulations and requirements including zoning provisions and any provisions in the subdivision agreement. The Control Architect is not responsible in any way for examining or approving site (lotting) plans or working drawings with respect to any zoning or building code or permit matter or that any house can be properly built or located on its lot.

This is to certify that these plans comply with the applicable Architectural Design Guidelines approved by the City of Oshawa

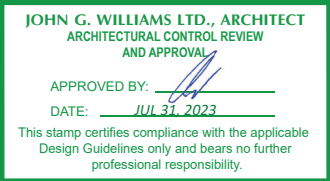

Rose 2

Compliance Package A1

Contractor shall check all dimensions and elevations before commencing with work and report any discrepancies to the Designer. Prints are not to be scaled.

The undersigned has reviewed and takes responsibility for this design, as well as having the qualifications and requirements mandated by the Ontario Building Code (O.B.C.) to be a Designer.

**Qualification Information**

Jamie Mack 35923  
Name BCIN  
Registration Information **Mackitecture** 103532



Front Elevation Elevation 3			
scale <b>3/16" = 1'-0"</b>	by <b>JM</b>	area <b>2998 sq ft</b>	sheet no. <b>4-3</b>
date <b>2023-06-30</b>	type <b>40' Single</b>	project no. <b>22-012</b>	



project name  
**Zadorra Estates Inc.**

It is the builder's complete responsibility to ensure that all plans submitted for approval fully comply with the Architectural Guidelines and all applicable regulations and requirements, including zoning provisions and any provisions in the subdivision agreement. The Architect is not responsible in any way for examining or approving site (lot) working drawings with respect to any zoning or building code or permit matter or that any house can be properly built or located on its lot.

This is to certify that these plans comply with the applicable Architectural Design Guidelines approved by the City of Oshawa



## MHP 23028

Glazed Openings Calculation (OBC 9.10.15.4.)  
Limiting distance: 3'-11" (1.20m)  
Wall area: 1097.2 sq ft (101.94 sq m)  
Permitted glazed openings: 7.0%, 76.8 sq ft (7.14 sq m)  
Provided glazed openings: 6.0%, 65.4 sq ft (6.08 sq m) ✓  
Summary  
Areas calculated with a frame offset of 2,25"  
2 - 15,00 x 16,00: 1,68 sq ft (0,16 sq m)  
2 - 15,00 x 16,00: 1,68 sq ft (0,16 sq m)  
1 - 24,00 x 42,00: 5,08 sq ft (0,47 sq m)  
1 - 24,00 x 42,00: 5,08 sq ft (0,47 sq m)  
2 - 24,00 x 48,00: 11,78 sq ft (1,09 sq m)  
2 - 24,00 x 66,00: 16,66 sq ft (1,55 sq m)  
2 - 32,00 x 66,00: 23,49 sq ft (2,18 sq m)



Left Side Elevation '1'

Rose 2  
Compliance Package A1

Contractor shall check all dimensions and elevations before commencing with work and report any discrepancies to the Designer. Prints are not to be scaled.

The undersigned has reviewed and takes responsibility for this design, as well as having the qualifications and requirements mandated by the Ontario Building Code (O.B.C.) to be a Designer.

### Qualification Information

Jamie Mack 35923  
Name BCIN Signature  
Registration Information Mackitecture 103532



www.mackitecture.ca

975A Elgin Street West, Suite 353  
Cobourg, ON K9A 5J3  
Tel: 416-735-8190 Email: info@mackitecture.ca

### Left Side Elevation Elevation 1

scale	by	area	sheet no.
3/16" = 1'-0"	JM	3005 sq ft	5-1
date	type	project no.	
2023-06-30	40' Single	22-012	




www.greenparkgroup.ca

project name  
Zadorra Estates Inc.

It is the builder's complete responsibility to ensure that all plans submitted for approval fully comply with the Architectural Guidelines and all applicable regulations and requirements, including zoning provisions and any provisions in the subdivision agreement. The Architect is not responsible in examining or approving site (lot) working drawings with respect to any zoning or building code or permit matter or that any house can be properly built or located on its lot.

This is to certify that these plans comply with the applicable Architectural Design Guidelines approved by the City of Oshawa

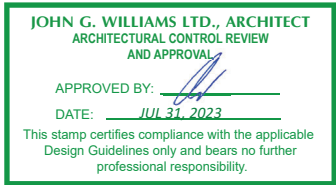

MHP 23028

Glazed Openings Calculation (OBC 9.10.15.4.)  
Limiting distance: 3'-11" (1.20m)  
Wall area: 1097.2 sq ft (101.94 sq m)  
Permitted glazed openings: 7.0%, 76.8 sq ft (7.14 sq m) ✓  
Provided glazed openings: 6.0%, 65.4 sq ft (6.08 sq m) ✓  
Summary  
Areas calculated with a frame offset of 2,25"  
2 - 15,00 x 16,00: 1,68 sq ft (0,16 sq m)  
2 - 15,00 x 16,00: 1,68 sq ft (0,16 sq m)  
1 - 24,00 x 42,00: 5,08 sq ft (0,47 sq m)  
1 - 24,00 x 42,00: 5,08 sq ft (0,47 sq m)  
2 - 24,00 x 48,00: 11,78 sq ft (1,09 sq m)  
2 - 24,00 x 66,00: 16,66 sq ft (1,55 sq m)  
2 - 32,00 x 66,00: 23,49 sq ft (2,18 sq m)



Left Side Elevation '2'

Rose 2  
Compliance Package A1

Contractor shall check all dimensions and elevations before commencing with work and report any discrepancies to the Designer. Prints are not to be scaled.

The undersigned has reviewed and takes responsibility for this design, as well as having the qualifications and requirements mandated by the Ontario Building Code (O.B.C.) to be a Designer.

**Qualification Information**

Jamie Mack 35923  
Name BCIN Signature  
Registration Information Mackitecture 103532

  
www.mackitecture.ca  
975A Elgin Street West, Suite 353  
Cobourg, ON K9A 5J3  
Tel: 416-735-8190 Email: info@mackitecture.ca

Left Side Elevation Elevation 2				
scale 3/16" = 1'-0"	by JM	area 2999 sq ft	sheet no. 5-2	
date 2023-06-30	type 40' Single	project no. 22-012		

  
www.greenparkgroup.ca

project name  
Zadorra Estates Inc.


It is the builder's complete responsibility to ensure that all plans submitted for approval fully comply with the Architectural Guidelines and all applicable regulations and requirements, including zoning provisions and any provisions in the subdivision agreement. The Architect is not responsible in examining or approving site (lot) working drawings with respect to any zoning or building code or permit matter or that any house can be properly built or located on its lot.

This is to certify that these plans comply with the applicable Architectural Design Guidelines approved by the City of Oshawa

JOHN G. WILLIAMS LTD., ARCHITECT  
ARCHITECTURAL CONTROL REVIEW  
AND APPROVAL  
APPROVED BY:   
DATE: JUL 31, 2023  
This stamp certifies compliance with the applicable Design Guidelines only and bears no further professional responsibility.

## MHP 23028

Glazed Openings Calculation (OBC 9.10.15.4.)  
Limiting distance: 3'-11" (1.20m)  
Wall area: 1097.2 sq ft (101.94 sq m)  
Permitted glazed openings: 7.0%, 76.8 sq ft (7.14 sq m) ✓  
Provided glazed openings: 6.0%, 65.4 sq ft (6.08 sq m)  
Summary  
Areas calculated with a frame offset of 2,25"  
2 - 15,00 x 16,00: 1,68 sq ft (0,16 sq m)  
2 - 15,00 x 16,00: 1,68 sq ft (0,16 sq m)  
1 - 24,00 x 42,00: 5,08 sq ft (0,47 sq m)  
1 - 24,00 x 42,00: 5,08 sq ft (0,47 sq m)  
2 - 24,00 x 48,00: 11,78 sq ft (1,09 sq m)  
2 - 24,00 x 66,00: 16,66 sq ft (1,55 sq m)  
2 - 32,00 x 66,00: 23,49 sq ft (2,18 sq m)

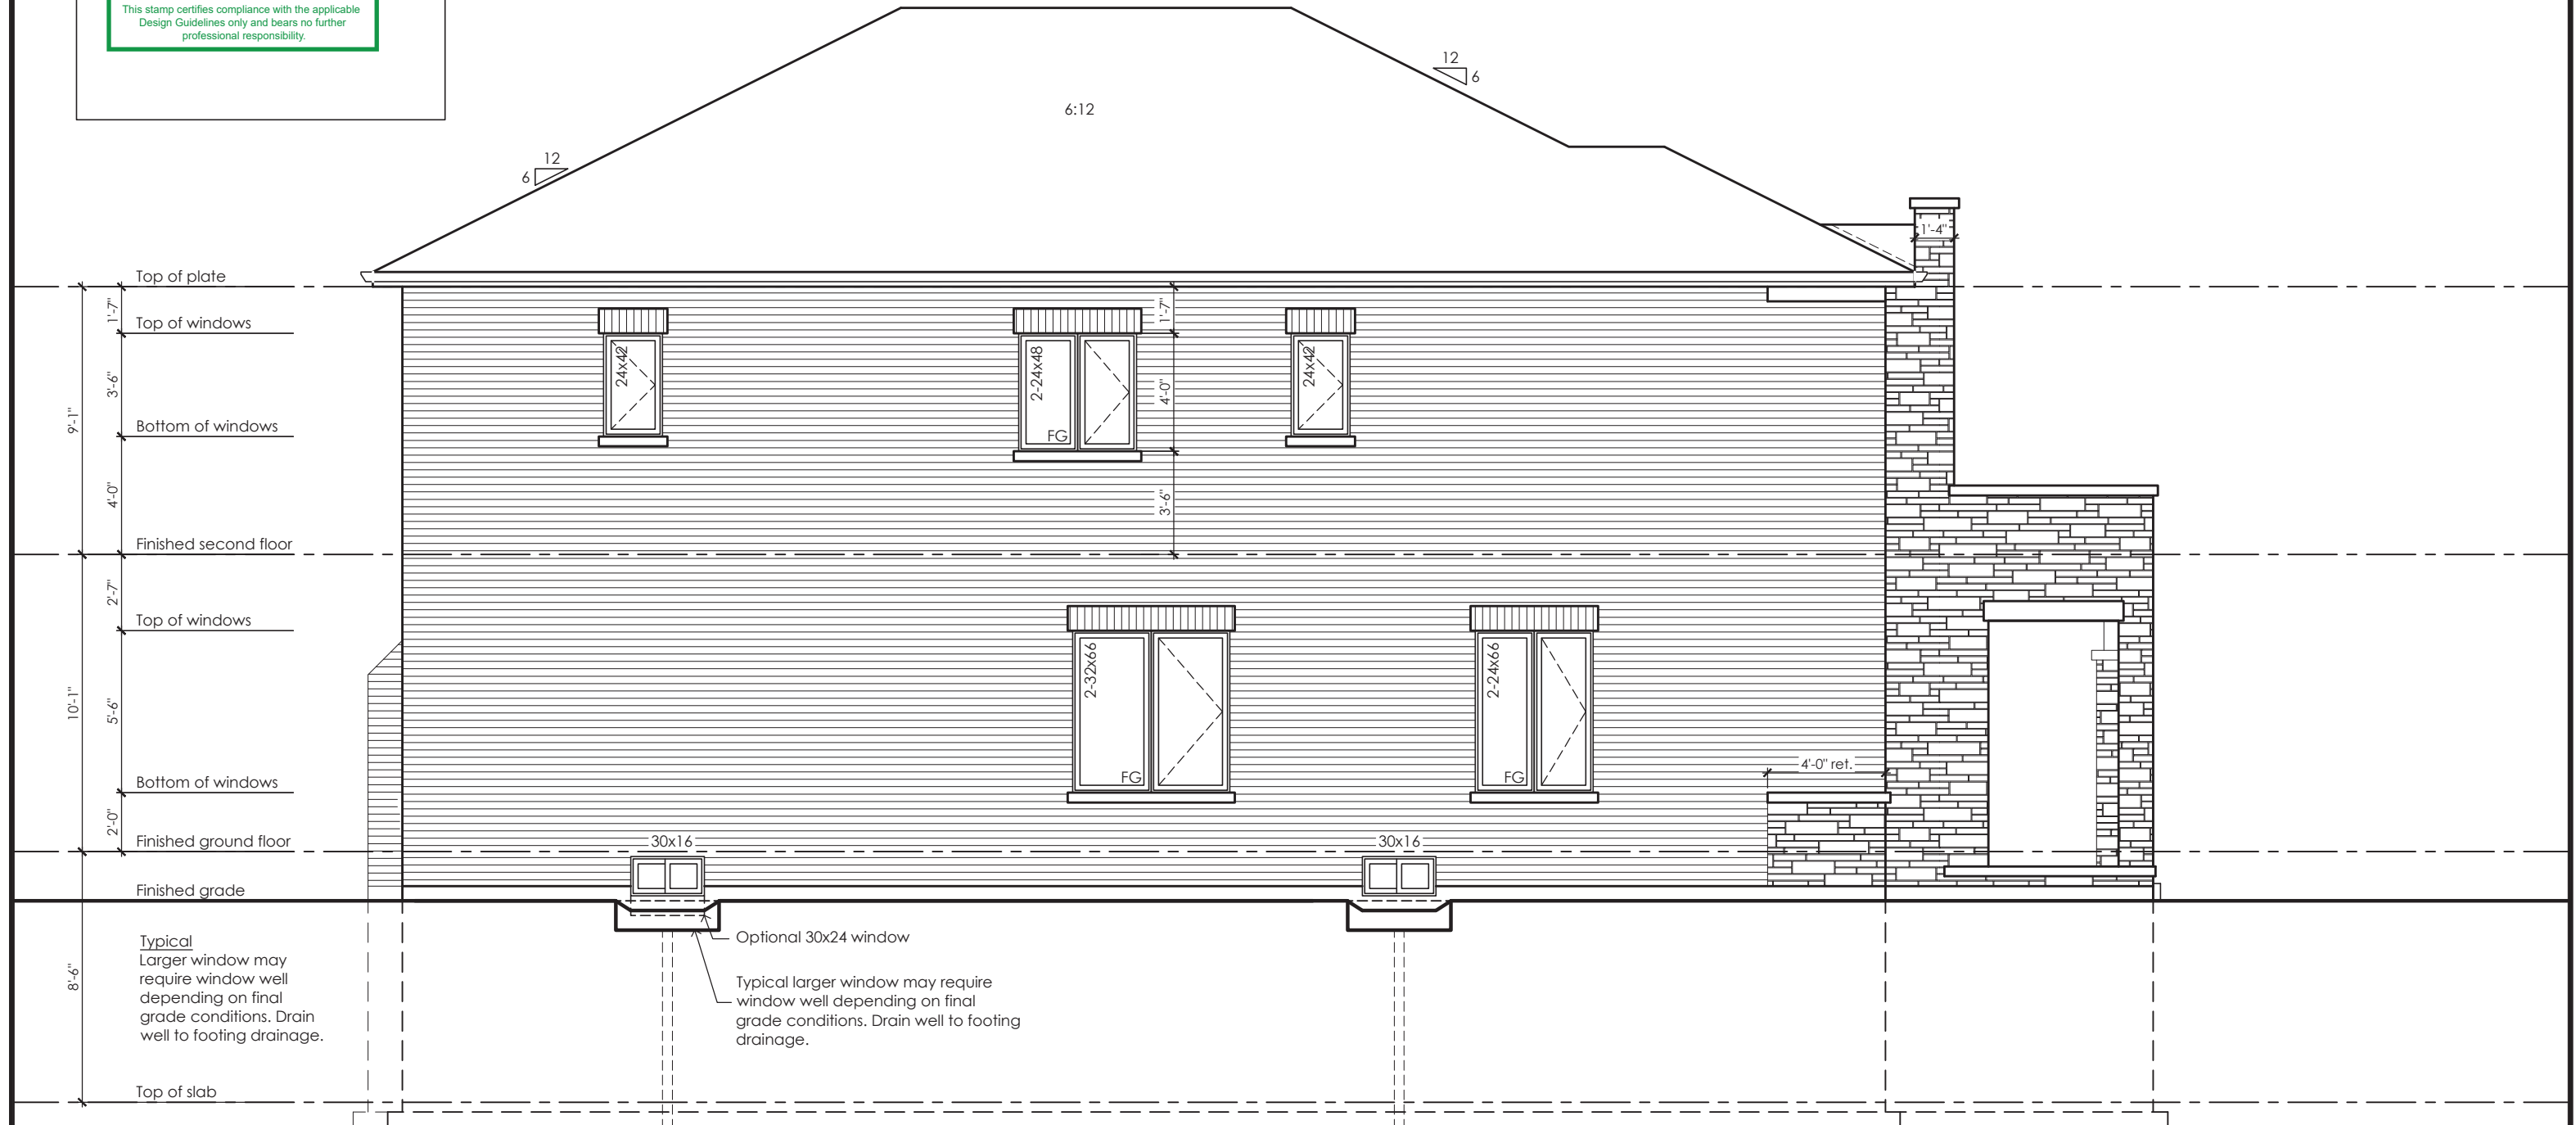

Left Side Elevation '3'


Rose 2

Compliance Package A1

Contractor shall check all dimensions and elevations before commencing with work and report any discrepancies to the Designer. Prints are not to be scaled.

The undersigned has reviewed and takes responsibility for this design, as well as having the qualifications and requirements mandated by the Ontario Building Code (O.B.C.) to be a Designer.

**Qualification Information**

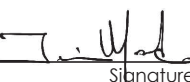Jamie Mack 35923  
Name BCIN Signature 

Registration Information **Mackitecture** 103532



**www.mackitecture.ca**  
975A Elgin Street West, Suite 353  
Cobourg, ON K9A 5J3  
Tel: 416-735-8190 Email: info@mackitecture.ca

Left Side Elevation Elevation 3			
scale <b>3/16" = 1'-0"</b>	by <b>JM</b>	area <b>2998 sq ft</b>	sheet no. <b>5-3</b>
date <b>2023-06-30</b>	type <b>40' Single</b>	project no. <b>22-012</b>	




[www.greenparkgroup.ca](http://www.greenparkgroup.ca)

project name  
**Zadorra Estates Inc.**

It is the builder's complete responsibility to ensure that all plans submitted for approval fully comply with the Architectural Guidelines and all applicable regulations and requirements including zoning provisions and any provisions in the subdivision agreement. The Architect is not responsible in any way for examining or approving site (lot) working drawings with respect to any zoning or building code or permit matter or that any house can be properly built or located on its lot.

This is to certify that these plans comply with the applicable Architectural Design Guidelines approved by the City of Oshawa


JOHN G. WILLIAMS LTD., ARCHITECT  
ARCHITECTURAL CONTROL REVIEW  
AND APPROVAL

APPROVED BY:   
DATE: JUL 31, 2023

This stamp certifies compliance with the applicable Design Guidelines only and bears no further professional responsibility.

MHP 23028

Red for approval fully  
COOPERATION OF THE CITY OF OSHAWA  
TRUE COPY  
OF PERMIT PLANS  
Nov 15 2023  
C. Mack  
CITY BUILDING OFFICIAL

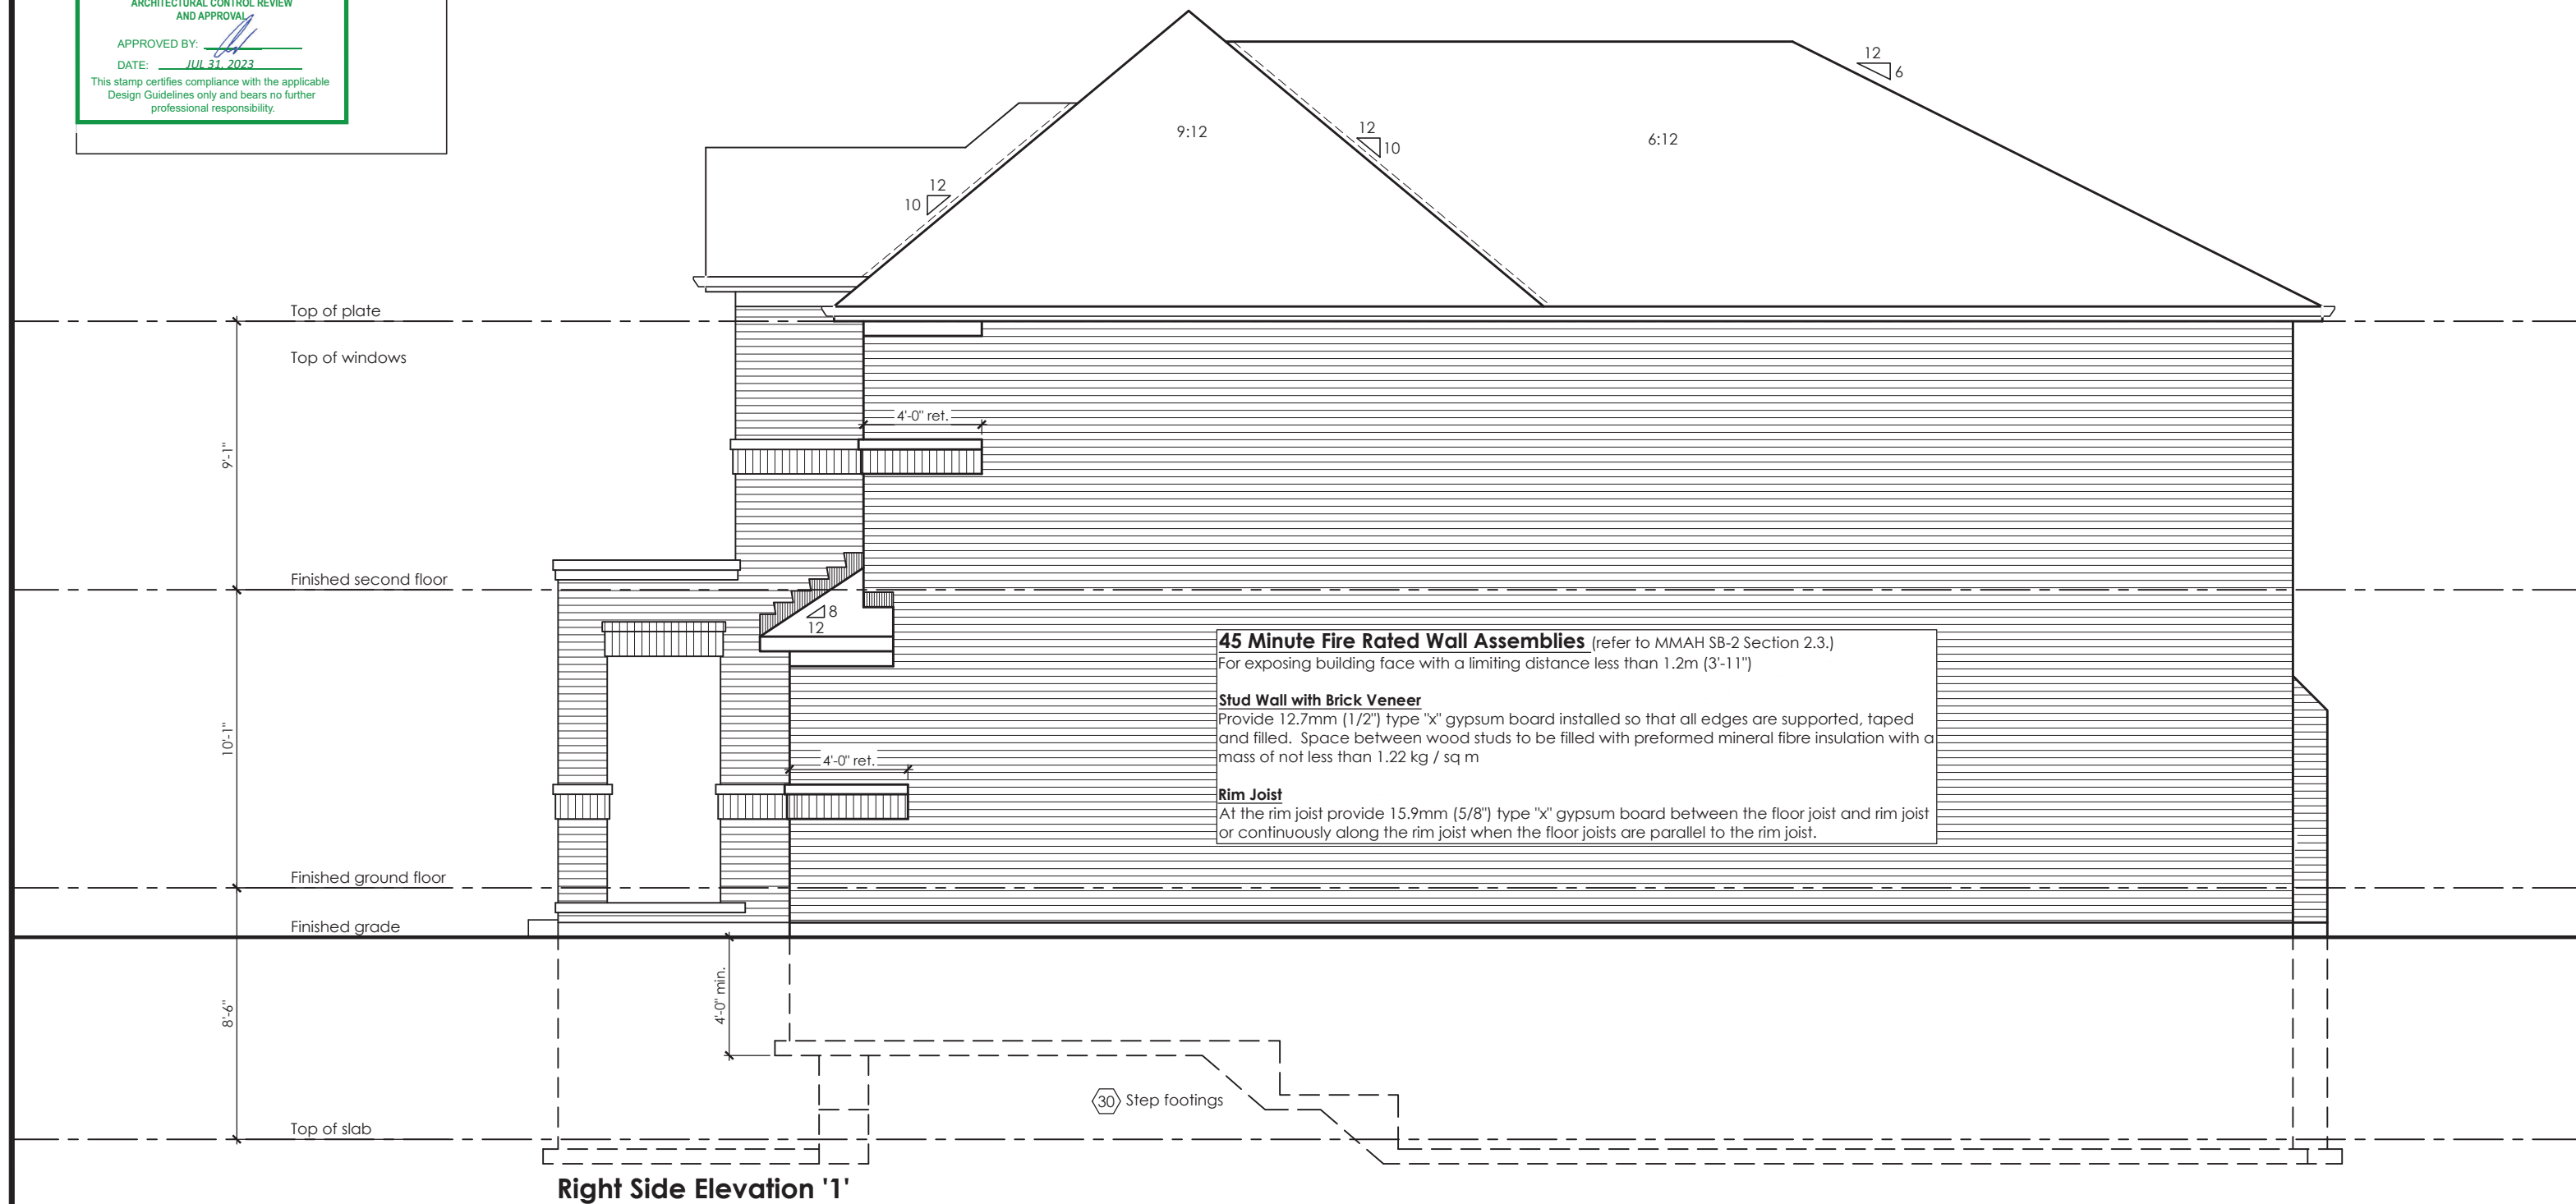

Rose 2

Compliance Package A1

Contractor shall check all dimensions and elevations before commencing with work and report any discrepancies to the Designer. Prints are not to be scaled.

The undersigned has reviewed and takes responsibility for this design, as well as having the qualifications and requirements mandated by the Ontario Building Code (O.B.C.) to be a Designer.

**Qualification Information**

Jamie Mack 35923  
Name BCIN Signature

Registration Information **Mackitecture** 103532

  
**www.mackitecture.ca**  
975A Elgin Street West, Suite 353  
Cobourg, ON K9A 5J3  
Tel: 416-735-8190 Email: info@mackitecture.ca

Right Side Elevation Elevation 1				
scale <b>3/16" = 1'-0"</b>	by <b>JM</b>	area <b>3005 sq ft</b>	sheet no. <b>6-1</b>	
date <b>2023-06-30</b>	type <b>40' Single</b>	project no. <b>22-012</b>		

  
**www.greenparkgroup.ca**

project name  
**Zadorra Estates Inc.**


It is the builder's complete responsibility to ensure that all plans submitted for approval fully comply with the Architectural Guidelines and all applicable regulations and requirements including zoning provisions and any provisions in the subdivision agreement. The Architect is not responsible in any way for examining or approving site (lot) working drawings with respect to any zoning or building code or permit matter or that any house can be properly built or located on its lot.

This is to certify that these plans comply with the applicable Architectural Design Guidelines approved by the City of Oshawa

JOHN G. WILLIAMS LTD., ARCHITECT  
ARCHITECTURAL CONTROL REVIEW  
AND APPROVAL  
APPROVED BY:   
DATE: JUL 31, 2023  
This stamp certifies compliance with the applicable Design Guidelines only and bears no further professional responsibility.

MHP 23028

Red for approval fully  
CORPORATION OF THE CITY OF OSHAWA  
TRUE COPY  
OF PERMIT PLANS  
Nov 15 2023  
C. Mack  
CITY BUILDING OFFICIAL

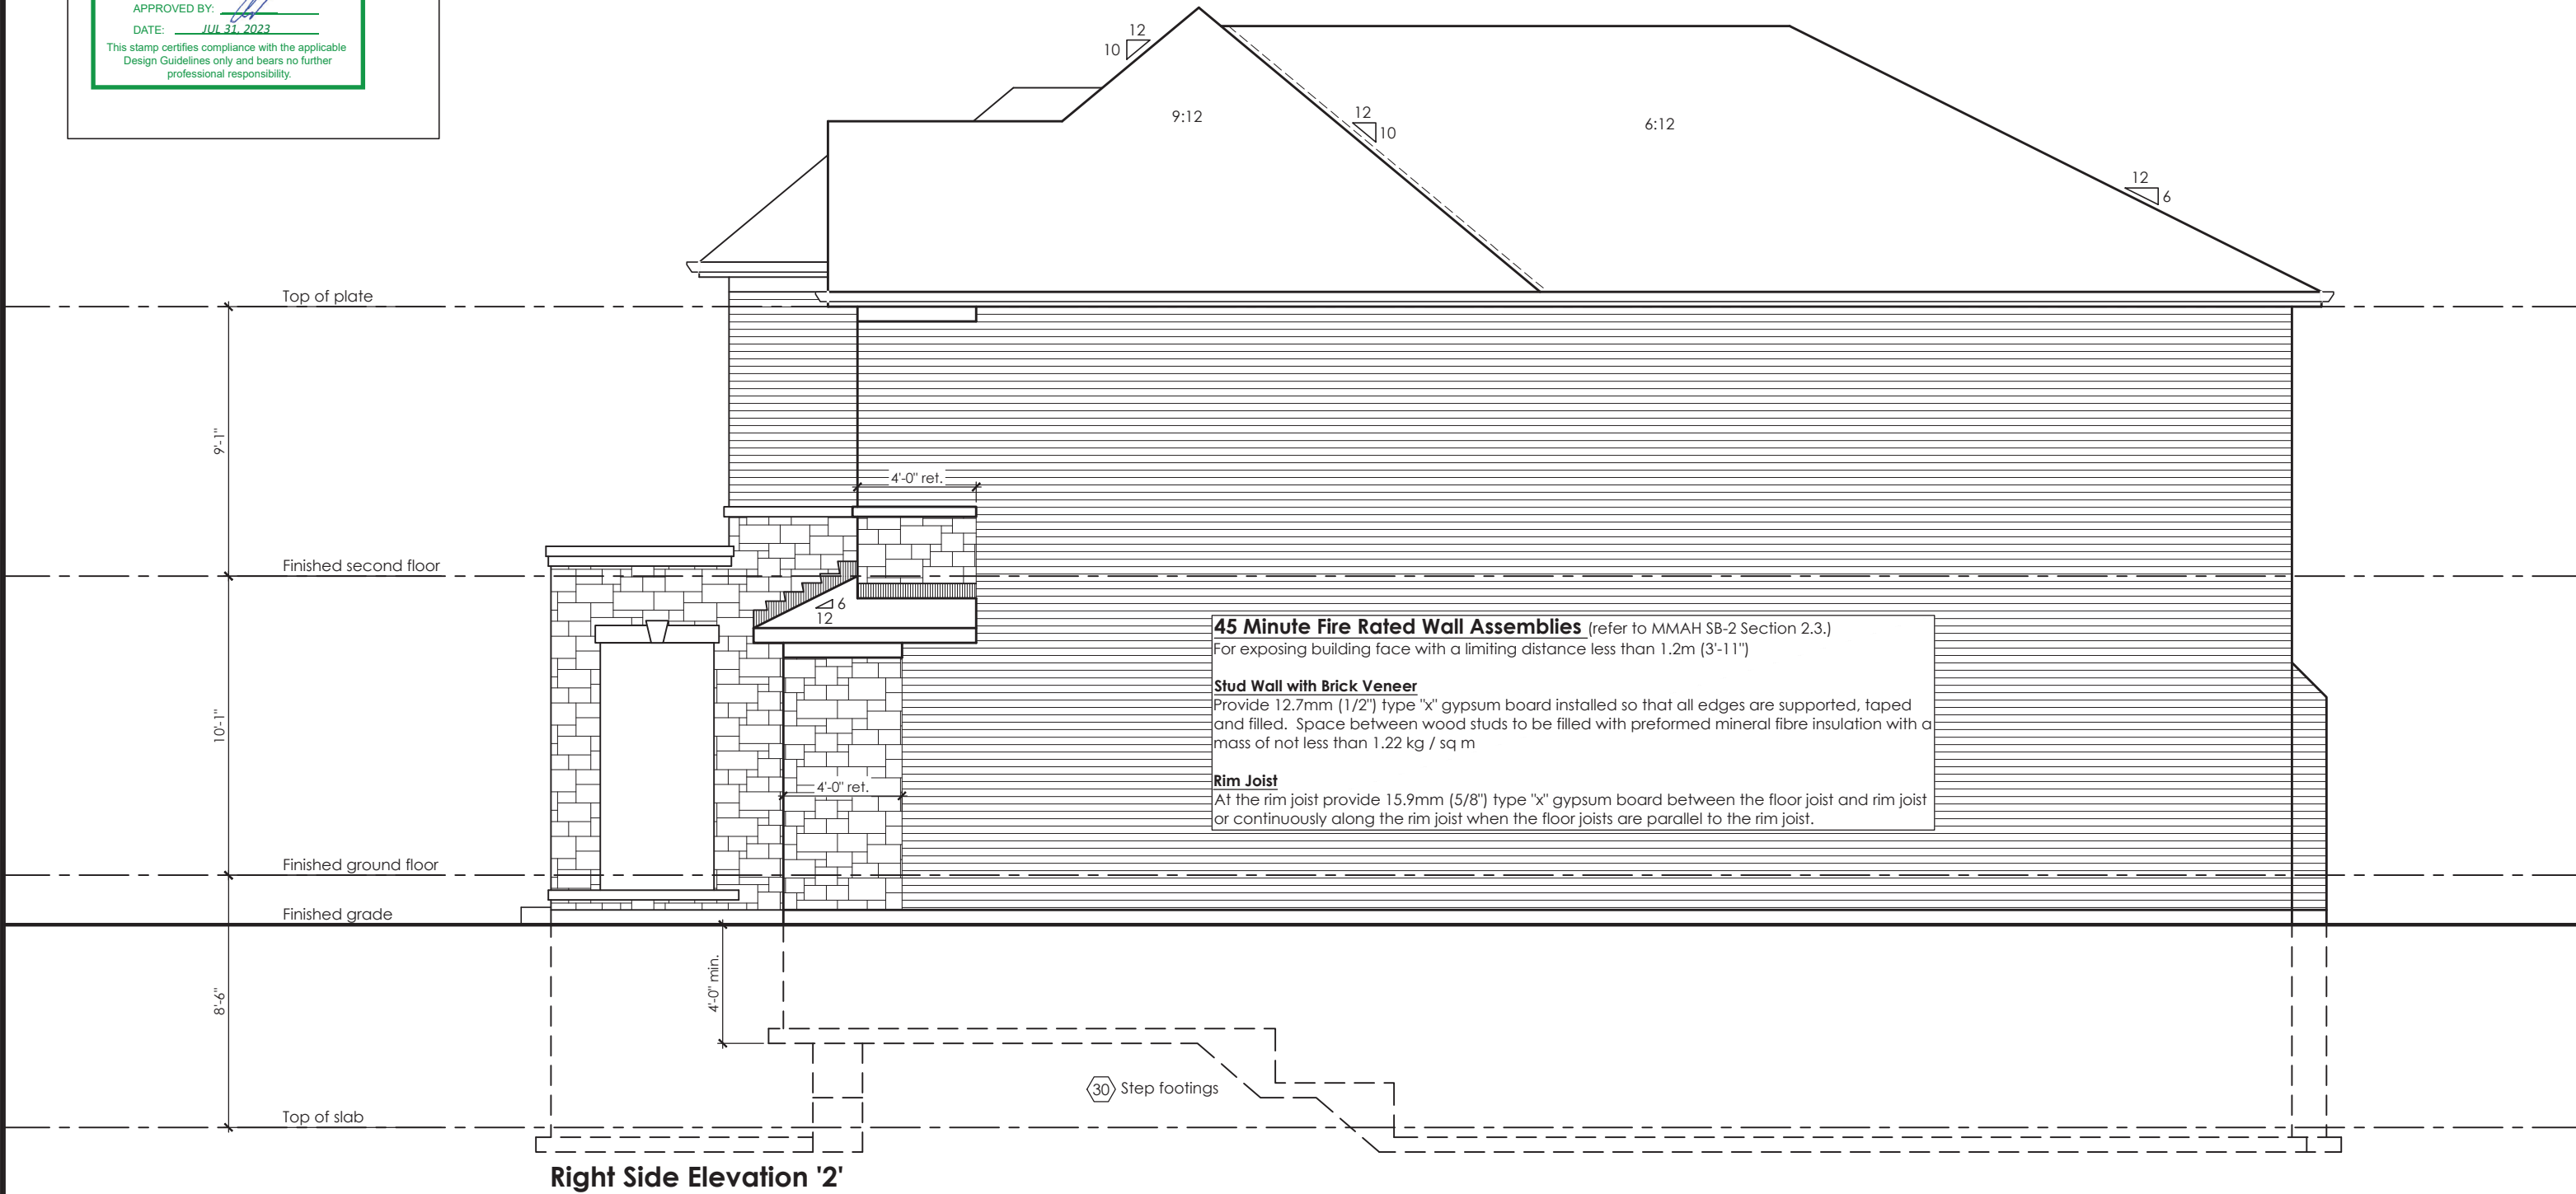

Right Side Elevation '2'

Rose 2  
Compliance Package A1

Contractor shall check all dimensions and elevations before commencing with work and report any discrepancies to the Designer. Prints are not to be scaled.

The undersigned has reviewed and takes responsibility for this design, as well as having the qualifications and requirements mandated by the Ontario Building Code (O.B.C.) to be a Designer.

**Qualification Information**

Jamie Mack 35923  
Name BCIN  
Registration Information Mackitecture 103532

  
**www.mackitecture.ca**  
975A Elgin Street West, Suite 353  
Cobourg, ON K9A 5J3  
Tel: 416-735-8190 Email: info@mackitecture.ca

Right Side Elevation Elevation 2			
scale 3/16" = 1'-0"	by JM	area 2999 sq ft	sheet no. 6-2
date 2023-06-30	type 40' Single	project no. 22-012	


  
**www.greenparkgroup.ca**  
project name  
Zadorra Estates Inc.

MHP 23028

JOHN G. WILLIAMS LTD., ARCHITECT  
ARCHITECTURAL CONTROL REVIEW  
AND APPROVAL

APPROVED BY:   
DATE: JUL 31, 2023

This stamp certifies compliance with the applicable  
Design Guidelines only and bears no further  
professional responsibility.

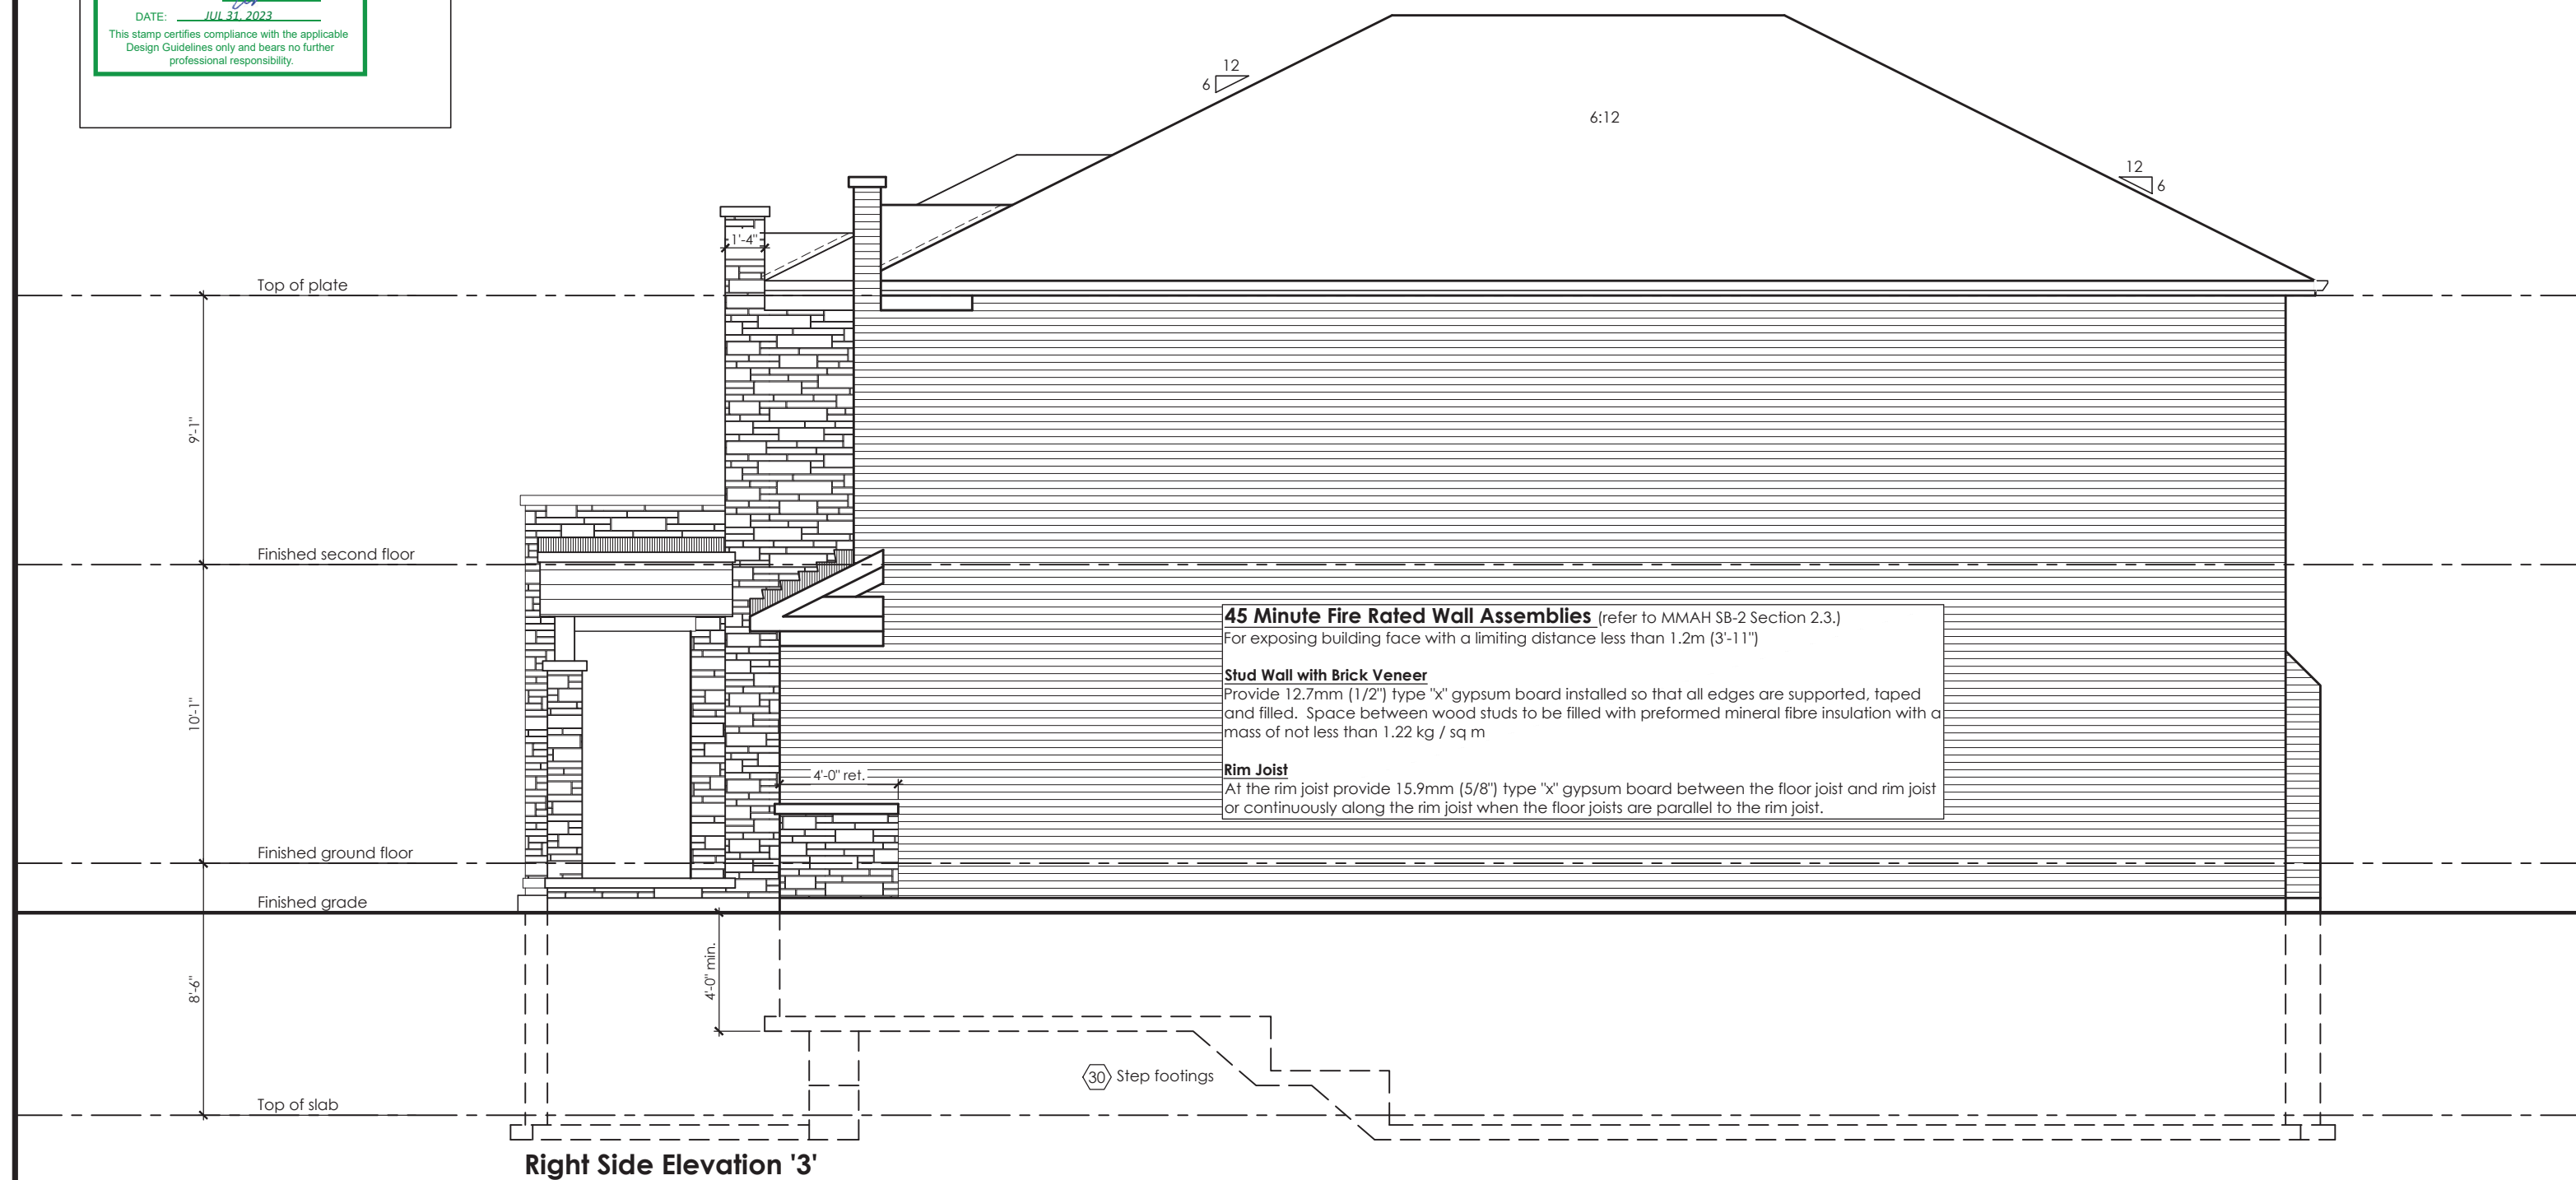

## Rose 2

### Compliance Package A1

### Qualification Information

## Registration Information

## Mackitecture

103532



Tel: 416-735-8190 Email: [info@mackitecture.ca](mailto:info@mackitecture.ca)

**Right Side Elevation**  
**Elevation 3**

## 6-3

22-012



**Greenpark**

[www.greenparkgroup.ca](http://www.greenparkgroup.ca)

project name
--------------

**Zadorra Estates Inc.**

Contractor shall check all dimensions and elevations before commencing with work and report any discrepancies to the Designer. Prints are not to be scaled.

It is the builder's complete responsibility to ensure that all plans submitted for approval fully comply with the Architectural Guidelines and all applicable regulations and requirements, including zoning provisions and any provisions in the subdivision agreement. The Architect is not responsible in examining or approving site (lot) working drawings with respect to any zoning or building code or permit matter or that any house can be properly built or located on its lot.

This is to certify that these plans comply with the applicable Architectural Design Guidelines approved by the City of Oshawa

JOHN G. WILLIAMS LTD., ARCHITECT  
ARCHITECTURAL CONTROL REVIEW  
AND APPROVAL  
APPROVED BY:   
DATE: JUL 31, 2023  
This stamp certifies compliance with the applicable Design Guidelines only and bears no further professional responsibility.

MHP 23028

Red for approval fully  
TRUE COPY  
OF PERMIT PLANS  
Nov 15 2023  
CHIEF BUILDING OFFICIAL



Rear Elevation '1', '2' & '3'

Rose 2  
Compliance Package A1

Contractor shall check all dimensions and elevations before commencing with work and report any discrepancies to the Designer. Prints are not to be scaled.

The undersigned has reviewed and takes responsibility for this design, as well as having the qualifications and requirements mandated by the Ontario Building Code (O.B.C.) to be a Designer.

**Qualification Information**

Jamie Mack 35923  
Name BCIN Signature  
Registration Information **Mackitecture** 103532

  
**www.mackitecture.ca**  
975A Elgin Street West, Suite 353  
Cobourg, ON K9A 5J3  
Tel: 416-735-8190 Email: info@mackitecture.ca

title  
**Rear Elevation  
Elevation 1, 2, 3**

scale <b>3/16" = 1'-0"</b>	by <b>JM</b>	area <b>-</b>	sheet no. <b>7-1</b>
date <b>2023-06-30</b>	type <b>40' Single</b>	project no. <b>22-012</b>	

  
**www.greenparkgroup.ca**

project name  
**Zadorra Estates Inc.**

It is the builder's complete responsibility to ensure that all plans submitted for approval fully comply with the Architectural Guidelines and all applicable regulations and requirements, including zoning provisions and any provisions in the subdivision agreement. The Architect is not responsible in any way for examining or approving site (lot) working drawings with respect to any zoning or building code or permit matter or that any house can be properly built or located on its lot.

This is to certify that these plans comply with the applicable Architectural Design Guidelines approved by the City of Oshawa

JOHN G. WILLIAMS LTD., ARCHITECT  
ARCHITECTURAL CONTROL REVIEW  
AND APPROVAL  
APPROVED BY:   
DATE: JUL 31, 2023  
This stamp certifies compliance with the applicable Design Guidelines only and bears no further professional responsibility.

MHP 23028



Rear Upgrade Elevation '1'

Rose 2  
Compliance Package A1

Contractor shall check all dimensions and elevations before commencing with work and report any discrepancies to the Designer. Prints are not to be scaled.

The undersigned has reviewed and takes responsibility for this design, as well as having the qualifications and requirements mandated by the Ontario Building Code (O.B.C.) to be a Designer.

**Qualification Information**

Jamie Mack 35923  
Name BCIN  
Registration Information **Mackitecture** 103532

  
**www.mackitecture.ca**  
975A Elgin Street West, Suite 353  
Cobourg, ON K9A 5J3  
Tel: 416-735-8190 Email: info@mackitecture.ca

Rear Upgrade Elevation Elevation 1				
scale <b>3/16" = 1'-0"</b>	by <b>JM</b>	area <b>-</b>	sheet no. <b>7-1A</b>	
date <b>2023-06-30</b>	type <b>40' Single</b>	project no. <b>22-012</b>		

  
**www.greenparkgroup.ca**  
project name  
**Zadorra Estates Inc.**

It is the builder's complete responsibility to ensure that all plans submitted for approval fully comply with the Architectural Guidelines and all applicable regulations and requirements, including zoning provisions and any provisions of the subdivision agreement. The Architect is not responsible in any way for examining or approving site (lot) working drawings with respect to any zoning or building code or permit matter or that any house can be properly built or located on its lot.

This is to certify that these plans comply with the applicable Architectural Design Guidelines approved by the City of Oshawa

JOHN G. WILLIAMS LTD., ARCHITECT  
ARCHITECTURAL CONTROL REVIEW  
AND APPROVAL  
APPROVED BY:   
DATE: JUL 31, 2023  
This stamp certifies compliance with the applicable Design Guidelines only and bears no further professional responsibility.

MHP 23028



Rear Upgrade Elevation '2'

Rose 2  
Compliance Package A1

	<div>The undersigned has reviewed and takes responsibility for this design, as well as having the qualifications and requirements mandated by the Ontario Building Code (O.B.C.) to be a Designer.</div> <div>Qualification Information</div> <div><div>Jamie Mack</div><div>35923</div><div></div></div> <div><div>Name</div><div>BCIN</div><div>Signature</div></div> <div><div>Registration Information</div><div>Mackitecture</div><div>103532</div></div>	<div></div> <div>www.mackitecture.ca</div> <div>975A Elgin Street West, Suite 353 Cobourg, ON K9A 5J3 Tel: 416-735-8190 Email: info@mackitecture.ca</div>	<table><tr><td colspan="4">Title</td><td colspan="2">Rear Upgrade Elevation Elevation 2</td></tr><tr><td>scale</td><td>3/16" = 1'-0"</td><td>by</td><td>JM</td><td>area</td><td>-</td></tr><tr><td>date</td><td>2023-06-30</td><td>type</td><td>40' Single</td><td>project no.</td><td>22-012</td></tr><tr><td colspan="4"></td><td>sheet no.</td><td>7-2A</td></tr></table>	Title				Rear Upgrade Elevation Elevation 2		scale	3/16" = 1'-0"	by	JM	area	-	date	2023-06-30	type	40' Single	project no.	22-012					sheet no.	7-2A	<div></div> <div>www.greenparkgroup.ca</div> <div>project name</div> <div>Zadorra Estates Inc.</div>
Title				Rear Upgrade Elevation Elevation 2																								
scale	3/16" = 1'-0"	by	JM	area	-																							
date	2023-06-30	type	40' Single	project no.	22-012																							
				sheet no.	7-2A																							
Contractor shall check all dimensions and elevations before commencing with work and report any discrepancies to the Designer. Prints are not to be scaled.																												

Drawing created with Mackitecture v.1.0.0 (build 2654). File P:\2022\22-012-GREENPARK-ZADORRA-OSHAWA\UNITS\WORKING\22-012-ROSE 2-WD-V1.DWG plotted on 2023-06-30 at 12:53:32 PM by JMACK

It is the builder's complete responsibility to ensure that all plans submitted for approval fully comply with the Architectural Guidelines and all applicable regulations and requirements including zoning provisions and any provisions in the subdivision agreement. The Architect is not responsible in any way for examining or approving site (lot) working drawings with respect to any building code or permit matter or that any house can be properly built or located on its lot.

This is to certify that these plans comply with the applicable Architectural Design Guidelines approved by the City of Oshawa

JOHN G. WILLIAMS LTD., ARCHITECT  
ARCHITECTURAL CONTROL REVIEW  
AND APPROVAL  
APPROVED BY:   
DATE: JUL 31, 2023  
This stamp certifies compliance with the applicable Design Guidelines only and bears no further professional responsibility.

MHP 23028



Rear Upgrade Elevation '3'

Rose 2  
Compliance Package A1

Contractor shall check all dimensions and elevations before commencing with work and report any discrepancies to the Designer. Prints are not to be scaled.

The undersigned has reviewed and takes responsibility for this design, as well as having the qualifications and requirements mandated by the Ontario Building Code (O.B.C.) to be a Designer.

**Qualification Information**

Jamie Mack 35923  
Name BCIN  
Registration Information **Mackitecture** 103532

  
**www.mackitecture.ca**  
975A Elgin Street West, Suite 353  
Cobourg, ON K9A 5J3  
Tel: 416-735-8190 Email: info@mackitecture.ca


**Rear Upgrade Elevation  
Elevation 3**

scale <b>3/16" = 1'-0"</b>	by <b>JM</b>	area <b>-</b>	sheet no. <b>7-3A</b>
date <b>2023-06-30</b>	type <b>40' Single</b>	project no. <b>22-012</b>	

  
**www.greenparkgroup.ca**  
project name  
**Zadorra Estates Inc.**

CORPORATION OF THE CITY OF OSHAWA  
TRUE COPY  
OF PERMIT PLANS  
Nov 15 2023  
PER:   
CHIEF BUILDING OFFICIAL

MHP 23028

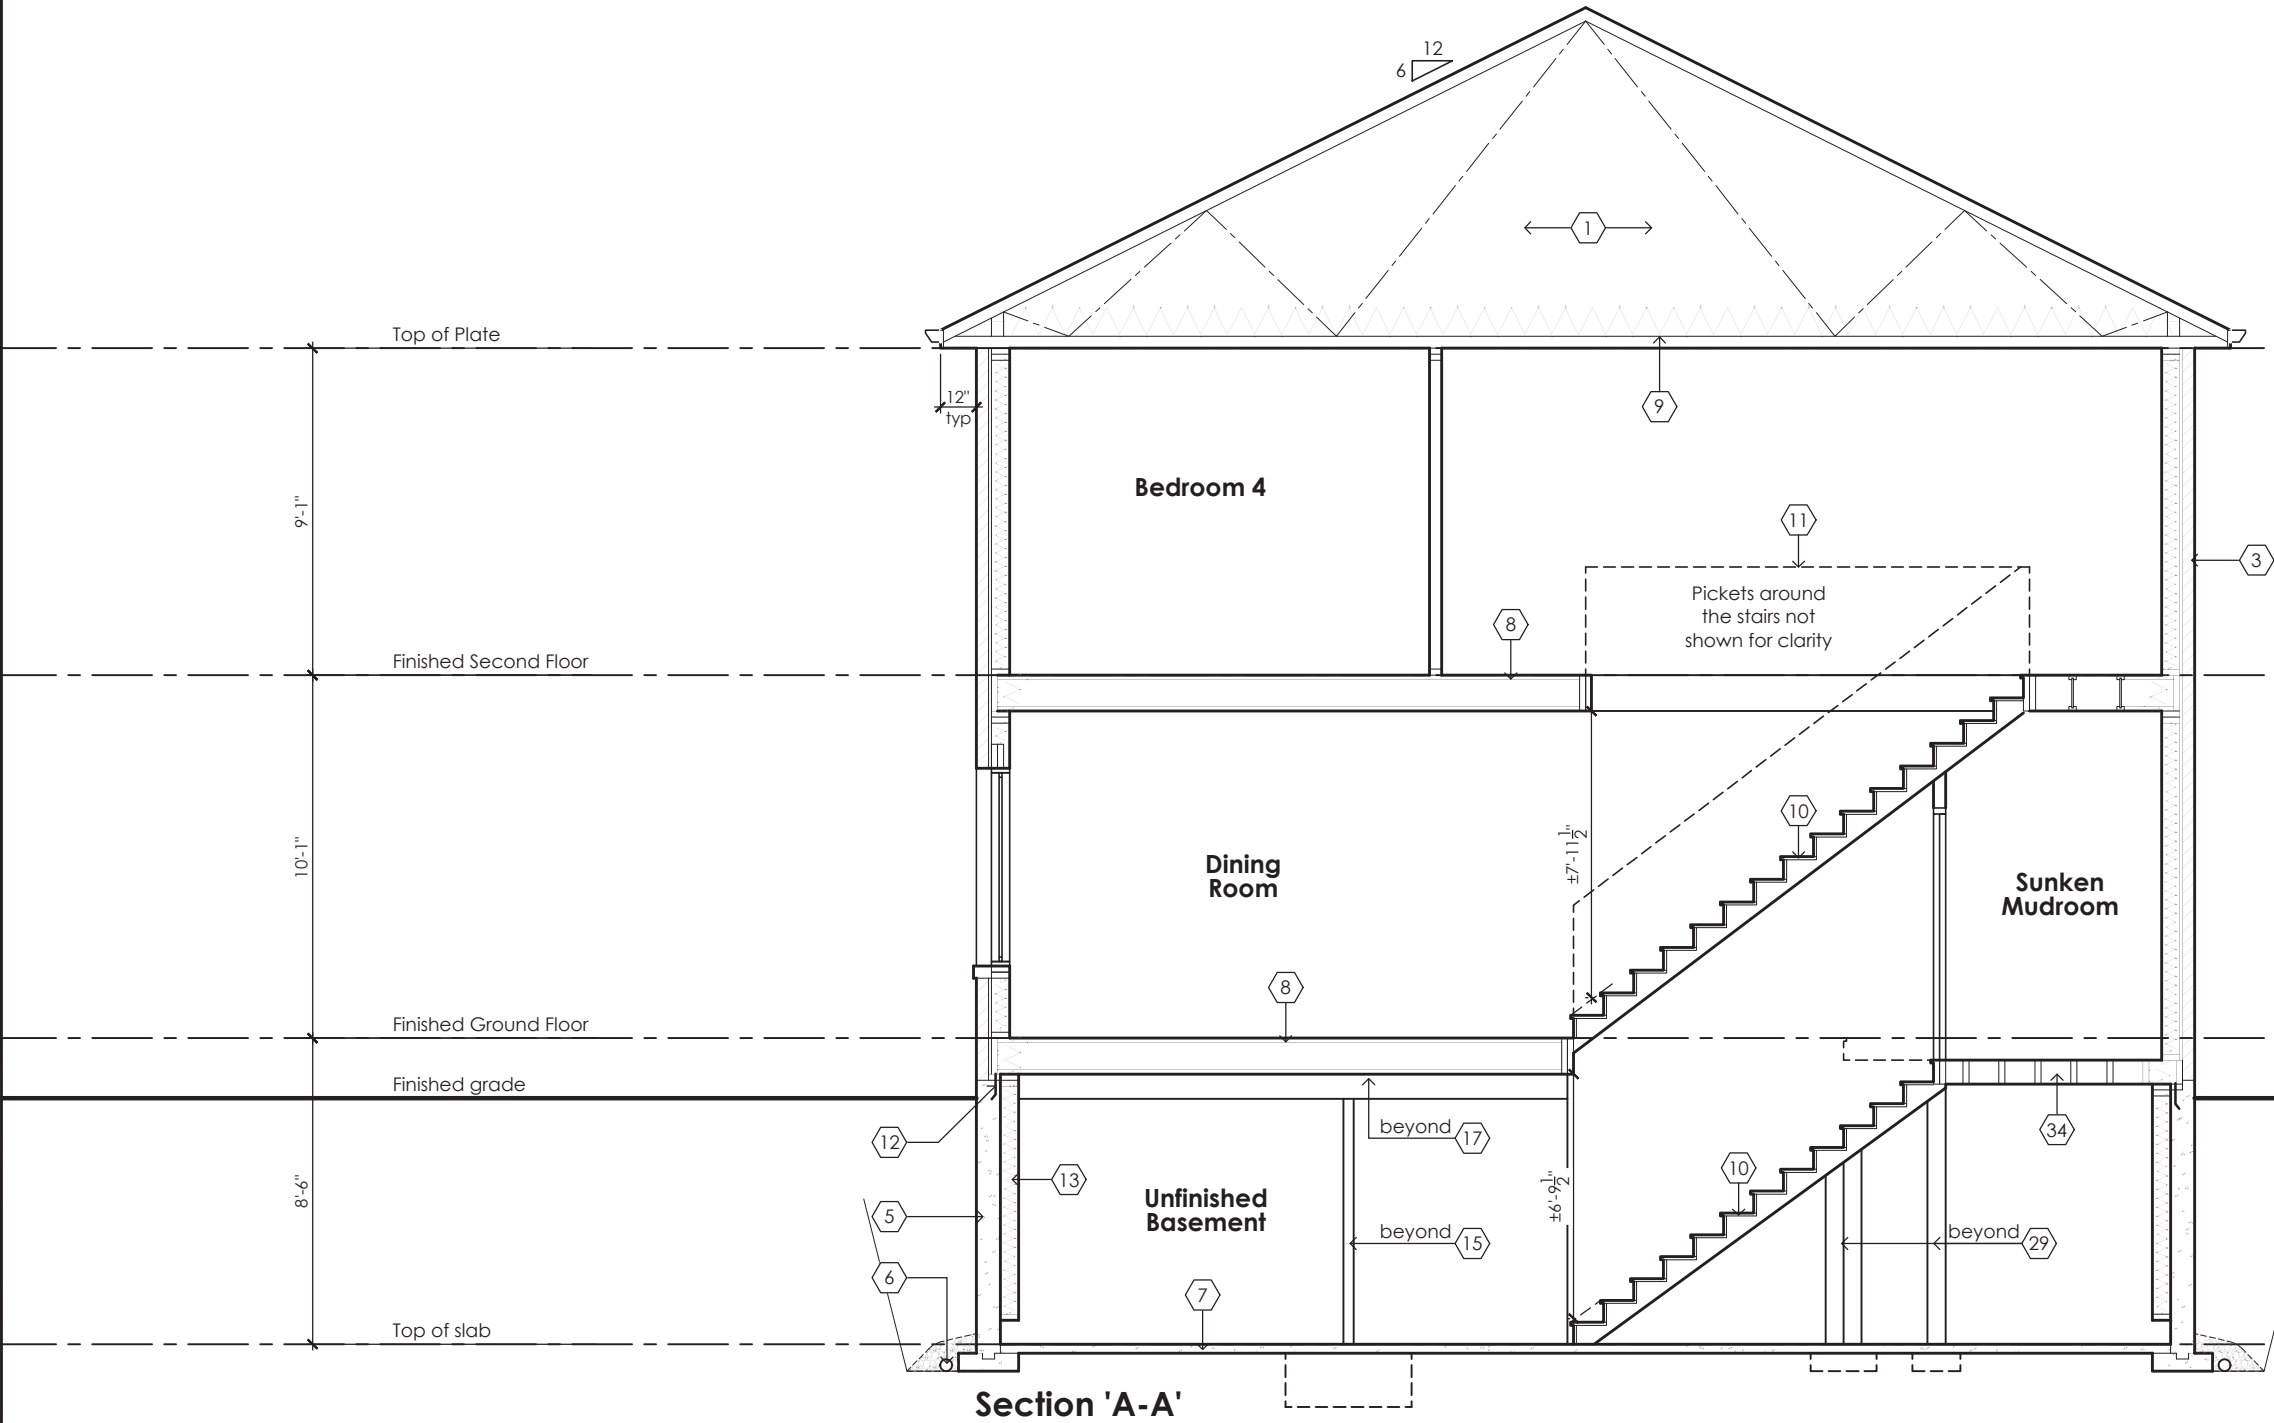

STRUDET INC  
FOR STRUCTURAL ONLY



July 5,2023

Rose 2

Compliance Package A1

Contractor shall check all dimensions and elevations before commencing with work and report any discrepancies to the Designer. Prints are not to be scaled.

The undersigned has reviewed and takes responsibility for this design, as well as having the qualifications and requirements mandated by the Ontario Building Code (O.B.C.) to be a Designer.

**Qualification Information**

Jamie Mack 35923  
Name BCIN Signature  
Registration Information **Mackitecture** 103532

  
**www.mackitecture.ca**  
975A Elgin Street West, Suite 353  
Cobourg, ON K9A 5J3  
Tel: 416-735-8190 Email: info@mackitecture.ca

Building Section Elevations 1, 2 and 3			
scale <b>3/16" = 1'-0"</b>	by <b>JM</b>	area <b>-</b>	sheet no. <b>8-1</b>
date <b>2023-06-30</b>	type <b>40' Single</b>	project no. <b>22-012</b>	

  
**www.greenparkgroup.ca**

project name  
**Zadorra Estates Inc.**

MHP 23028

SB-12 Calculations


Rose 2 - Deck Condition

Elevation	Wall Area	Window Area	Percentage
Front	714.5 sq ft (66.1 sq m)	98.1 sq ft (9.1 sq m)	13.72%
Left side	1097.2 sq ft (101.6 sq m)	60.4 sq ft (5.6 sq m)	5.50%
Right side	1101.6 sq ft (102.3 sq m)	0.0 sq ft (0.0 sq m)	0.00%
Rear	796.0 sq ft (74.0 sq m)	95.4 sq ft (8.9 sq m)	11.98%
Total	3709.3 sq ft (344.6 sq m)	253.8 sq ft (23.6 sq m)	6.84%

It is the builder's complete responsibility to ensure that all plans submitted for approval fully comply with the Architectural Guidelines and all applicable regulations and requirements including zoning provisions and any provisions in the subdivision agreement. The Control Architect is not responsible in any way for examining or approving site (lotting) plans or working drawings with respect to any zoning or building code or permit matter or that any house can be properly built or located on its lot.

This is to certify that these plans comply with the applicable Architectural Design Guidelines approved by the City of Oshawa

JOHN G. WILLIAMS LTD., ARCHITECT  
ARCHITECTURAL CONTROL REVIEW  
AND APPROVAL  
APPROVED BY:   
DATE: JUL 31 2023  
This stamp certifies compliance with the applicable Design Guidelines only and bears no further professional responsibility.

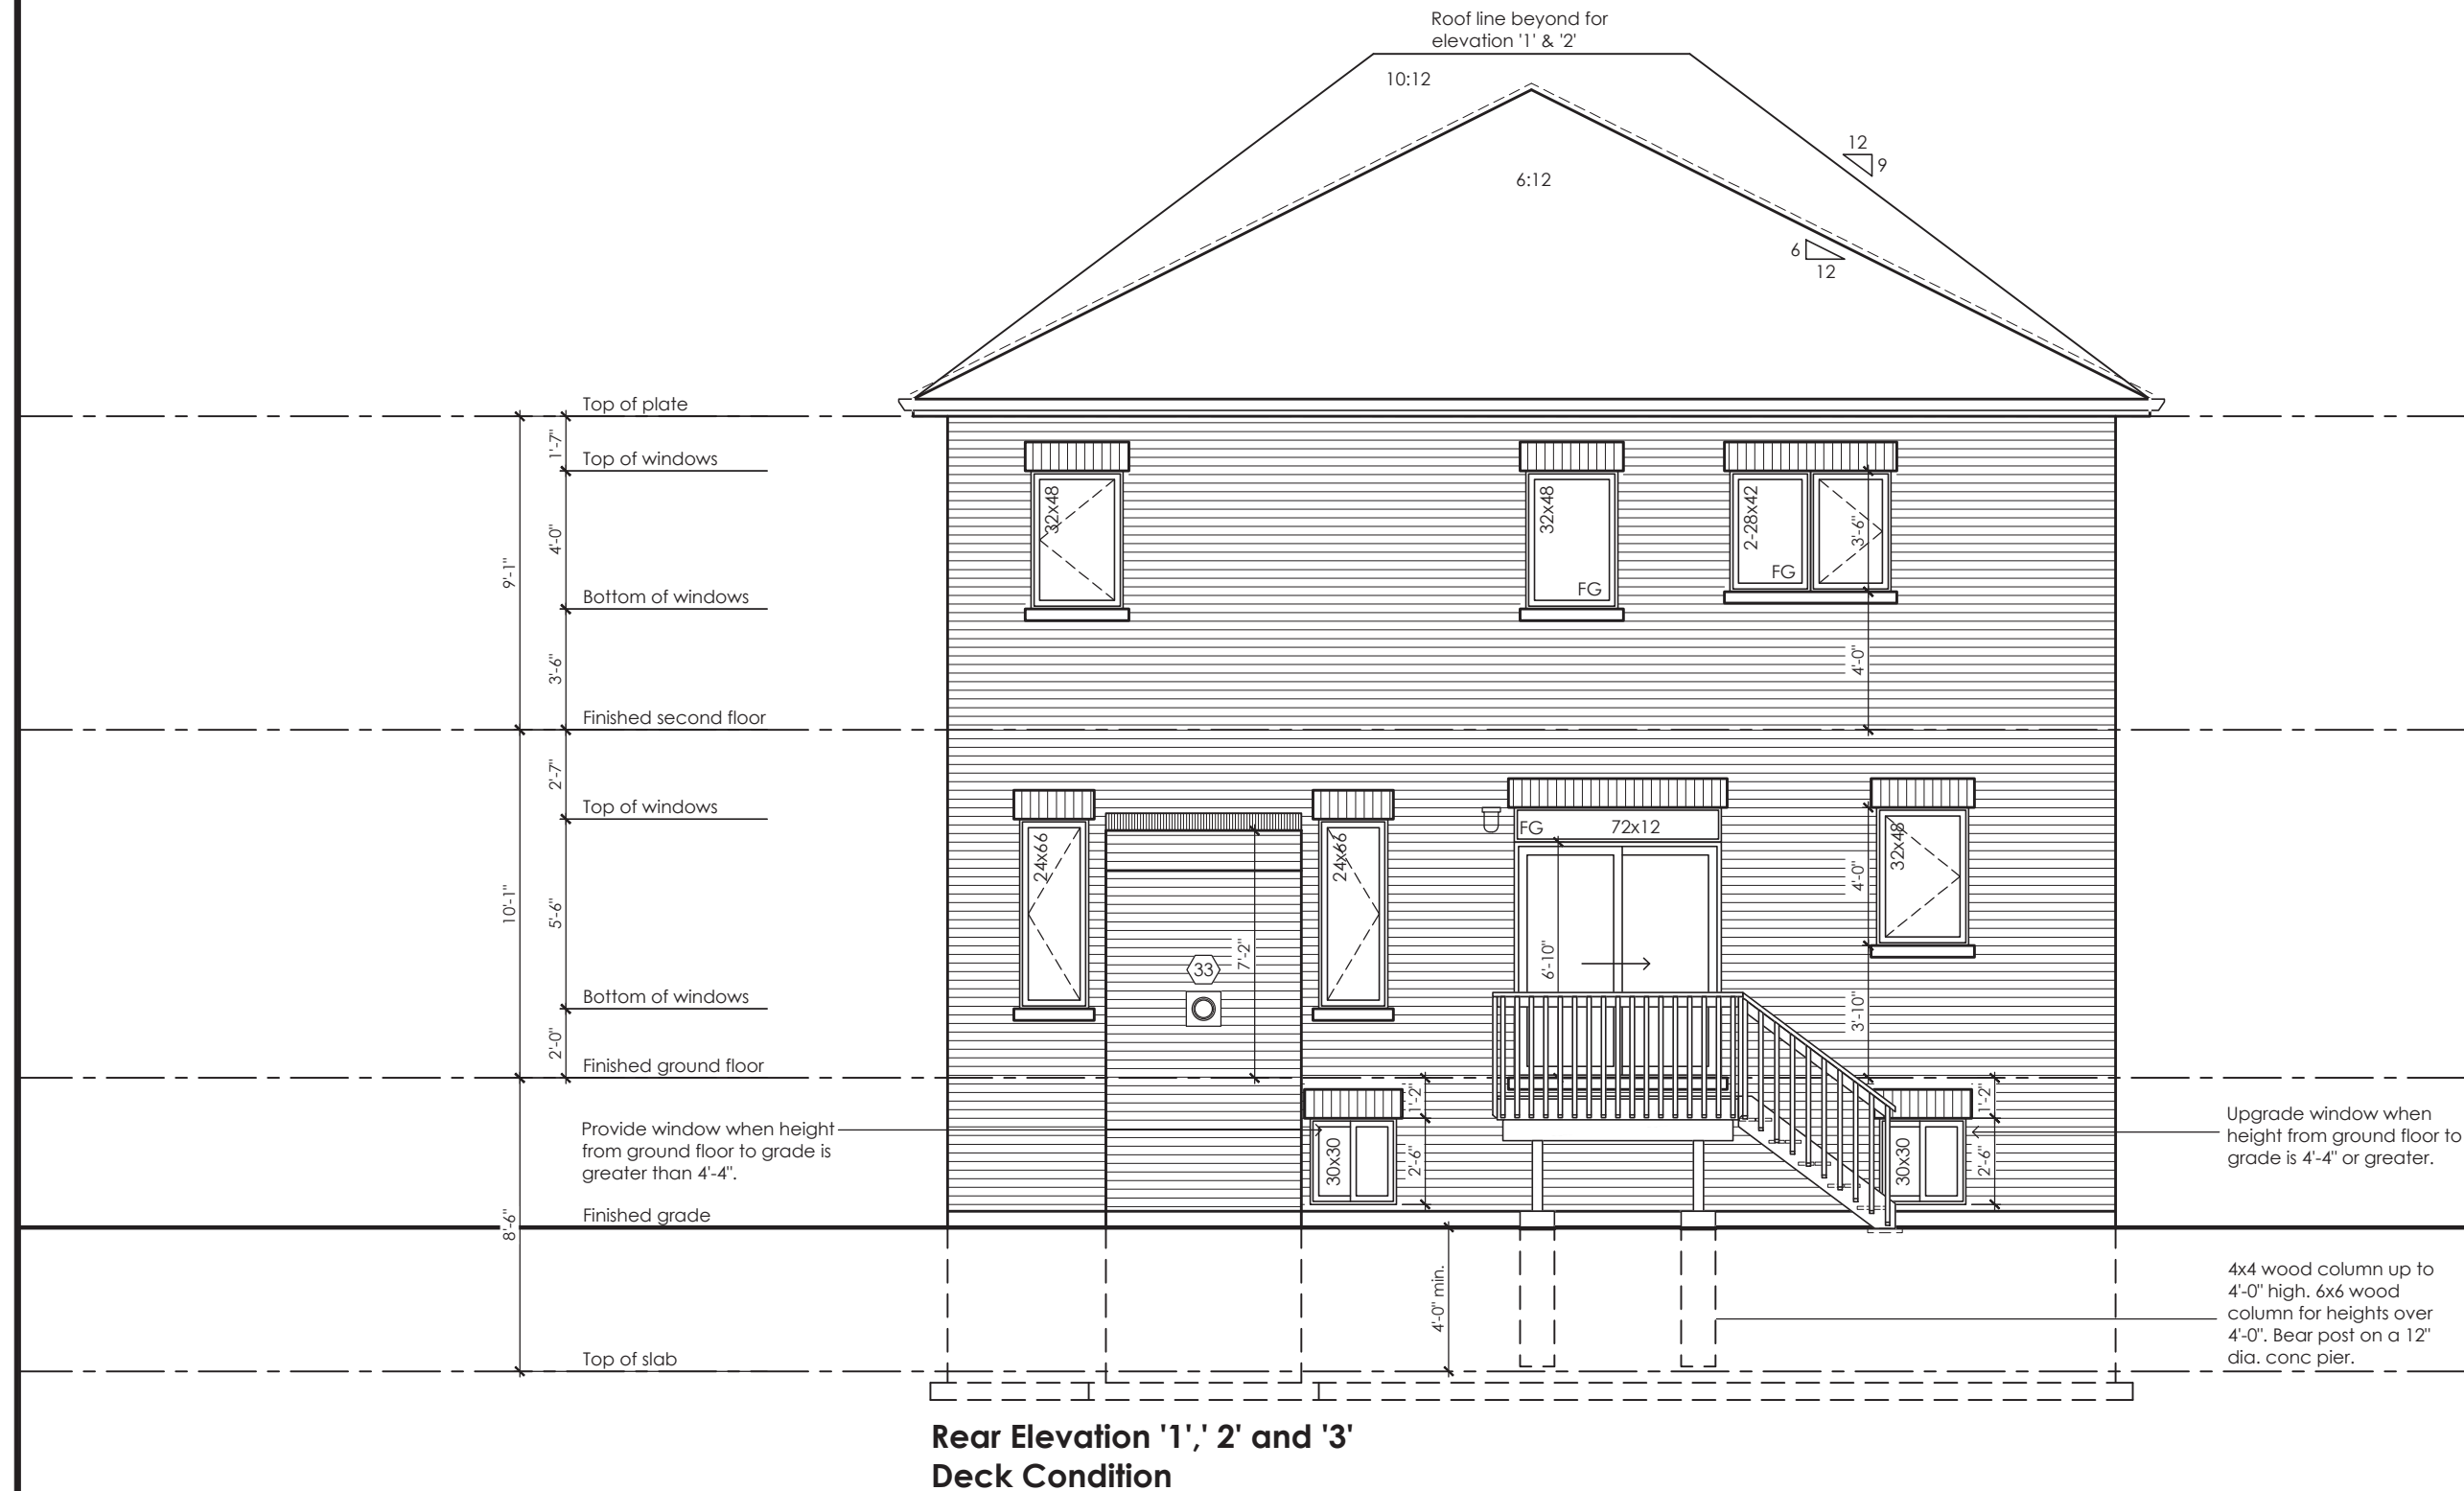

Rose 2

Compliance Package A1

Contractor shall check all dimensions and elevations before commencing with work and report any discrepancies to the Designer. Prints are not to be scaled.	The undersigned has reviewed and takes responsibility for this design, as well as having the qualifications and requirements mandated by the Ontario Building Code (O.B.C.) to be a Designer. <b>Qualification Information</b>		 <b>www.mackitecture.ca</b> 975A Elgin Street West, Suite 353 Cobourg, ON K9A 5J3 Tel: 416-735-8190 Email: info@mackitecture.ca	Title <b>Deck Elevation Elevations 1, 2 and 3</b>			 <b>www.greenparkgroup.ca</b>  project name <b>Zadorra Estates Inc.</b>		
	Jamie Mack Name	35923 BCIN		 Signature	scale <b>3/16" = 1'-0"</b>	by <b>JM</b>		area <b>-</b>	sheet no. <b>9-1</b>
	Registration Information	<b>Mackitecture</b>		103532	date <b>2023-06-30</b>	type <b>40' Single</b>		project no. <b>22-012</b>	


CORPORATION OF THE CITY OF OSHAWA  
TRUE COPY  
OF PERMIT PLANS  
Nov 15 2023  
PER:   
CHIEF BUILDING OFFICIAL

MHP 23028


It is the builder's complete responsibility to ensure that all plans submitted for approval fully comply with the Architectural Guidelines and all applicable regulations and requirements, including zoning provisions and any provisions in the subdivision agreement. The Control Architect is not responsible in any way for examining or approving site (lotting) plans or working drawings with respect to any zoning or building code or permit matter or that any house can be properly built or located on its lot.

This is to certify that these plans comply with the applicable Architectural Design Guidelines approved by the City of OSHAWA.


JOHN G. WILLIAMS LTD., ARCHITECT  
ARCHITECTURAL CONTROL REVIEW  
AND APPROVAL

APPROVED BY:   
DATE: JUL 31, 2023

This stamp certifies compliance with the applicable Design Guidelines only and bears no further professional responsibility.

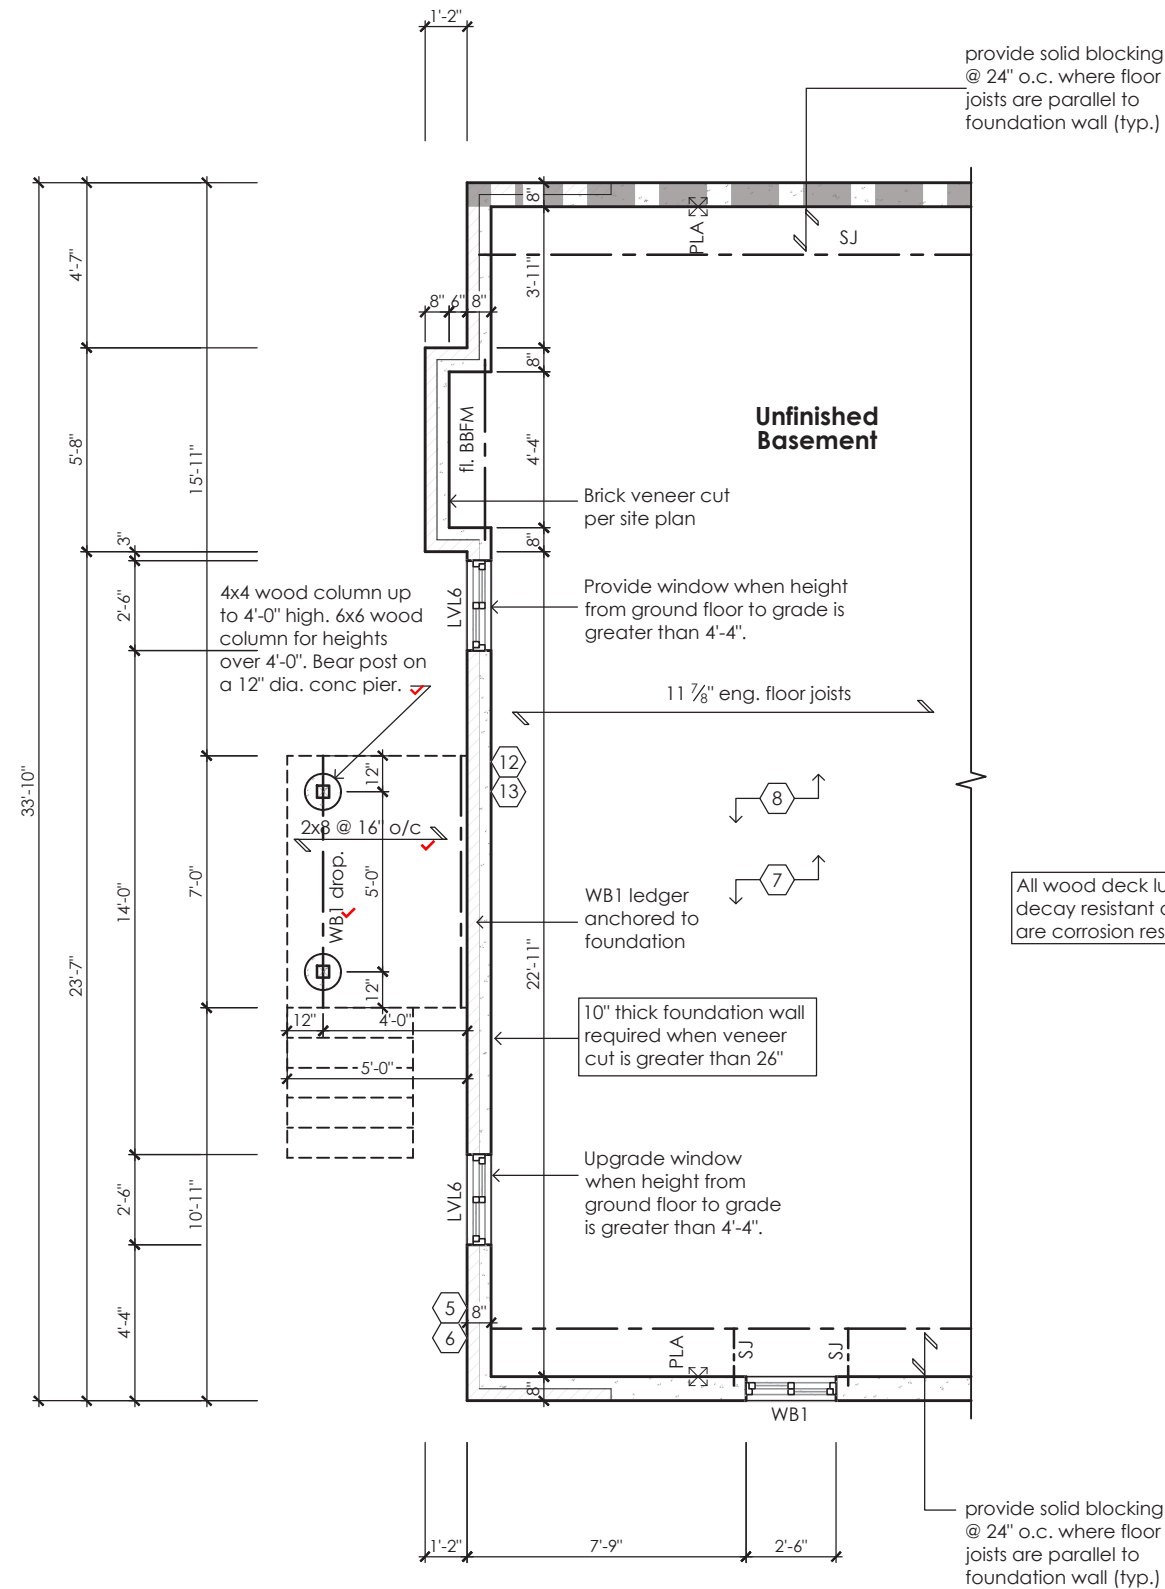

Partial Basement Plan For Deck Condition  
Elevation '1', '2' and '3'

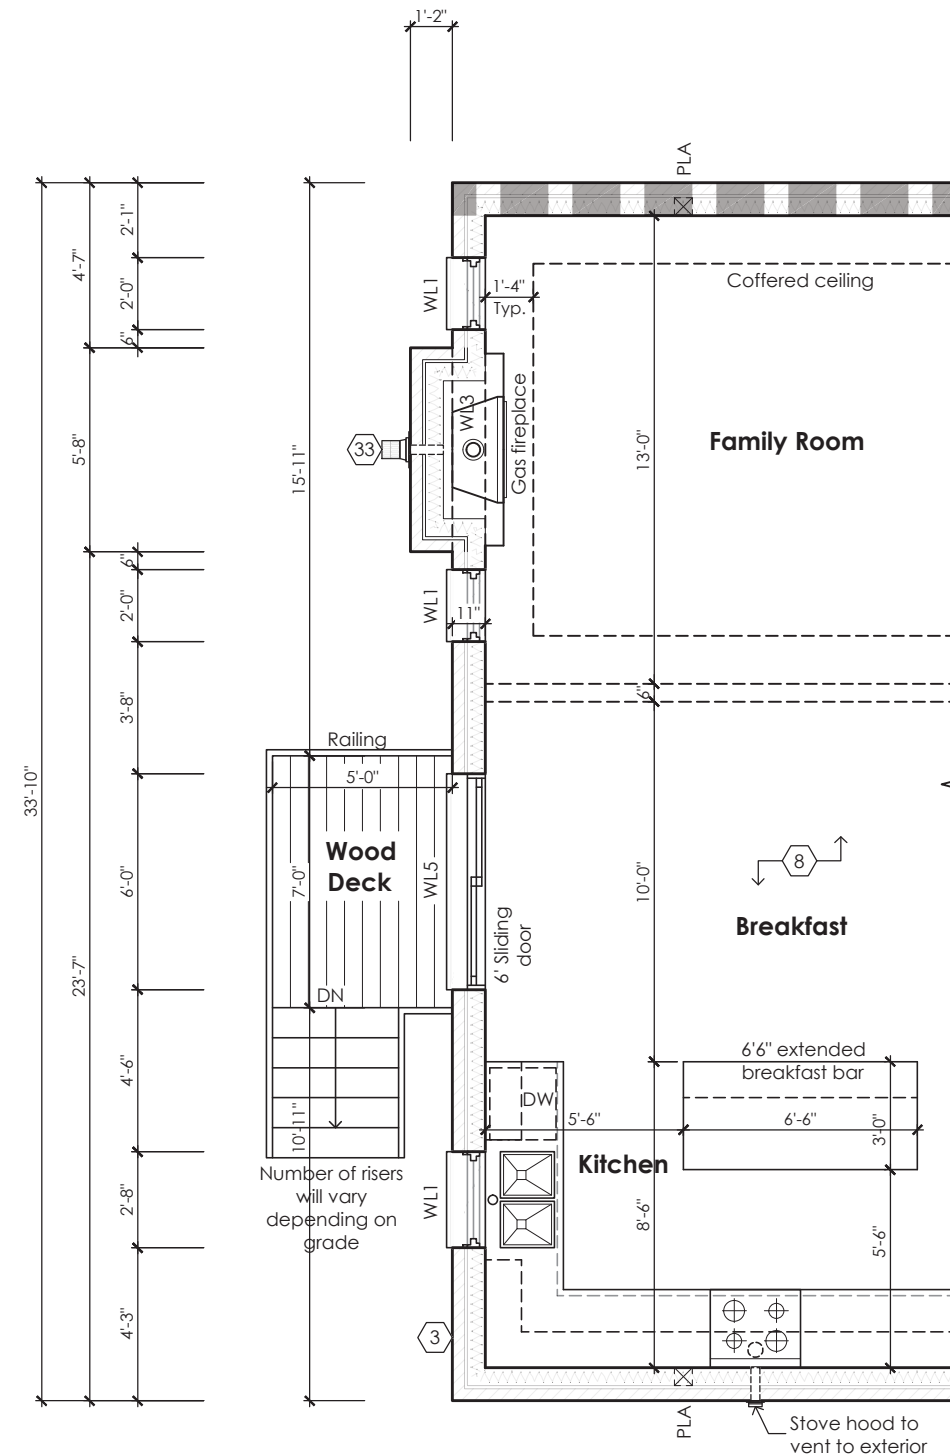

Partial Ground Floor Plan For Deck Condition  
Elevation '1', '2' and '3'

STRUDET INC.  
REGISTERED PROFESSIONAL ENGINEER  
B. MARINKOVIC  
JUL 25, 2023  
PROVINCE OF ONTARIO  
FOR STRUCTURE ONLY

Rose 2  
Compliance Package A1

Contractor shall check all dimensions and elevations before commencing with work and report any discrepancies to the Designer. Prints are not to be scaled.

The undersigned has reviewed and takes responsibility for this design, as well as having the qualifications and requirements mandated by the Ontario Building Code (O.B.C.) to be a Designer.  
**Qualification Information**  
Jamie Mack 35923  
Name BCIN  
Registration Information **Mackitecture** 103532

  
**www.mackitecture.ca**  
975A Elgin Street West, Suite 353  
Cobourg, ON K9A 5J3  
Tel: 416-735-8190 Email: info@mackitecture.ca

**Deck Plans**  
**Elevations 1, 2 and 3**  
scale 3/16" = 1'-0"  
by JM  
area -  
sheet no. 9-2  
date 2023-06-30  
type 40' Single  
project no. 22-012

  
**www.greenparkgroup.ca**  
project name **Zadorra Estates Inc.**

Drawing created with Mackitecture v.1.0.0 (build 2654). File P:\2022\22-012-GREENPARK-ZADORRA-OSHAWA\UNITS\WORKING\22-012-ROSE 2-WD-V1.DWG plotted on 2023-06-30 at 12:53:36 PM by JMACK

Elevation	Wall Area	Window Area	Percentage
Front	714.3 sq ft (1)	98.1 sq ft (9.1 sq m)	13.72%
Left side	1097.2 sq ft (101.6 sq m)	60.4 sq ft (5.6 sq m)	5.50%
Right side	1101.6 sq ft (102.3 sq m)	0.0 sq ft (0.0 sq m)	0.00%
Rear	953.0 sq ft (88.5 sq m)	132.5 sq ft (12.3 sq m)	13.91%
<b>Total</b>	<b>3866.3 sq ft (359.2 sq m)</b>	<b>291.0 sq ft (27.0 sq m)</b>	<b>7.53%</b>

This is to certify that these plans comply with the applicable Architectural Design Guidelines approved by the City of Oshawa

Roof line beyond for elevation '1' & '2'

10:12

6:12

12/9

6/12

32x48

32x48

2-28x42

FG

3'-6"

4'-0"

24x66

33

7'-2"

24x48

24x48

72x12

FG

6'-10"

6' Sliding door

4'-0"

3'-10"

32x48

32x48

5' Sliding door

4'-0" min.

Drawing created with MacJitecture v.1.0.0 (build 2654). File P:\2022\22-012-GREENPARK-ZADORRA-OSHAWA\UNITS\WORKING\22-012-ROSE 2-WD-V1.DWG plotted on 2023-06-30 at 12:53:37 PM by JMACK

MHP 23028

This is to certify that these plans comply with the applicable Architectural Design Guidelines approved by the City of OSHAWA.

1'-2"

10" thick foundation wall required when veneer cut is greater than 26"

Brick veneer cut per site plan

5 6  
12 13

provide solid blocking @ 24" o.c. where floor joists are parallel to foundation wall (typ.)

33'-10"

5'-8" 2'-1" 2'-0" 6" 15'-11"

6x6 wood column. Bear post on a 12" dia. conc pier. As required provide diagonal bracing per elevation.

3

WL1

3'-9" 11" 3'-10" 11"

10" thick foundation wall below the brick veneer and 2x6 stud wall

Unfinished Basement

5" Sliding door

WB1 ledger anchored to LVL

2 - 1 3/4" x 9 1/2" LVL beam below top plate full width of deck with double stud below.

11 7/8" eng. floor joists

2x8 @ 16" o/c

WB1 rim joist all around

WB1 drop.

6'-0" 6" 4'-0" 5'-0"

LVL4 + L3

23'-7"

5'-0" 7'-0" 4'-2" 2'-0" 6" 10'-11" 2'-8" 4'-3" 5'-0"

10" thick foundation wall below the brick veneer and 2x6 stud wall

Remove window for walkout rear condition

1'-2"

provide solid blocking @ 24" o.c. where floor joists are parallel to foundation wall (typ.)

8 7

All wood decay resistant are corrosion

[illegible]

STRUDET INC.

REGISTERED PROFESSIONAL ENGINEER

*[Signature]*

B. MARINKOVIC

May 5, 2023

PROVINCE OF ONTARIO

FOR STRUCTURE ONLY

## Rose 2

### Compliance Package A1

project name

**Zadorra Estates Inc.**

Drawing created with Mackitecture v.1.0.0 (build 2654), File P:\2022\22-012-GREENPARK-ZADORRA-OSHAWA\UNITS\WORKING\22-012-ROSE 2-WD-V1.DWG plotted on 2023-06-30 at 12:53:38 PM by JMACK