

CONSTRUCTION SUMMARY
Legacy Hill - Trinigroup Development Inc.
PURCHASERS: Francis CHO and Cindy Man Nga CHO
TEL:

LOT / PHASE 30 / 1	REG. PLAN #	HOUSE TYPE Rose 6 Elev 2 (4 Bedroom)		
-----------------------	-------------	---	--	--

CONSTRUCTION

1 - MASTER ENSUITE - FLIP TOILET AND RELOCATE TO WINDOW. FLIP WATER CLOSET DOOR SWING AND MOVE DOWN. ROTATE FREE STANDING TUB AND RELOCATE AS SHOWN. 17Apr24 Note: REFER TO PURCHASER ALTERATION FORM SKETCH	NEW	
1 - LOWER LEVEL - BASEMENT 8 FOOT 6 INCH CONCRETE POUR - MEASURED FROM TOP OF FOOTING TO TOP OF FOUNDATION WALL 15Nov23 Note:		
2 - ENLARGED BASEMENT WINDOWS (MAY REQUIRE WINDOW WELLS) - WINDOW IS 30 INCHES X 24 INCHES 15Nov23 Note:		
1 - FIRST FLOOR INCREASE CEILING HEIGHT FROM 9 FEET TO 10 FEET 15Nov23 Note:		

PLUMBING

1 - MASTER ENSUITE - FLIP TOILET AND RELOCATE TO WINDOW. ROTATE FREE STANDING TUB AND RELOCATE AS SHOWN. 17Apr24 Note: REFER TO PURCHASER ALTERATION FORM SKETCH	NEW	
--	-----	--

PROMOTIONAL

1 - LESS CREDIT FROM PURCHASER EXTRA SHEET IN OFFER 15Nov23 Note:		
--	--	--

EXTRAS AS PER OFFER

The Vendor agrees that notwithstanding any other term or provision in this Agreement included in the Purchase Price and in addition to those items detailed in Schedule GP to the Agreement of Purchase and Sale, the Purchaser is entitled to a credit of Ten Worksheet Note:	
---	--

This Document is Extremely Time Sensitive - Printed 17 Apr 24 at 16:16

CONS + PLUMBING

RECEIVED
APR 18 2024


PURCHASER ALTERATION FORM

LOT 30
TRINIGROUP
LEGACY HILL
CITY OF RICHMOND HILL

ROSE 6
ELEVATION 2

REVISIONS:

- FLIP TOILET AND RELOCATE TO WINDOW.
- FLIP WATER CLOSET DOOR SWING AND MOVE DOWN.
- ROTATE FREE STANDING TUB AND RELOCATE AS SHOWN.

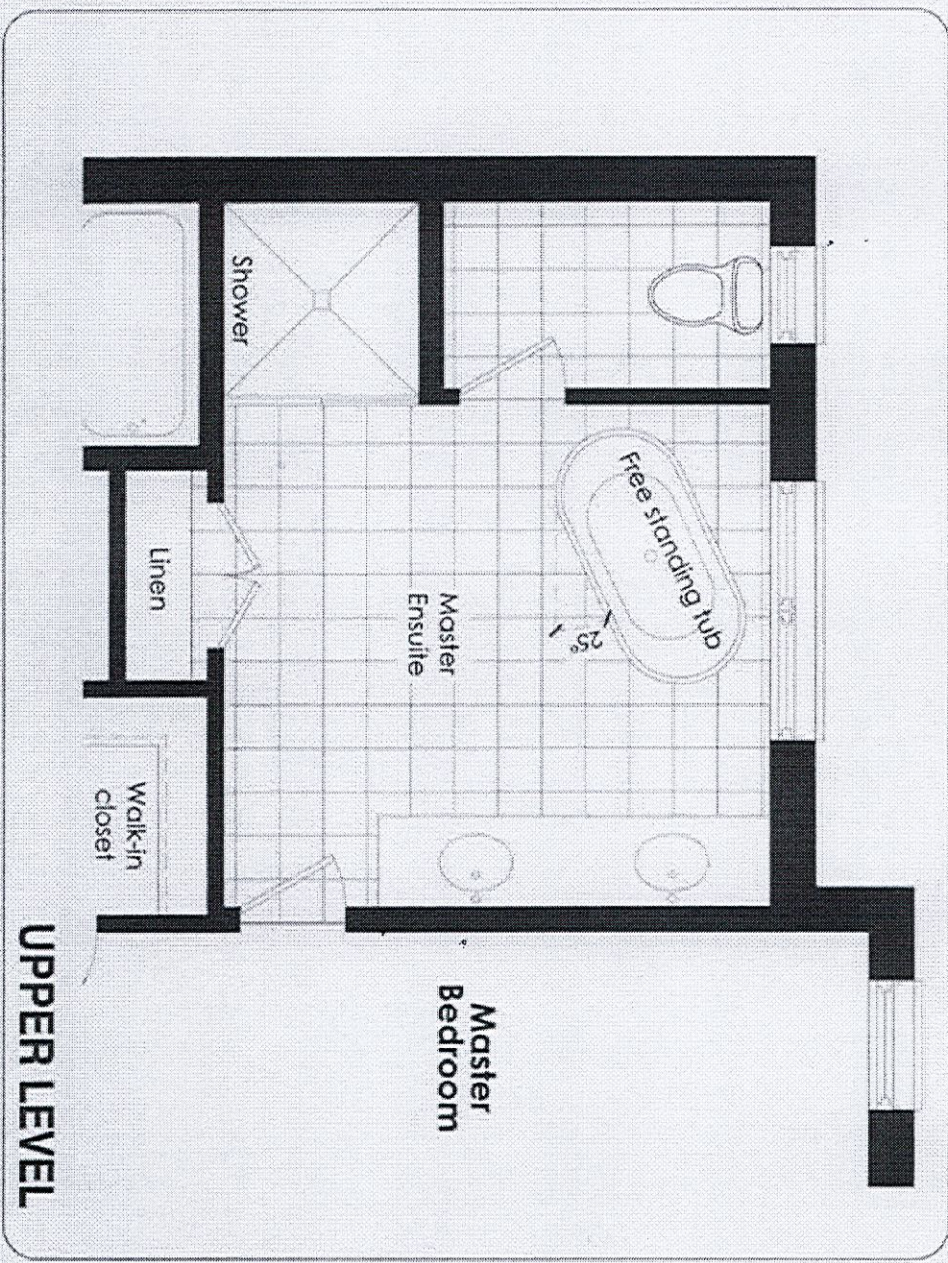

DISCLAIMER: SKETCH NOT TO SCALE. DIMENSIONS, SPECIFICATIONS AND ARCHITECTURAL DETAILS SUBJECT TO MODIFICATION BY THE VENDOR. SKETCH IS ONLY FOR THE PURPOSES OF ILLUSTRATING REVISIONS REQUESTED BY THE PURCHASER AND ALL DECISIONS ARE SUBJECT TO VENDOR'S FINAL APPROVAL. ONLY REVISIONS ACCEPTED IN WRITING BY THE PURCHASER AND VERIFIED ON A PURCHASER'S EXTRA SHEET WILL BE INCORPORATED INTO THE PLANS FILED WITH THE MUNICIPALITY. E. & O.E.

REVISION NO.

DATE

Greenpark.

For City of Richmond Hill