Greenpark.

STRUCTURAL PRELIMINARY

PURCHASER: SU XIAN ZHENG			TEL:
LOT / PHASE	REG. PLAN #	HOUSE TYPE	

CONSTRUCTION SUMMARY
Legacy Hill - Trinigroup Development Inc.

CONSTRUCTION

3 - ENLARGED BASEMENT WINDOWS (MAY REQUIRE WINDOW WELLS) - WINDOW IS 30 INCHES X 24 INCHES 09May24 Note:

PROMOTIONAL |

1 - PARTIAL REDEMTION OF PROMOTIONAL PACKAGE \$1,950.00. BALANCE FORWARD \$38,050.00 TO BE USED AT A LATER DATE. ORIGINAL PROMOTIONAL PACKAGE OF \$40,000.00 AS PER SCHEDULE PE. 09May24 Note:


EXTRAS AS PER OFFER

The Vendor agrees that notwithstanding any other term or provision in this Agreement included in the Purchase Price and in addition to those items detailed in Schedule GP to the Agreement of Purchase and Sale, the Purchaser is entitled to a credit of For *Worksheet* Note:

10 foot ceiling height on Main Floor. The Purchaser acknowledges that as a result of the increased ceiling height from the Vendor?s standard ceiling height, various modifications to the interior and exterior of the dwelling unit may be made, including bu *Worksheet* Note:

This Document is Extremely Time Sensitive - Printed 10 May 24 at 15:20

RECEIVED
MAY 1 3 2024

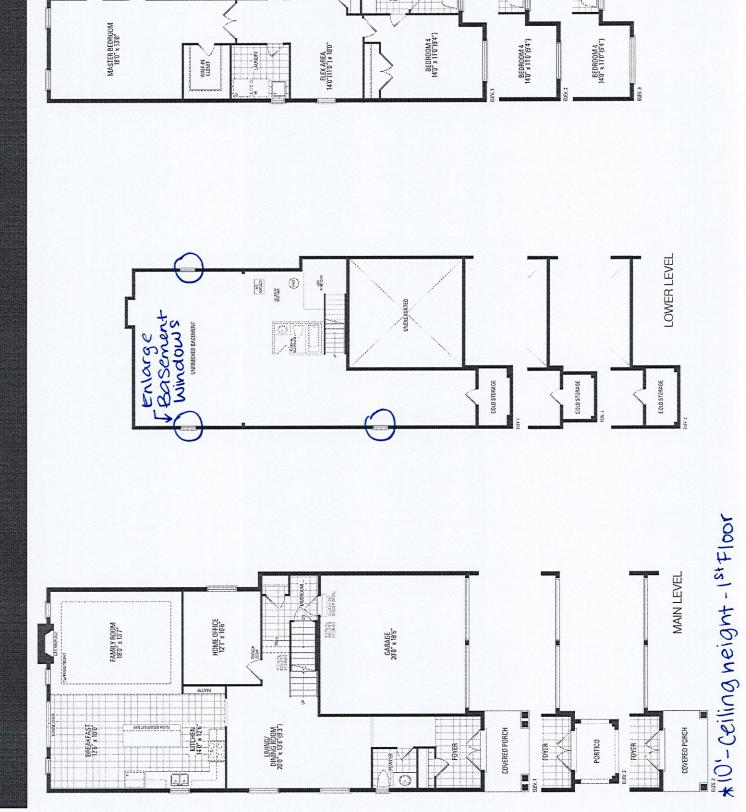

UPPER LEVEL

BEOROOM3 13'0" x 11'0"

BEDROOM 3

BEDROOM3 12.0" x 11.0"

WALES

BEDROOM 2 129" x 120"

WALK-P.