

PURCHASER: Binghui ZHANG		CONSTRUCTION SUMMARY Legacy Hill - Trinigroup Development Inc.		RECEIVED MAY 14 2024		TEL:	
--------------------------	--	---	--	-------------------------	--	------	--

LOT / PHASE 61 / 1	REG. PLAN #	HOUSE TYPE Rose 5 Elev 2 (5 Bedroom)		
-----------------------	-------------	---	--	--

CONSTRUCTION

1 - FIRST FLOOR INCREASE CEILING HEIGHT FROM 9 FEET TO 10 FEET 11Oct23 Note:	
---	--

ELECTRICAL

1 - RELOCATE STANDARD KITCHEN LIGHT TO BE CENTERED OVER ISLAND 13May24 Note:	
---	--

PROMOTIONAL

1 - LESS CREDIT FROM PURCHASER EXTRA SHEET IN OFFER 11Oct23 Note:	
--	--

EXTRAS AS PER OFFER

The Vendor agrees that notwithstanding any other term or provision in this Agreement included in the Purchase Price and in addition to those items detailed in Schedule GP to the Agreement of Purchase and Sale, the Purchaser is entitled to a credit of Ten Worksheet Note:	
---	--







This Document is Extremely Time Sensitive - Printed 13 May 24 at 15:08

Rose 5 40' Lot

Elev. 1: 3,357 sq.ft. Elev. 2: 3,337 sq.ft. Elev. 3: 3,339 sq.ft.

LOT #61

Relocate.
Sta. light
above island

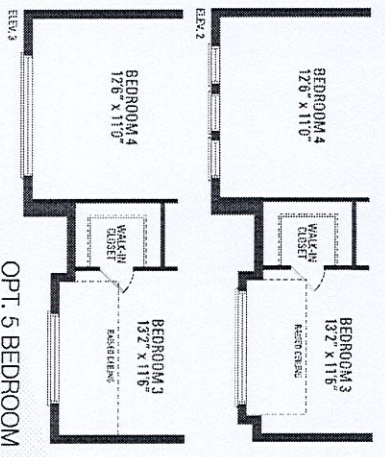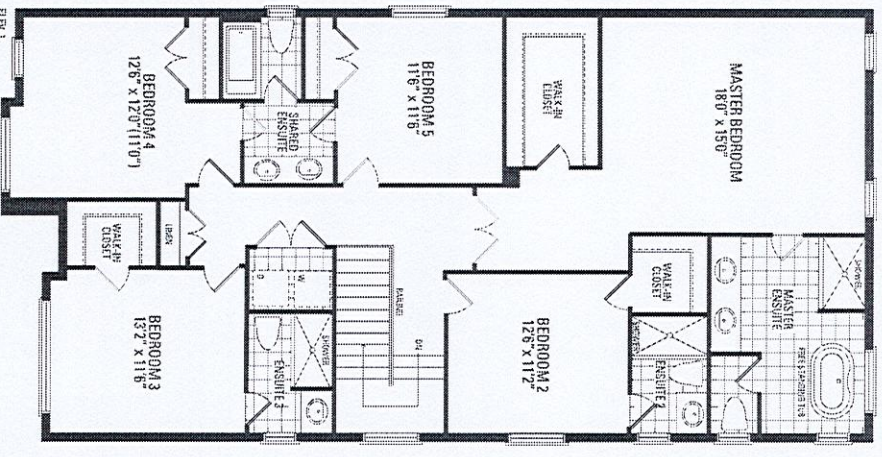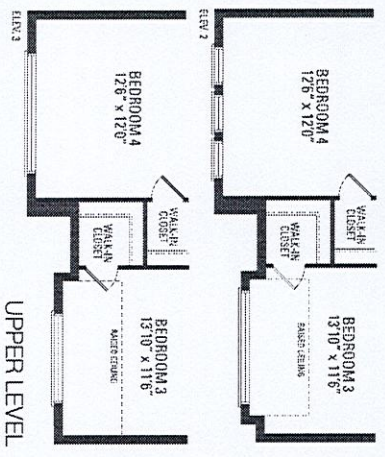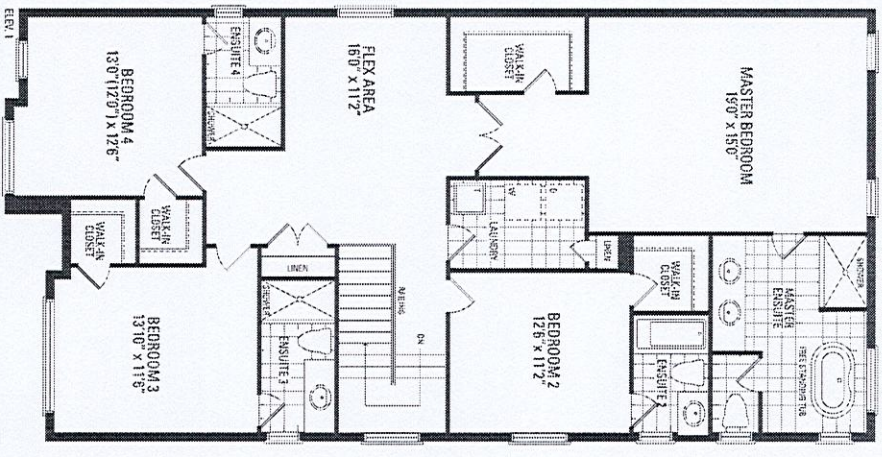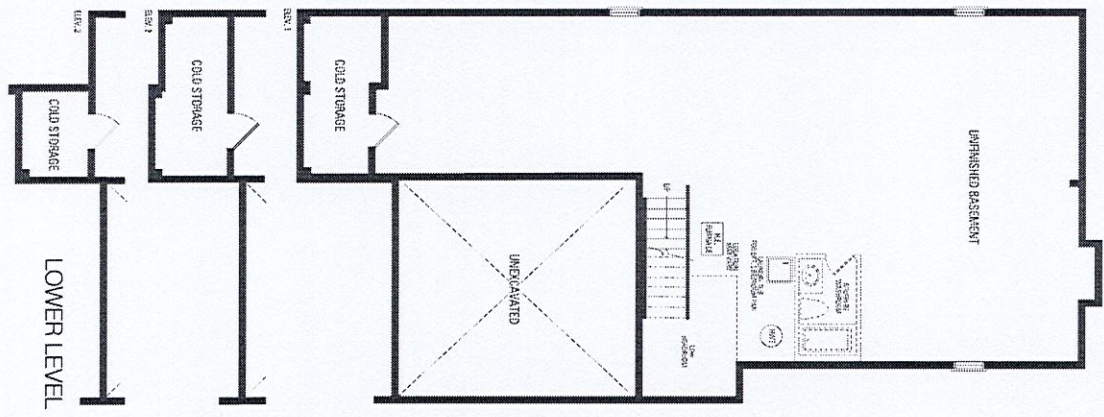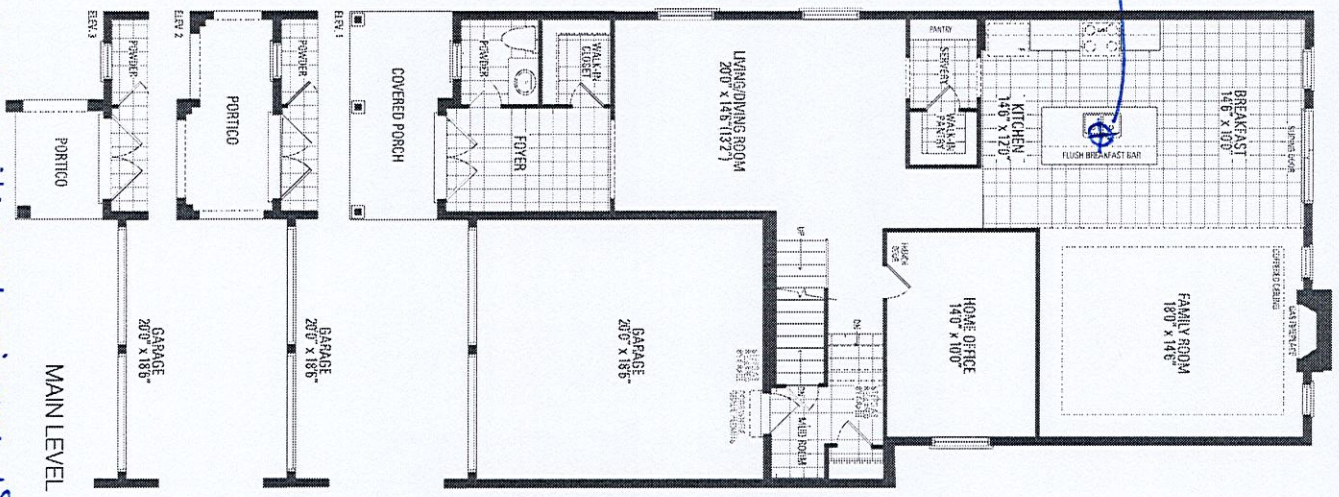

*10'-ceiling height-1st Floor