

CONSTRUCTION SUMMARY		RECEIVED	
Legacy Hill - Trinigroup Development Inc.		MAY 17 2024	
PURCHASER: Guang Hong WEI		TEL:	
LOT / PHASE	REG. PLAN #	HOUSE TYPE	
72 / 1		Rose 5 Elev 2 (5 Bedroom)	

CONSTRUCTION

1 - ENLARGED BASEMENT WINDOWS (MAY REQUIRE WINDOW WELLS) - WINDOW IS 30 INCHES X 24 INCHES 18Oct23 Note:	
---	--

PLUMBING

1 - TUB TO SHOWER CONVERSION - 5 FOOT SHOWER WITH SLIDING GLASS CHROME DOORS IN LIEU OF TUB INCLUDES SHOWER POT LIGHT 16May24 Note: SHARED ENSUITE 4/5	
---	--

PROMOTIONAL

1 - PARTIAL REDEMPTION OF PROMOTIONAL PACKAGE \$3,500.00. BALANCE FORWARD \$5,850.00 TO BE USED AT A LATER DATE. ORIGINAL PROMOTIONAL PACKAGE OF \$10,000.00 AS PER SCHEDULE PE. 16May24 Note:	
1 - PARTIAL REDEMPTION OF PROMOTIONAL PACKAGE \$650.00. BALANCE FORWARD \$9,350.00 TO BE USED AT A LATER DATE. ORIGINAL PROMOTIONAL PACKAGE OF \$10,000.00 AS PER SCHEDULE PE. 18Oct23 Note:	

EXTRAS AS PER OFFER

The Vendor agrees that notwithstanding any other term or provision in this Agreement included in the Purchase Price and in addition to those items detailed in Schedule GP to the Agreement of Purchase and Sale, the Purchaser is entitled to a credit of Ten Worksheet Note:	
---	--



This Document is Extremely Time Sensitive - Printed 16 May 24 at 11:33




# Rose 5 40' Lot

Elev. 1: 3,357 sq.ft. Elev. 2: 3,337 sq.ft. Elev. 3: 3,339 sq.ft.

LOT #72

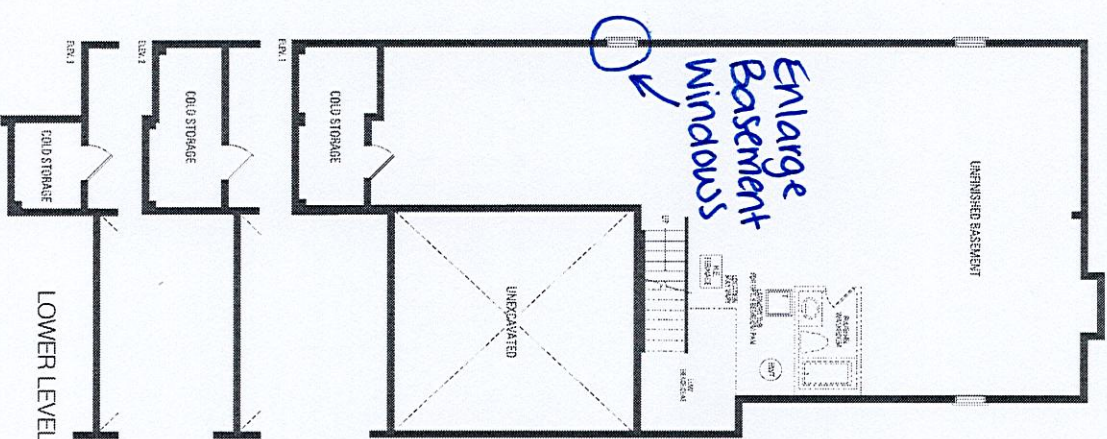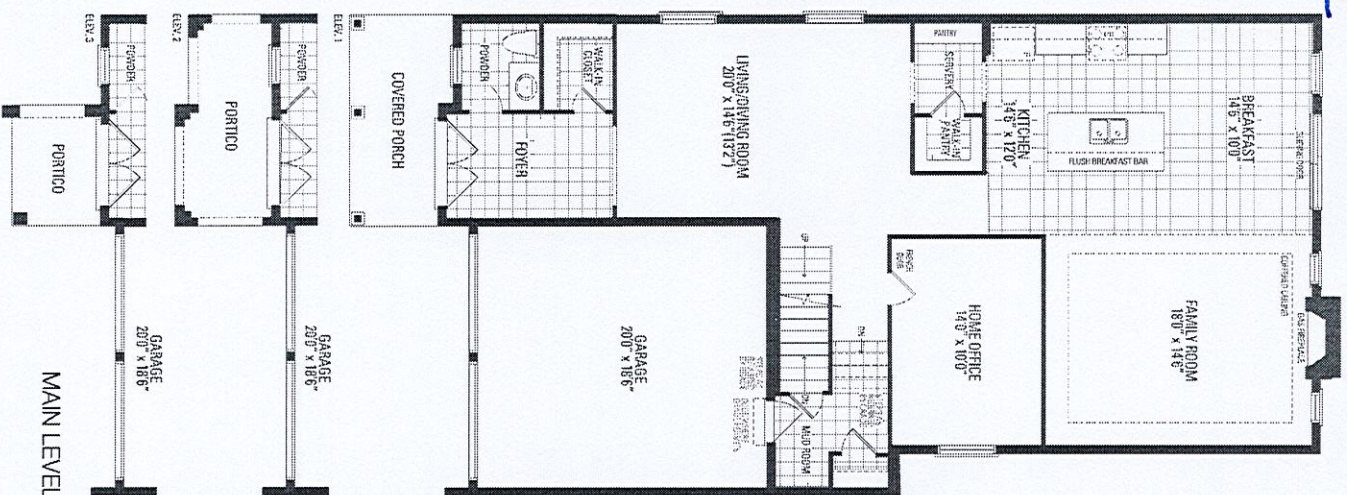

Enlarge Basement Windows

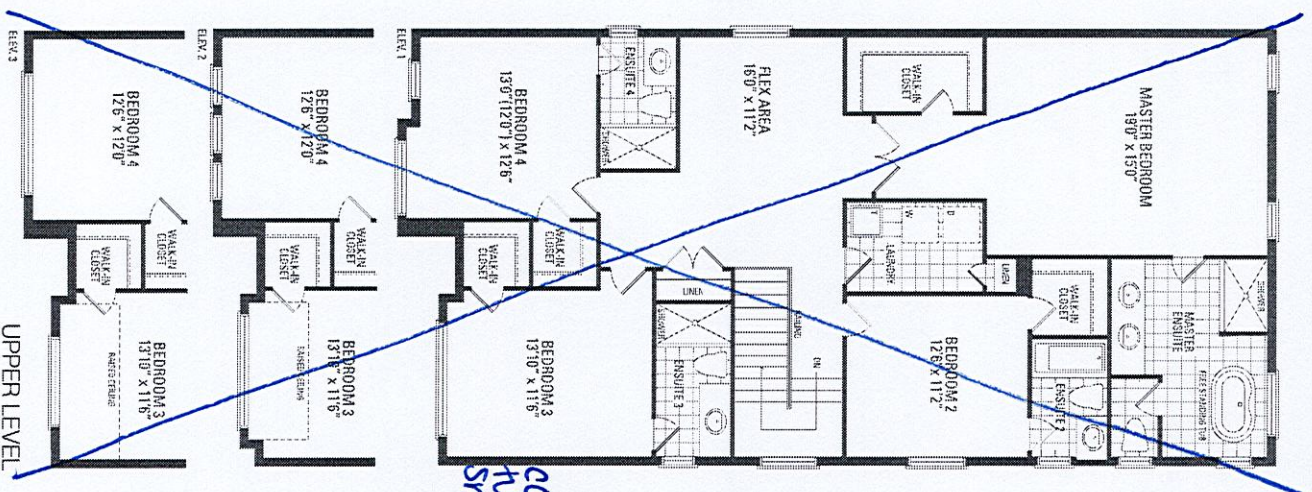

corner studio space

