



CONSTRUCTION SUMMARY - PARTIAL ONLY
Legacy Hill - Trinigroup Development Inc.

PURCHASERS: Jin BAI and Yi Se PAN TEL:

LOT NUMBER	PHASE	HOUSE TYPE	REG. PLAN #		
35	1	Rose 5 Elev 1 (5 Bedroom)			
INV#	QTY	EXTRA / CHANGE			

Offer	Note:	RECEIVED JUL 26 2024
-------	-------	-------------------------



ELECTRICAL

29,919 18Jul24	1 - ELECTRIC VEHICLE ROUGH-IN PROVISION ONLY FOR FUTURE ELECTRIC CAR (CONDUIT FROM BASEMENT INTO JUNCTION BOX IN GARAGE WITH PULL STRING, NO WIRE) Note:	★ ★ NEW ★ ★
29,821 16May24	1 - KITCHEN - PLUG - ELECTRICAL PLUG - ADD TO ISLAND Note:	
29,821 16May24	1 - PLUG - ELECTRICAL PLUG - TO BE INSTALLED OVER FIREPLACE Note:	
29,821 16May24	4 - FAN - BATHROOM EXHAUST FAN - ENERGY STAR 80 CFM - IN LIEU OF STANDARD FAN MASTER ENSUITE, ENSUITE 2, ENSUITE 3 & SHARED ENSUITE 4/5 Note:	
29,821 16May24	6 - FAMILY ROOM - POT LIGHT - LED - FIRST FLOOR INSTALLATION NoteDELETE STANDARD CEILING LIGHT	
29,821 16May24	4 - BREAKFAST AREA - POT LIGHT - LED - FIRST FLOOR INSTALLATION NoteSTANDARD LIGHT ON SEPARATE SWITCH	
29,821 16May24	6 - KITCHEN - POT LIGHT - LED - FIRST FLOOR INSTALLATION NoteSTANDARD LIGHT ON SEPARATE SWITCH	
29,821 16May24	1 - KITCHEN - RELOCATE STANDARD KITCHEN LIGHT TO BE CENTERED OVER ISLAND Note:	
29,821 16May24	4 - DINING ROOM - POT LIGHT - LED - FIRST FLOOR INSTALLATION NoteSTANDARD LIGHT ON SEPARATE SWITCH	
29,821 16May24	4 - LIVING ROOM - POT LIGHT - LED - FIRST FLOOR INSTALLATION NoteSTANDARD LIGHT ON SEPARATE SWITCH	
29,821 16May24	3 - SWITCH - DIMMER SWITCH IN LIEU OF EXISTING SWITCH - PRICE IS EACH NoteFOR POT LIGHTS FAMILY ROOM, LIVING ROOM & DINING ROOM	

This Document is Extremely Time Sensitive - Printed 18 Jul 24 at 10:13

Rose 5 40th Lot

Elev. 1: 3,357 sq.ft. Elev. 2: 3,337 sq.ft. Elev. 3: 3,339 sq.ft.

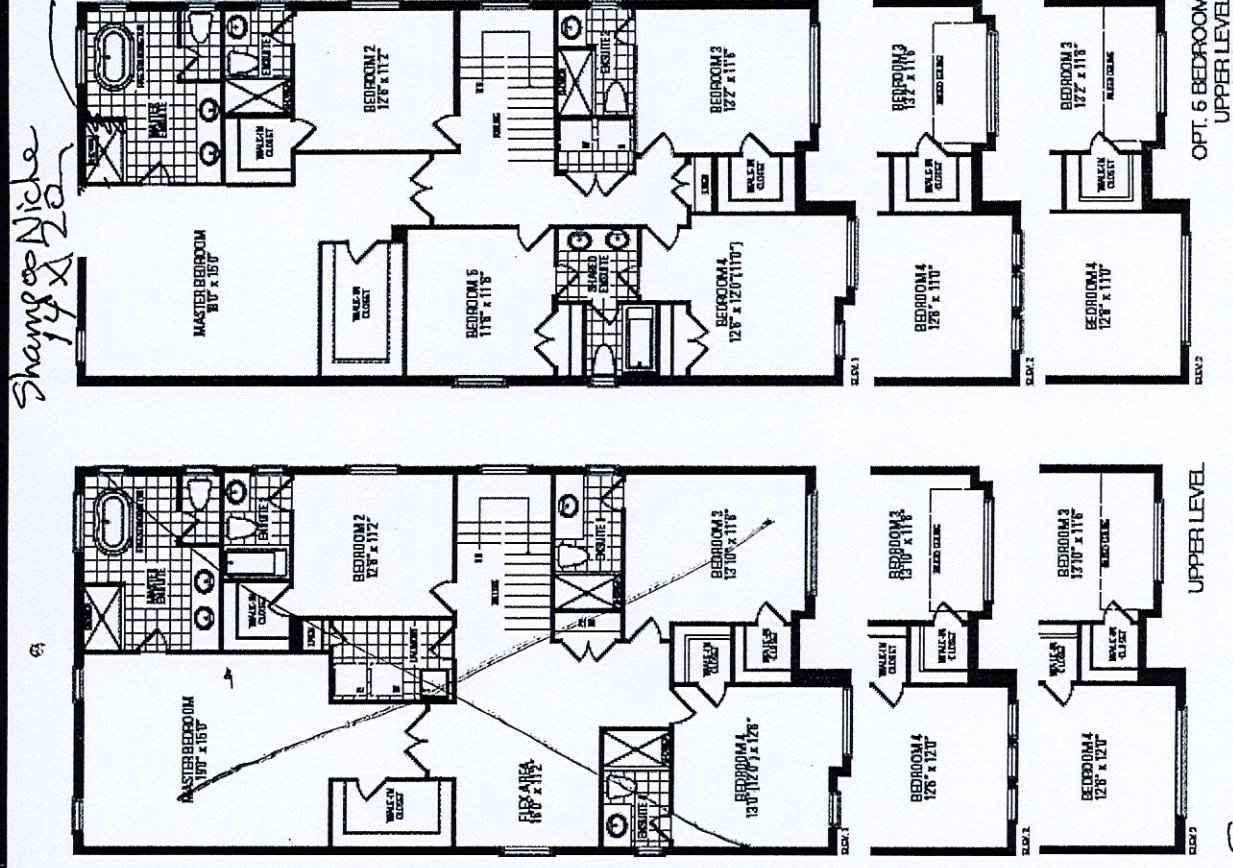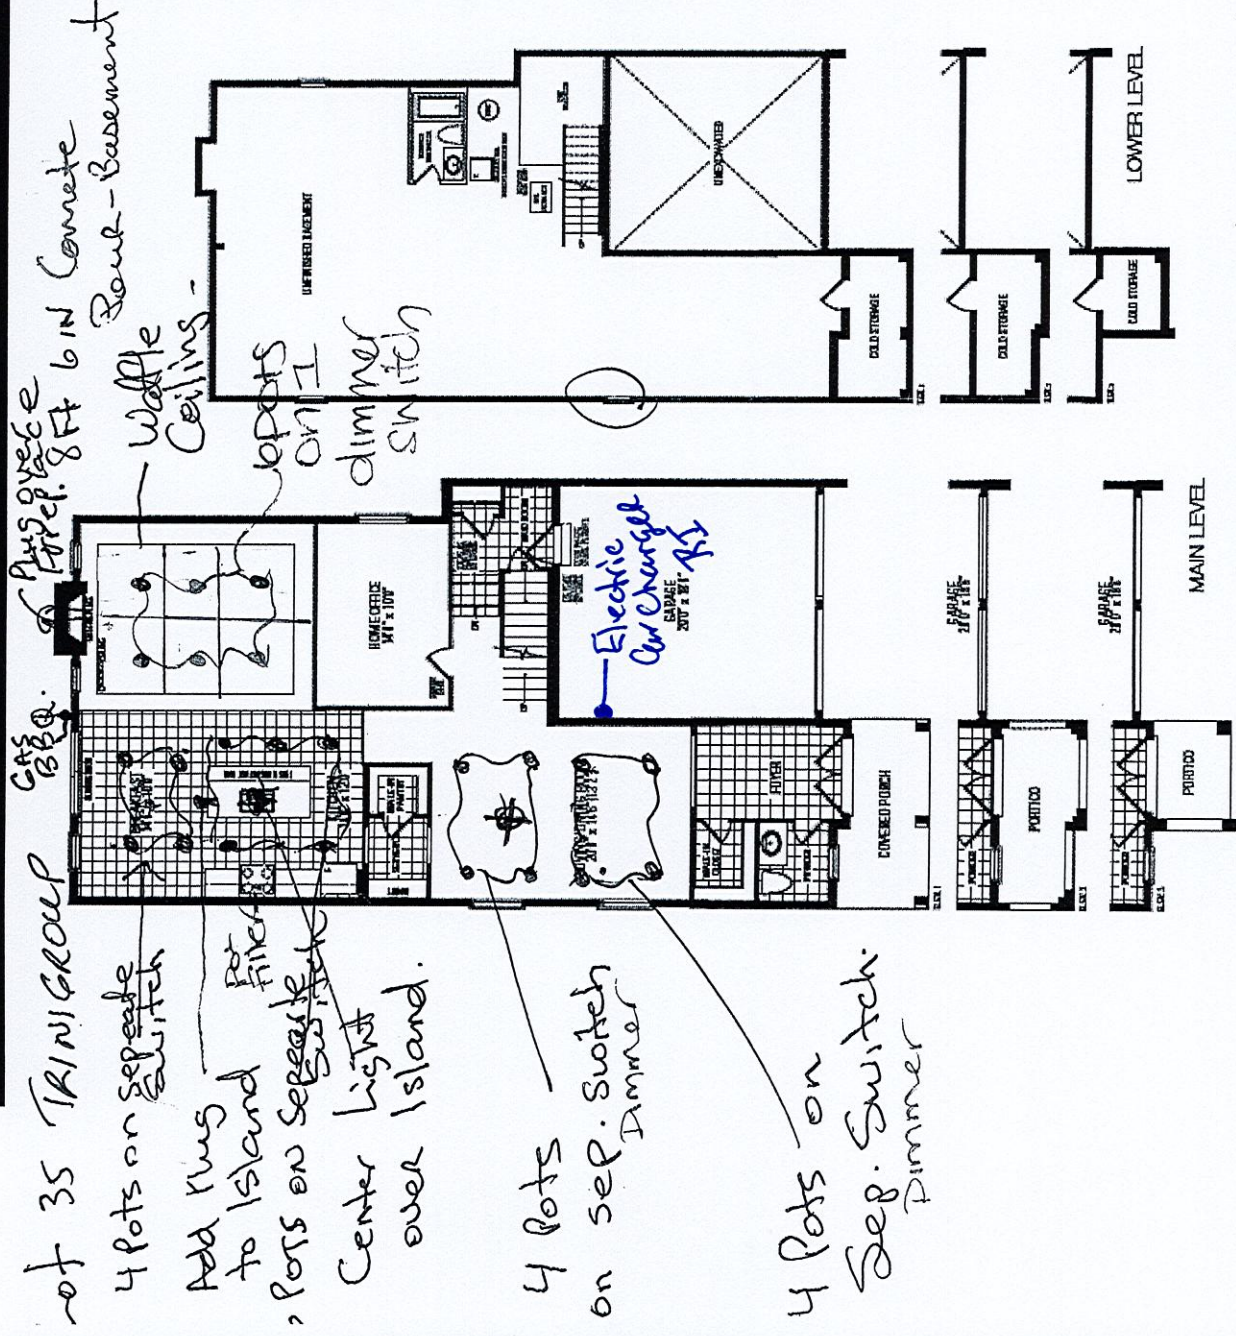

* 10 Ft Ceilings 1st Fl. *

* SMOOTH CELLINGS -- 1st & 2nd Floor *

Orientation of home may be reversed and purchaser agrees to accept the same. Steps and porches may vary at any exterior entrance ways due to grading variances. Actual usable floor space may vary from the stated floor areas. All renderings are artist's concept. Dimensions, specifications and architectural detailing subject to modifications. Roofline and adjoining model types may vary due to siting. E. & Q. E. September 2023