

CONSTRUCTION SUMMARY - PARTIAL ONLY

Palmetto - Zadorra Estates Corp.

PURCHASERS: Vishal SHARMA and Rachna SHARMA

TEL: RES.: 437-230-8502

| LOT NUMBER | PHASE | HOUSE TYPE     | REG. PLAN # |  |  |
|------------|-------|----------------|-------------|--|--|
| 95         | 1     | Rose 12 Elev 3 | 40M-2763    |  |  |
| INV#       | QTY   | EXTRA / CHANGE |             |  |  |

RECEIVED

AUG 19 2024

|       |                                         |
|-------|-----------------------------------------|
| Offer | Note: Revised New Backsplash Area added |
|-------|-----------------------------------------|

COUNTER TOP


IN Kitchen

|                   |                                                                                                                                                                                    |
|-------------------|------------------------------------------------------------------------------------------------------------------------------------------------------------------------------------|
| 29,956<br>16Aug24 | 1 - KITCHEN - STONE BACKSPLASH TO BE INSTALLED AROUND WINDOW ABOVE BAR SINK IN KITCHEN<br>Note:  |
| 29,645<br>28Mar24 | 1 - KITCHEN COUNTER TOP - UPGRADE STONE COUNTER TOP<br>Note:                                                                                                                       |
| 29,645<br>28Mar24 | 1 - KITCHEN BACKSPLASH FULL HEIGHT - UPGRADE STONE COUNTER TOP<br>NoteDOES NOT INCLUDE AREA BEHIND CHIMNEY HOOD TO CEILING                                                         |
| 29,645<br>28Mar24 | 1 - KITCHEN BACKSPLASH EXTRA AREA FOR QUARTZ BACKSPLASH - EXTRA AREA BEHIND CHIMNEY HOOD FAN TO CEILING - FOR 9 FOOT CEILING<br>Note:                                              |
| 29,645<br>28Mar24 | 1 - MASTER ENSUITE COUNTER TOP - UPGRADE STONE COUNTER TOP<br>Note:                                                                                                                |
| 29,645<br>28Mar24 | 1 - POWDER ROOM COUNTER TOP - UPGRADE STONE COUNTER TOP<br>Note:                                                                                                                   |
| 29,645<br>28Mar24 | 1 - BEDROOM 2 ENSUITE COUNTER TOP - UPGRADE STONE COUNTER TOP<br>Note:                                                                                                             |
| 29,645<br>28Mar24 | 1 - BEDROOM 3 ENSUITE COUNTER TOP - UPGRADE STONE COUNTER TOP<br>Note:                                                                                                             |
| 29,645<br>28Mar24 | 1 - BEDROOM 4 ENSUITE COUNTER TOP - UPGRADE STONE COUNTER TOP<br>Note:                                                                                                             |
| 29,645<br>28Mar24 | 5 - VANITY - ADD 3" BACKSPLASH RETURN<br>Note: ALL BATHROOMS                                                                                                                       |

This Document is Extremely Time Sensitive - Printed 16 Aug 24 at 13:54



lot 95 Zadorer

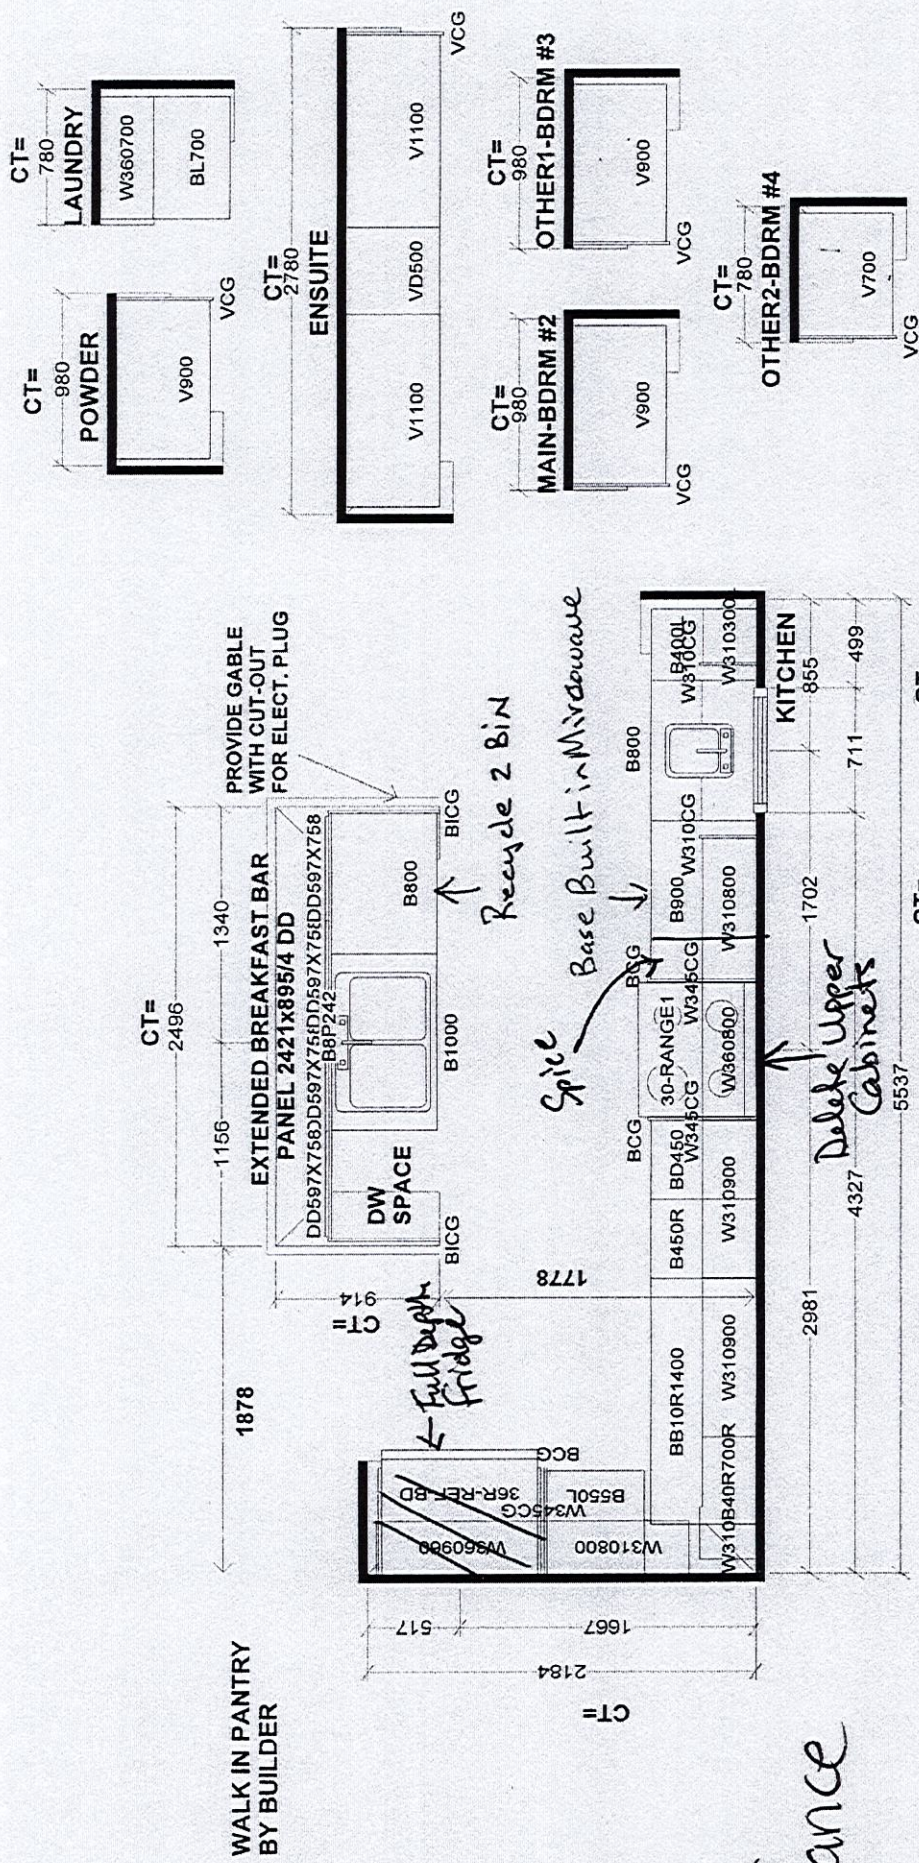

|                                                                                                                                                                                                                            |          |                |                          |     |
|----------------------------------------------------------------------------------------------------------------------------------------------------------------------------------------------------------------------------|----------|----------------|--------------------------|-----|
| Selba Industries                                                                                                                                                                                                           |          |                |                          | J # |
| <small>This drawing is the intellectual property of SELBA INDUSTRIES INC. and is an original design which must not be released without the written approval of Selba Industries Inc. or paid for job order placed.</small> |          |                |                          |     |
| W WIDTH                                                                                                                                                                                                                    | W HGT    | W CNT          | JOB NUMBER:              |     |
| FLOOR HGT                                                                                                                                                                                                                  | DOOR HGT |                | BUILDER: GREENPARK HOMES |     |
| ST CNT                                                                                                                                                                                                                     | 2X4      | VENT BOX COVER | SITE: ZADORRA, Oshawana  |     |
|                                                                                                                                                                                                                            |          |                | MODEL: ROSE 12X EL 1,2,3 |     |
|                                                                                                                                                                                                                            |          |                | LOT #:                   |     |
|                                                                                                                                                                                                                            |          |                | DESIGNER: BM             |     |
|                                                                                                                                                                                                                            |          |                | DATE: AUG 3, 2001        |     |