

CONSTRUCTION SUMMARY - PARTIAL ONLY
Palmetto - Zadorra Estates Corp.

PURCHASERS: Ravi Kumar KEELU and Ratna Sudha CHADUVULA TEL: RES.: 647-287-4282

LOT NUMBER	PHASE	HOUSE TYPE	REG. PLAN #		
92	1	Rose 6 Elev 3 (4 Bedroom)	40M-2763		
INV#	QTY	EXTRA / CHANGE			

REVISED

Offer	Note: New BACKSPLASH AREA ADDED IN
-------	------------------------------------

COUNTER TOP

KITCHEN

29,957 16Aug24	1 - KITCHEN - STONE BACKSPLASH TO BE INSTALLED AROUND WINDOW ABOVE BAR SINK IN KITCHEN Note: ☆ ☆ ☆
29,674 05Apr24	1 - KITCHEN COUNTER TOP - UPGRADE STONE COUNTER TOP Note:
29,674 05Apr24	1 - KITCHEN BACKSPLASH FULL HEIGHT - UPGRADE STONE COUNTER TOP NoteDOES NOT INCLUDE AREA BEHIND CHIMNEY HOOD TO CEILING
29,674 05Apr24	1 - KITCHEN BACKSPLASH EXTRA AREA FOR QUARTZ BACKSPLASH - EXTRA AREA BEHIND CHIMNEY HOOD FAN TO CEILING - FOR 10 FOOT CEILING Note:

This Document is Extremely Time Sensitive - Printed 16 Aug 24 at 14:09

LOT # 92-Zadora


THIS LAYOUT CONTAINS EXTRAS
THAT ARE NOT PART OF CONTRACT

• Upgrade 3-
Bancroft-814
Dark Chocolate

FILE NAME: ZADORRA LOT 92

Blanco - Quartzus-
215-UZ#40519

PROTOTYPE FOR EXTRAS

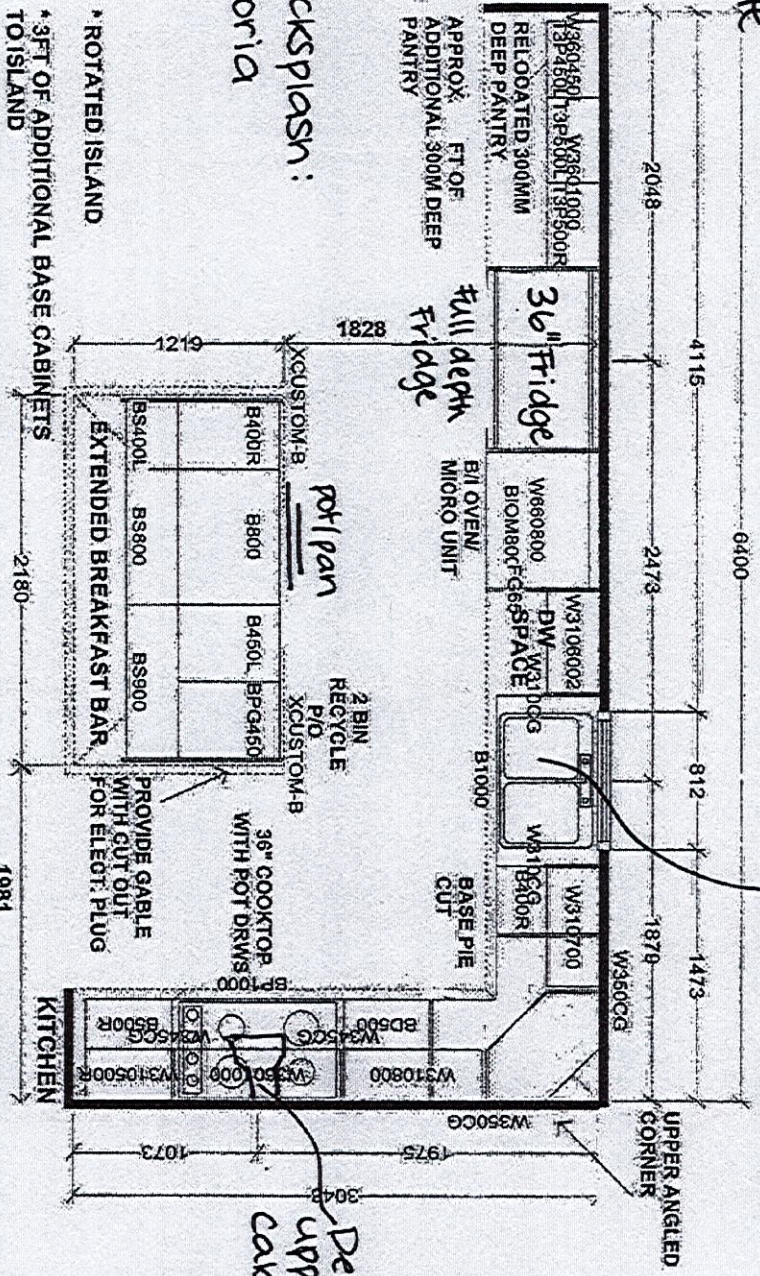


* 3FT OF ADDITIONAL BASE CABINETS
TO ISLAND

* ROTATED ISLAND

COUNTERTOP + Backsplash:
Quartz-Victoria

Delete
upper
cabinets

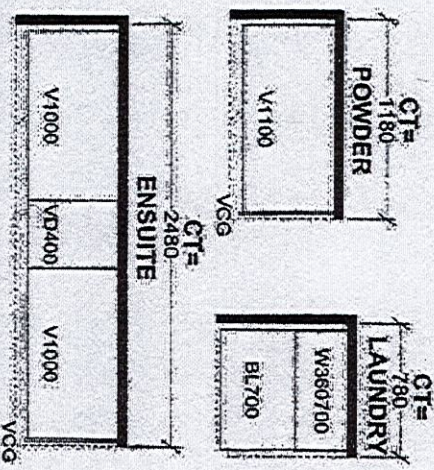

* All bathroom
vanities:
Increase
vanity height
to 36"

S e l b e r Industries J#	
W WIDTH	W HEIGHT
FLOOR HIGHT	DOOR HIGHT
ST CENT	2X4 VENT BOX COVER
DESIGNER: BN	
DATE: AUG 13	
JOB NUMBER:	
BUILDER: GREENPARK HOMES	
SITE: ZADORRA, Oshawa	
MODEL: ROSE 0X EL 3	
LOT #: 92	