

CONSTRUCTION SUMMARY - PARTIAL ONLY
Palmetto - Zadorra Estates Corp.

PURCHASER: Mari MAJIDZADEH TEL: RES.: 416-473-1772


LOT NUMBER	PHASE	HOUSE TYPE	REG. PLAN #	
133	1	Penrose 1 Elev 3	40M-2763	RECEIVED
INV#	QTY	EXTRA / CHANGE		

Offer	Note:
-------	-------

REVISION: PLUG ON island
location
Change
ELECTRICAL

29,271 12Oct23	1 - ABOVE KITCHEN ISLAND - ADD LIGHT AND SWITCH - NO FIXTURE INCLUDED Note:
29,271 12Oct23	1 - LIGHT AND SWITCH - NO FIXTURE INCLUDED - LIVING ROOM Note:
29,271 12Oct23	1 - PLUG - ELECTRICAL PLUG - ADD TO ISLAND Note: SEE KITCHEN SKETCH FOR EXACT LOCATION OF PLUG TO BE IN DUMMY DOOR
29,271 12Oct23	1 - PLUG - ELECTRICAL PLUG - TO BE INSTALLED OVER FIREPLACE Note:
29,271 12Oct23	1 - PRIMARY ENSUITE - FAN - BATHROOM EXHAUST FAN - ENERGY STAR 80 CFM - IN LIEU OF STANDARD FAN Note:
29,271 12Oct23	1 - ELECTRIC VEHICLE ROUGH-IN PROVISION ONLY FOR FUTURE ELECTRIC CAR (CONDUIT FROM BASEMENT INTO JUNCTION BOX IN GARAGE WITH PULL STRING, NO WIRE) Note:

This Document is Extremely Time Sensitive - Printed 26 Aug 24 at 9:07

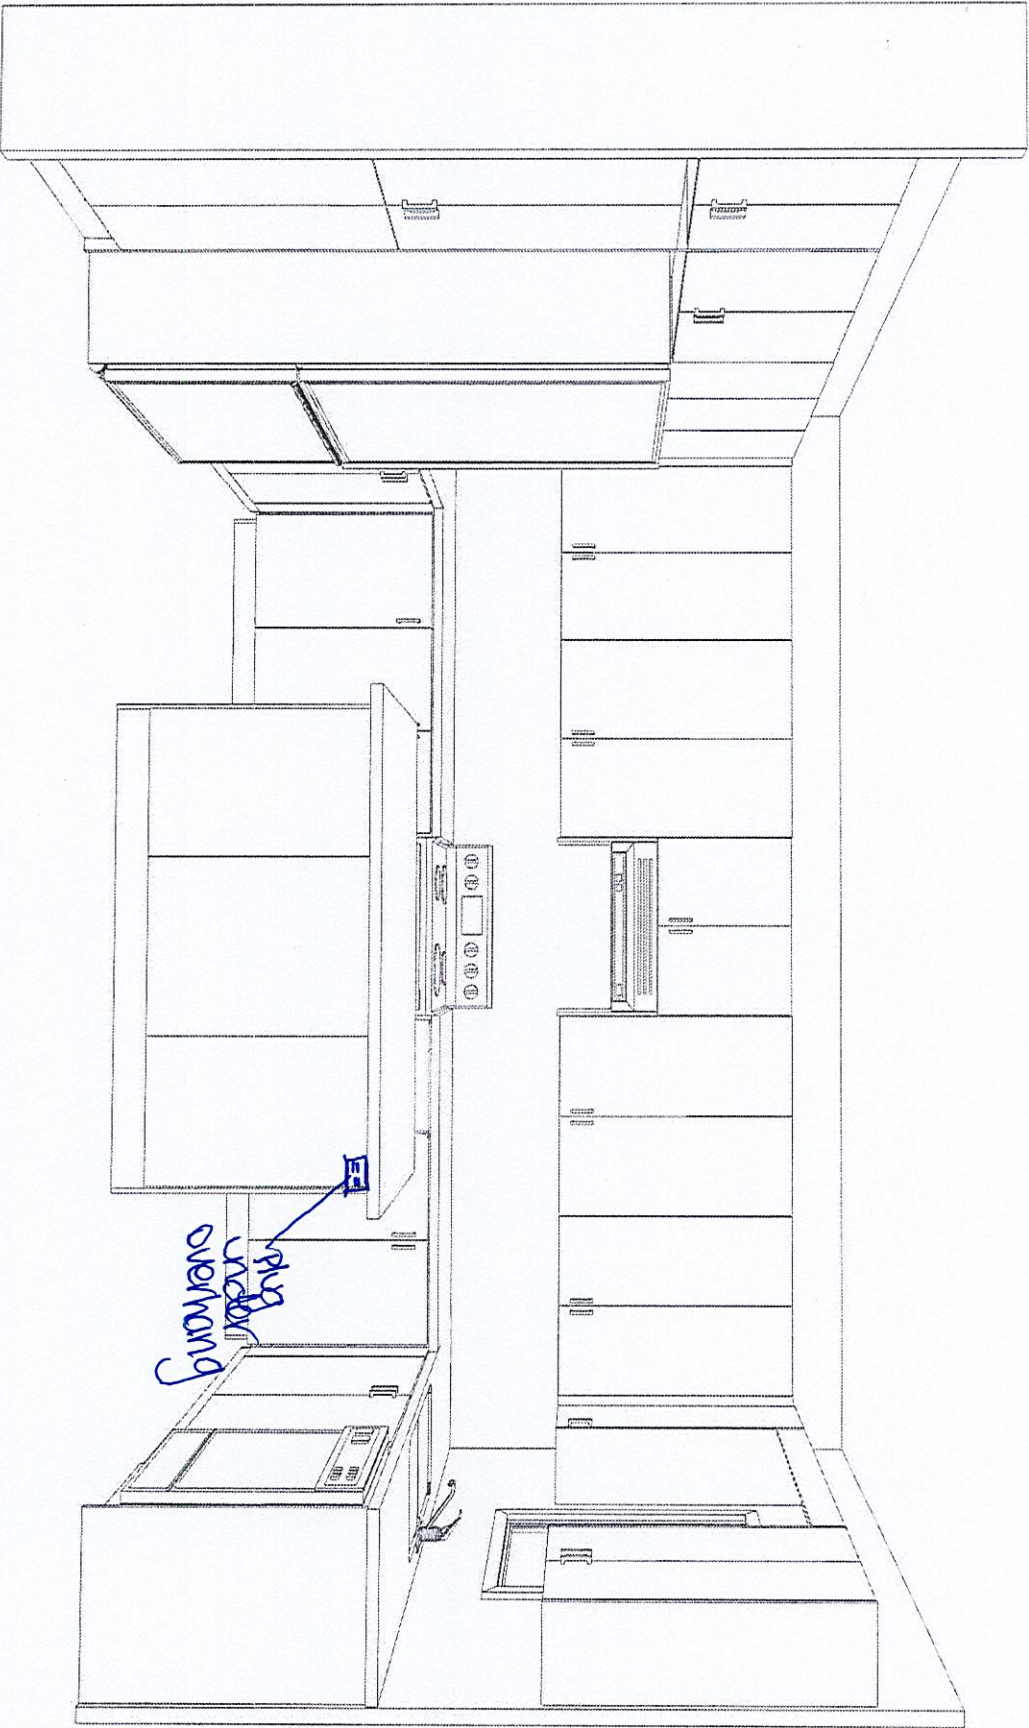

CABINET SIZES AND
POSITIONING MAY VARY
DUE TO ACTUAL ON-SITE
MEASUREMENTS

This drawing is the intellectual property of
SELBA INDUSTRIES INC. and is an
artistic
interpretation of the general
appearance of the design. It is
not meant to be an exact rendition.



Kitchen + Bath Designs

Designed: 10/12/2023
Printed: 10/12/2023