

CONSTRUCTION SUMMARY - PARTIAL ONLY
Legacy Hill - Trinigroup Development Inc.

PURCHASERS: Michael Y F WU and Lihui WANG TEL:

LOT NUMBER	PHASE	HOUSE TYPE	REG. PLAN #		
33	1	Rose 9 Elev 2			
INV#	QTY	EXTRA / CHANGE		RECEIVED	

SEP 30 2024

Offer	Note: REVISED - BASEMENT WINDOWS
-------	---

CONSTRUCTION




29,428 01Nov23	1 - FIRST FLOOR INCREASE CEILING HEIGHT FROM 9 FEET TO 10 FEET Note:
29,832 07Jun24	1 - SMOOTH CEILINGS ON FIRST FLOOR Note:
30,031 26Sep24	2 - ENLARGED BASEMENT WINDOWS (MAY REQUIRE WINDOW WELLS) - WINDOW IS 30 INCHES X 24 INCHES Note:FOR CONFIRMATION PURPOSES ALL BASEMENT WINDOWS TO BE ENLARGED  
29,832 07Jun24	1 - SMOOTH CEILING ON SECOND FLOOR Note:
29,428 01Nov23	1 - LOWER LEVEL - BASEMENT 8 FOOT 6 INCH CONCRETE POUR - MEASURED FROM TOP OF FOOTING TO TOP OF FOUNDATION WALL Note:
29,428 01Nov23	1 - ENLARGED BASEMENT WINDOWS (MAY REQUIRE WINDOW WELLS) - WINDOW IS 30 INCHES X 24 INCHES Note:  
29,832 07Jun24	1 - MASTER ENSUITE - PROVISION FOR FRAMELESS GLASS SHOWER ENCLOSURE - REMOVE SIDE WALL AND REPLACE WITH GLASS TO ACCOMMODATE FRAMELESS GLASS SHOWER ENCLOSURE SEE SKETCH Note:

This Document is Extremely Time Sensitive - Printed 27 Sep 24 at 10:20

Rose 9 40' Lot FOR LOT 32 & 33

Elev. 1: 3,456 sq.ft. Elev. 2: 3,466 sq.ft. Elev. 3: 3,466 sq.ft.

Lot 33 TRINIGROUP.

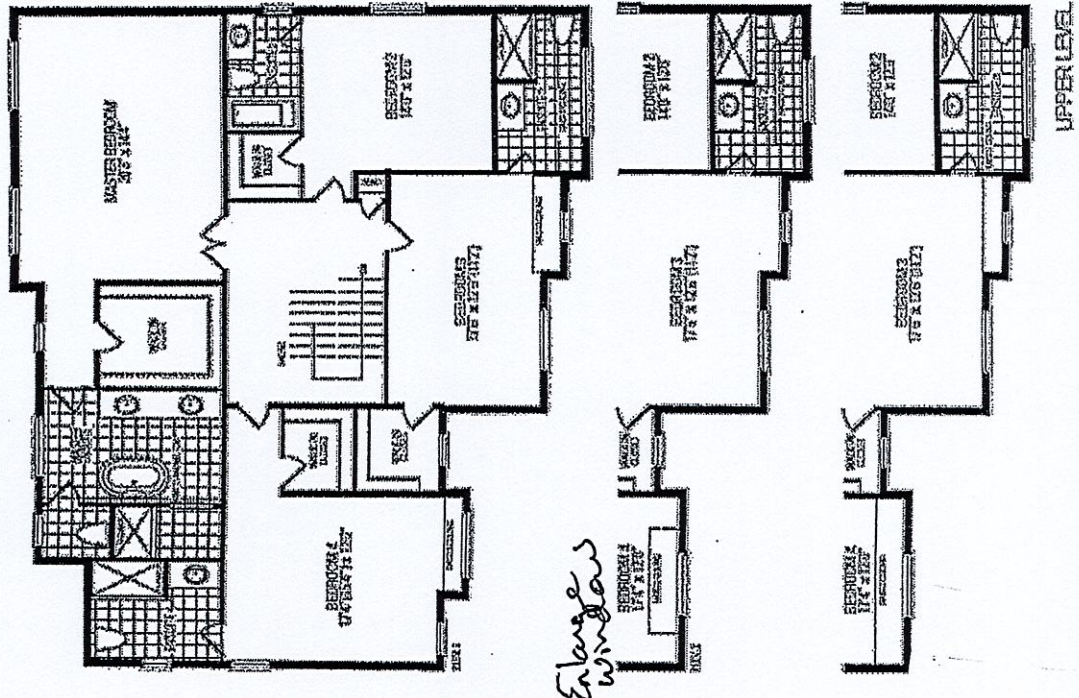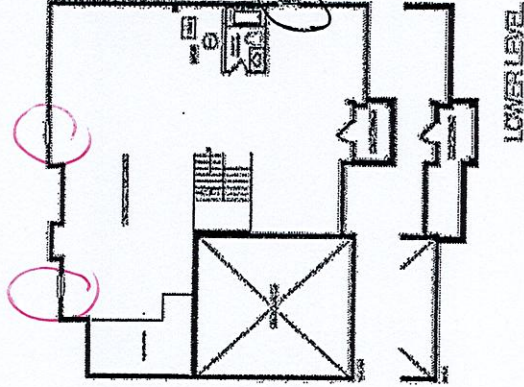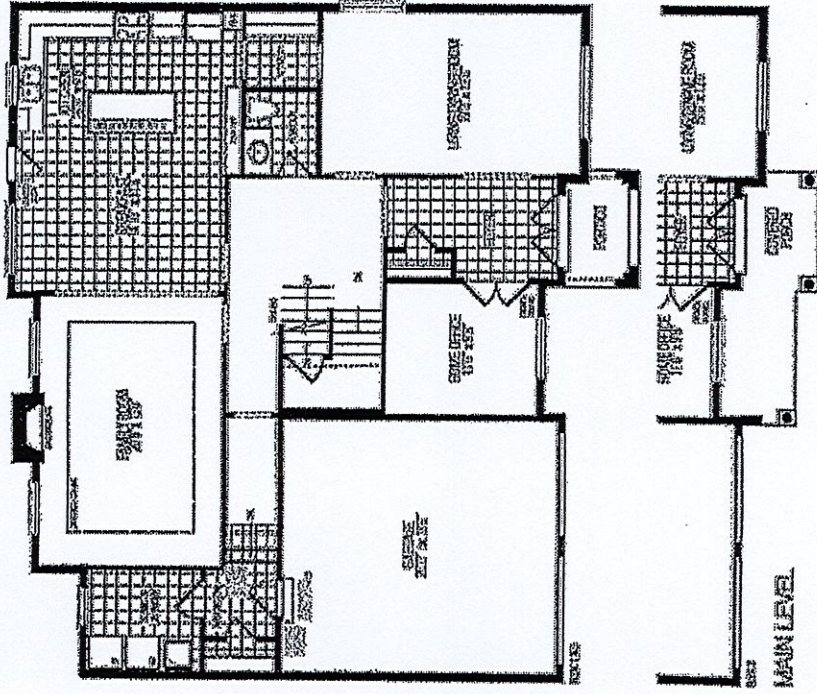

Orientation of rooms may be reversed and purchaser agrees to accept the same. Steps and porches may vary of any other variations due to grading variance. Actual usable floor space may vary from the stated floor space. All renderings are artist's concept. Dimensions, specifications and architectural detailing subject to recorded covenants, conditions and adjoining modern types may vary due to change. E. & C. E. September 2022