

CONSTRUCTION SUMMARY - PARTIAL ONLY
Legacy Hill - Trinigroup Development Inc.

PURCHASER: Xiao LIU TEL:

LOT NUMBER	PHASE	HOUSE TYPE	REG. PLAN #		
109	1	Villa 5 Elev 1			
INV#	QTY	EXTRA / CHANGE			



RECEIVED

SEP 30 2024

Offer	Note: REVISED - BASEMENT WINDOWS
-------	---

CONSTRUCTION

29,397 24Oct23	1 - FIRST FLOOR INCREASE CEILING HEIGHT FROM 9 FEET TO 10 FEET Note:
29,875 05Jun24	1 - LOWER LEVEL - BASEMENT 8 FOOT 6 INCH CONCRETE POUR - MEASURED FROM TOP OF FOOTING TO TOP OF FOUNDATION WALL Note:
30,022 24Sep24	2 - ENLARGED BASEMENT WINDOWS (MAY REQUIRE WINDOW WELLS) - WINDOW IS 30 INCHES X 24 INCHES Note: FOR CONFIRMATION PURPOSES ALL BASEMENT WINDOWS TO BE ENLARGED
29,397 24Oct23	1 - ENLARGED BASEMENT WINDOWS (MAY REQUIRE WINDOW WELLS) - WINDOW IS 30 INCHES X 24 INCHES Note:

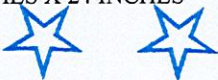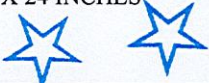

This Document is Extremely Time Sensitive - Printed 24 Sep 24 at 16:00


Villa 5 36' Lot

Elev. 1: 2,881 sq.ft. Elev. 2: 2,871 sq.ft. Elev. 3: 2,873 sq.ft.
Includes 19 sq.ft. of Open Area



Lot 109 Trinigroup

* 10 ft Ceilings 1st fl *
Enlarge Windows

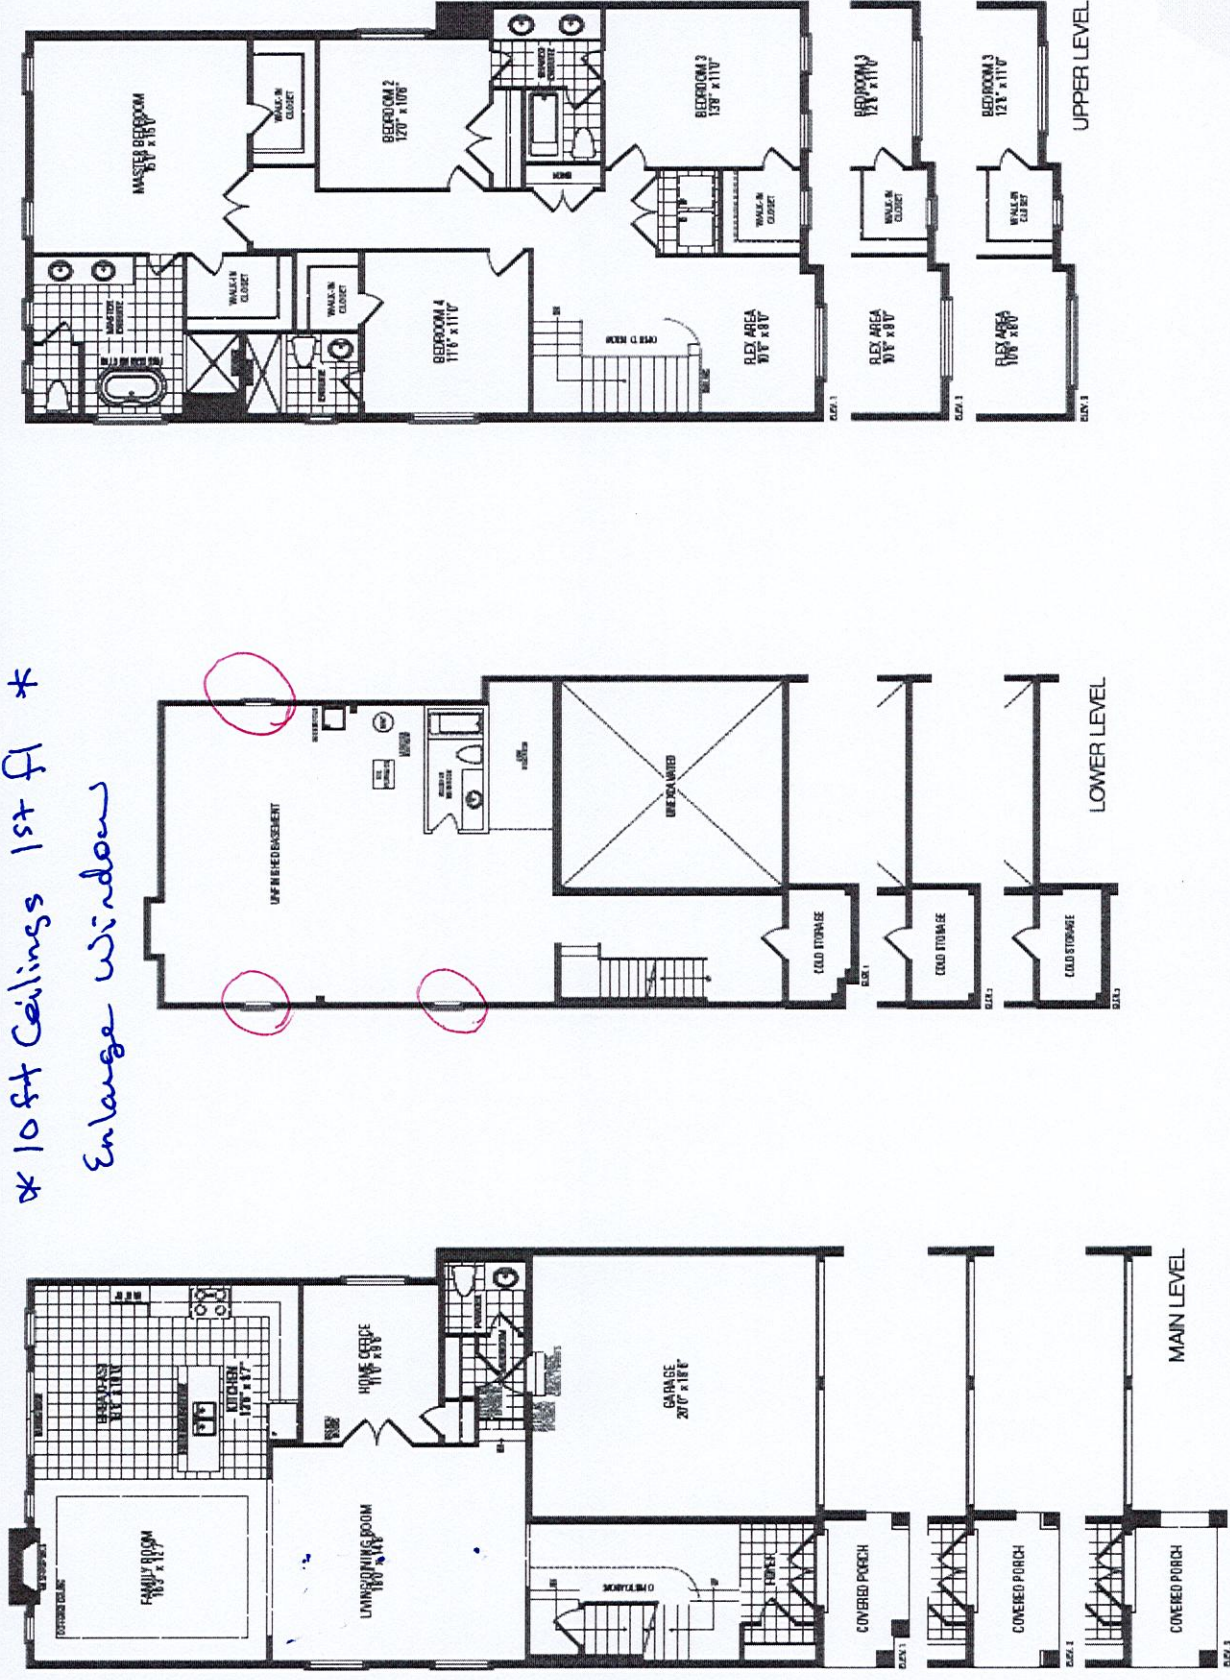

Orientation of home may be reversed and purchaser agrees to accept the same. Steps and porches may vary at any exterior entrance ways due to grading variance. Actual usable floor space may vary from the stated floor areas. All renderings are artist's concept. Dimensions, specifications and architectural detailing subject to modifications. Roofline and adjoining model types may vary due to siting. E. & O. E. September 2023