

CONSTRUCTION SUMMARY - PARTIAL ONLY
Legacy Hill - Trinigroup Development Inc.

PURCHASERS: Annie Mei Ying LAI and Kennic Shiu Kan FONG TEL:

LOT NUMBER	PHASE	HOUSE TYPE	REG. PLAN #		
110	1	Villa 6 Elev 1			
INV#	QTY	EXTRA / CHANGE			

RECEIVED

SEP 30 2024

Offer	Note: REVISED - BASEMENT WINDOWS
-------	---

CONSTRUCTION


29,392 24Oct23	1 - FIRST FLOOR INCREASE CEILING HEIGHT FROM 9 FEET TO 10 FEET Note:
29,845 29May24	1 - SMOOTH CEILINGS ON FIRST FLOOR Note:
30,024 25Sep24	2 - ENLARGED BASEMENT WINDOWS (MAY REQUIRE WINDOW WELLS) - WINDOW IS 30 INCHES X 24 INCHES NoteFOR CONFIRMATION PURPOSES ALL BASEMENT WINDOWS TO BE ENLARGED  
29,845 29May24	1 - SMOOTH CEILING ON SECOND FLOOR Note:
29,392 24Oct23	1 - LOWER LEVEL - BASEMENT 8 FOOT 6 INCH CONCRETE POUR - MEASURED FROM TOP OF FOOTING TO TOP OF FOUNDATION WALL Note:
29,392 24Oct23	1 - ENLARGED BASEMENT WINDOWS (MAY REQUIRE WINDOW WELLS) - WINDOW IS 30 INCHES X 24 INCHES Note:  
29,845 29May24	1 - MASTER ENSUITE - PROVISION FOR FRAMELESS GLASS SHOWER ENCLOSURE - REMOVE SIDE WALL AND REPLACE WITH GLASS TO ACCOMMODATE FRAMELESS GLASS SHOWER ENCLOSURE SEE SKETCH Note:

This Document is Extremely Time Sensitive - Printed 27 Sep 24 at 9:11

Villa 6 36' Lot

Elev. 1: 3,038 sq.ft. Elev. 2: 3,047 sq.ft. Elev. 3: 3,047 sq.ft.

LH

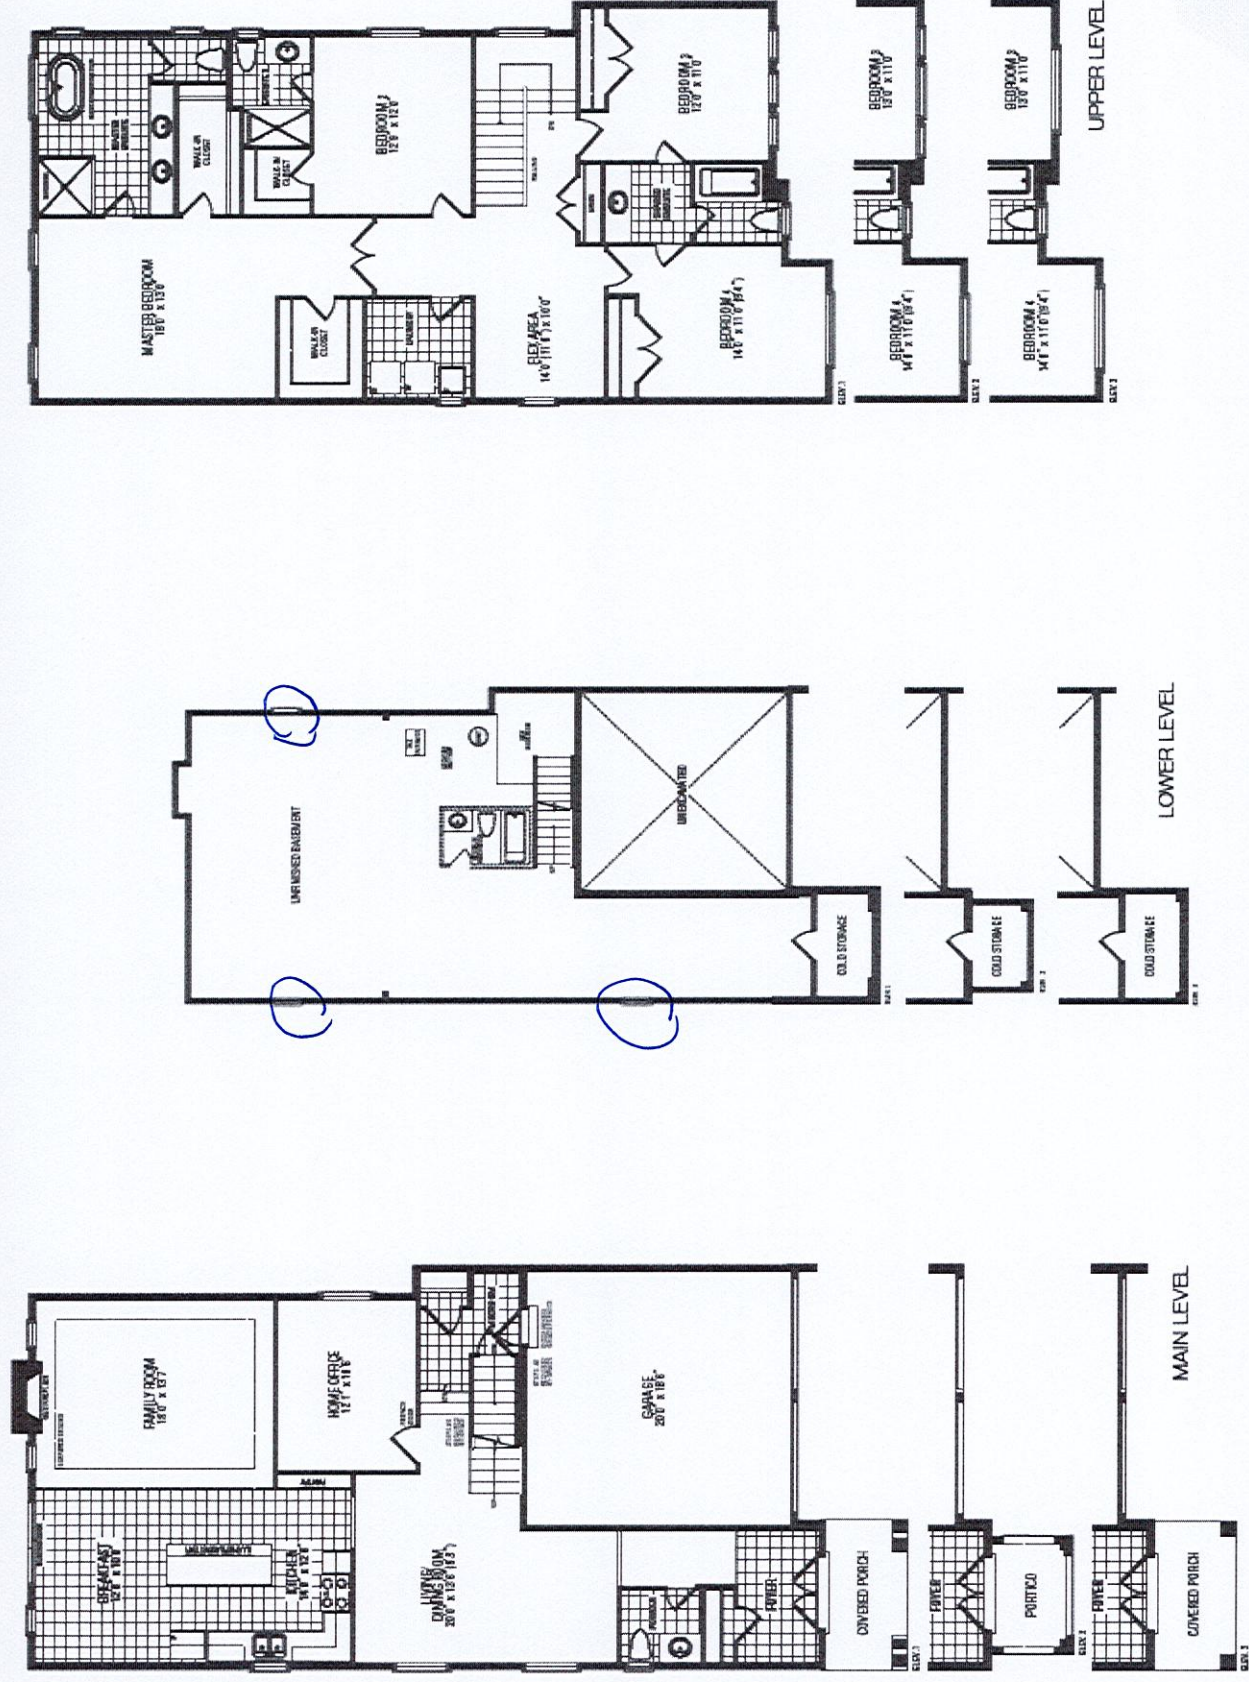

Lot 110 Legacy

Orientation of home may be reversed and purchaser agrees to accept the same. Steps and porches may vary at any exterior entrance ways due to grading variance. Actual usable floor space may vary from the stated floor areas. All renderings are artist's concept. Dimensions, specifications and architectural detailing subject to modifications. Roofline and adjoining model types may vary due to siting. E. & O. E. September 2023