

CONSTRUCTION SUMMARY			RECEIVED	
Legacy Hill - Trinigroup Development Inc.			OCT 08 2024	
PURCHASERS: Clarence Wai-Lun AU and Joey Edna HO			TEL:	
LOT / PHASE	REG. PLAN #	HOUSE TYPE		
84 / 1	65M-4818	Villa 5 Elev 1		

CONSTRUCTION

3 - ENLARGED BASEMENT WINDOWS (MAY REQUIRE WINDOW WELLS) - WINDOW IS 30 INCHES X 24 INCHES 07Oct24 Note:	
1 - LOWER LEVEL - BASEMENT 8 FOOT 6 INCH CONCRETE POUR - MEASURED FROM TOP OF FOOTING TO TOP OF FOUNDATION WALL 07Oct24 Note:	

PROMOTIONAL

1 - LESS CREDIT FROM PURCHASER EXTRA SHEET IN OFFER 07Oct24 Note:	
--	--

EXTRAS AS PER OFFER

The Vendor agrees that notwithstanding any other term or provision in this Agreement included in the Purchase Price and in addition to those items detailed in Schedule GP to the Agreement of Purchase and Sale, the Purchaser is entitled to a credit of Ten Worksheet Note:	
---	--


This Document is Extremely Time Sensitive - Printed 7 Oct 24 at 12:01

Villa 5 36' Lot



Elev. 1: 2,881 sq.ft. Elev. 2: 2,871 sq.ft. Elev. 3: 2,873 sq.ft.
Includes 19 sq.ft. of Open Area



Lot 84
Legacy

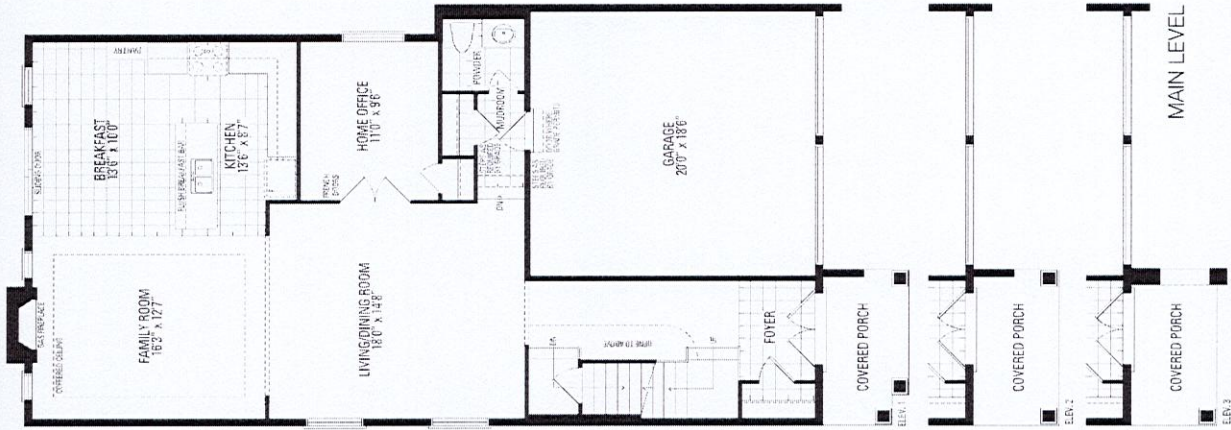

Upgrade Windows.

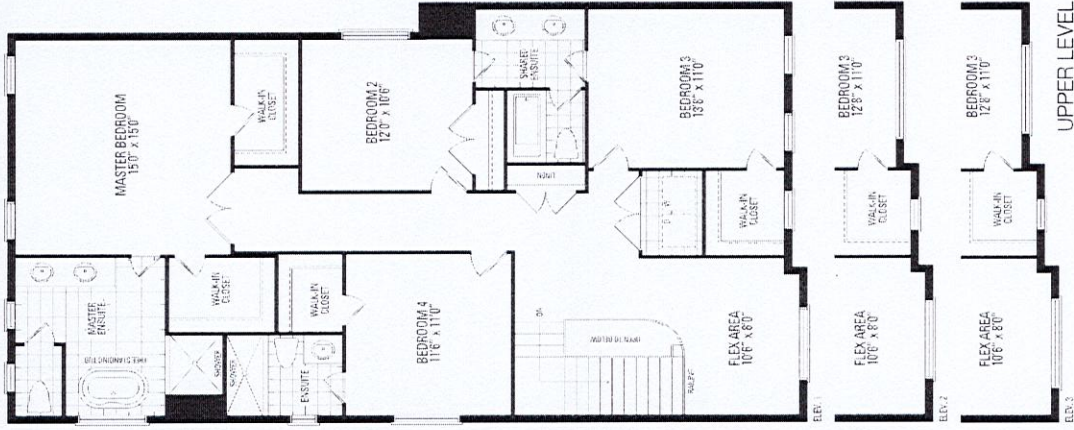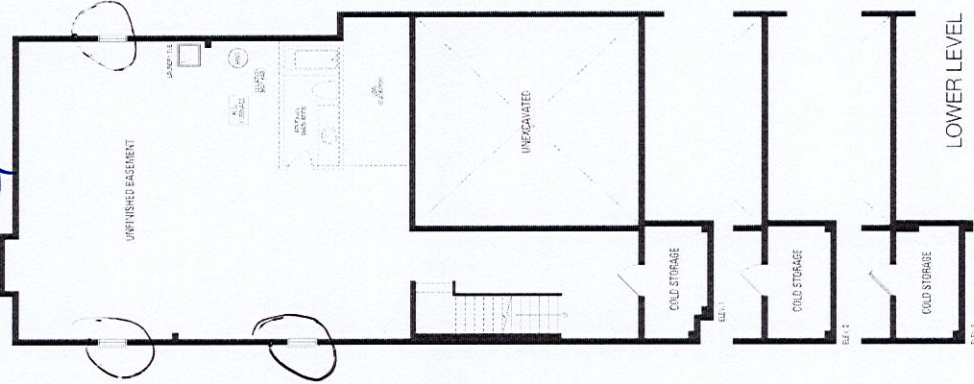

Basement 8 Ft 6 in Concrete Pour

Orientation of home may be reversed and purchaser agrees to accept the same. Steps and porches may vary at any exterior entrance ways due to grading variance. Actual usable floor space may vary from the stated floor areas. All renderings are artist's concept. Dimensions, specifications and architectural detailing subject to modifications. Roofline and adjoining model types may vary due to siting. E. & O. E. September 2023