

CONSTRUCTION SUMMARY

Palmetto - Zadorra Estates Corp.

PURCHASER: INVENTORY LOT_61

TEL:

LOT / PHASE 61 / 1	REG. PLAN # 40M-2763	HOUSE TYPE Rose 6 Elev 2 (5 Bedroom)		
-----------------------	-------------------------	---	--	--

ELECTRICAL

1 - DELETE STANDARD CEILING LIGHTS IN FOYER, MAIN HALL AND SIDE HALL TO ACCOMODATE POTLIGHTS 20Jan25 Note:	
1 - PLUG - ELECTRICAL PLUG - TO BE INSTALLED OVER FIREPLACE 20Jan25 Note:	
1 - RELOCATE STANDARD KITCHEN LIGHT TO BE CENTERED OVER ISLAND 20Jan25 Note:	
1 - POT LIGHT - LED - FIRST FLOOR INSTALLATION FOYER X2 MAIN HALL X4 LIVING/DINING ROOM INCLD SIDE HALL X7 FAMILY X6 OFFICE X4 KITCHEN X5 BREAKFAST X7 20Jan25 Note:	

This Document is Extremely Time Sensitive - Printed 20 Jan 25 at 11:40

upgrade electrical

RECEIVED
JAN 20 2025

Rose 6 Elev 2 Lot 61 - 5 bedroom electrical upgrade sketch

Delete standard lights in foyer, main hall and side hall to accommodate potlights

7 pots

5 pots



4 pots

4 pots


2 pots

6 pots

7 pots

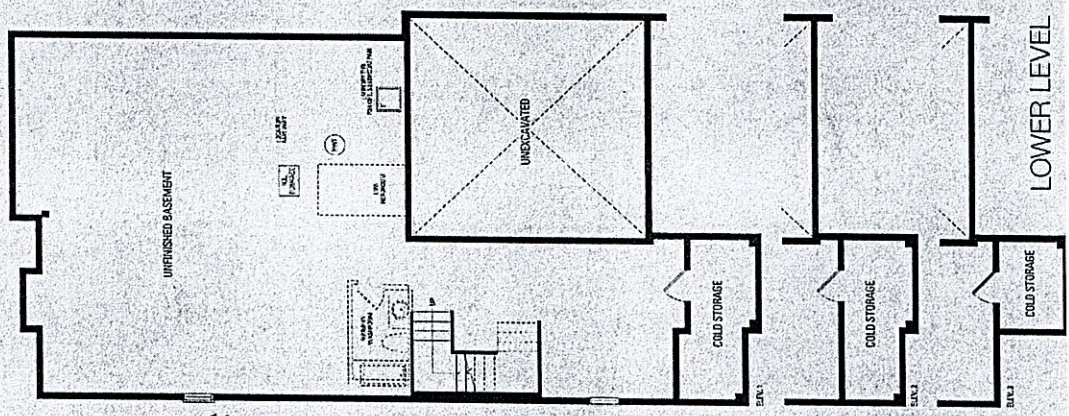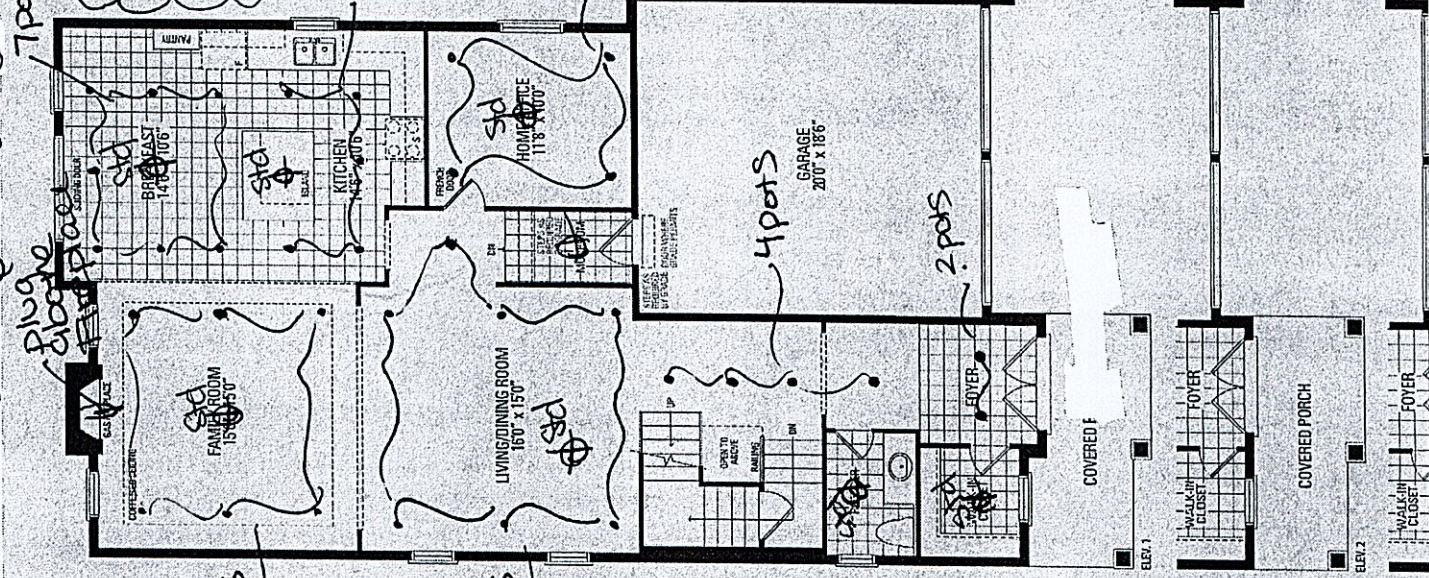

LOWER LEVEL

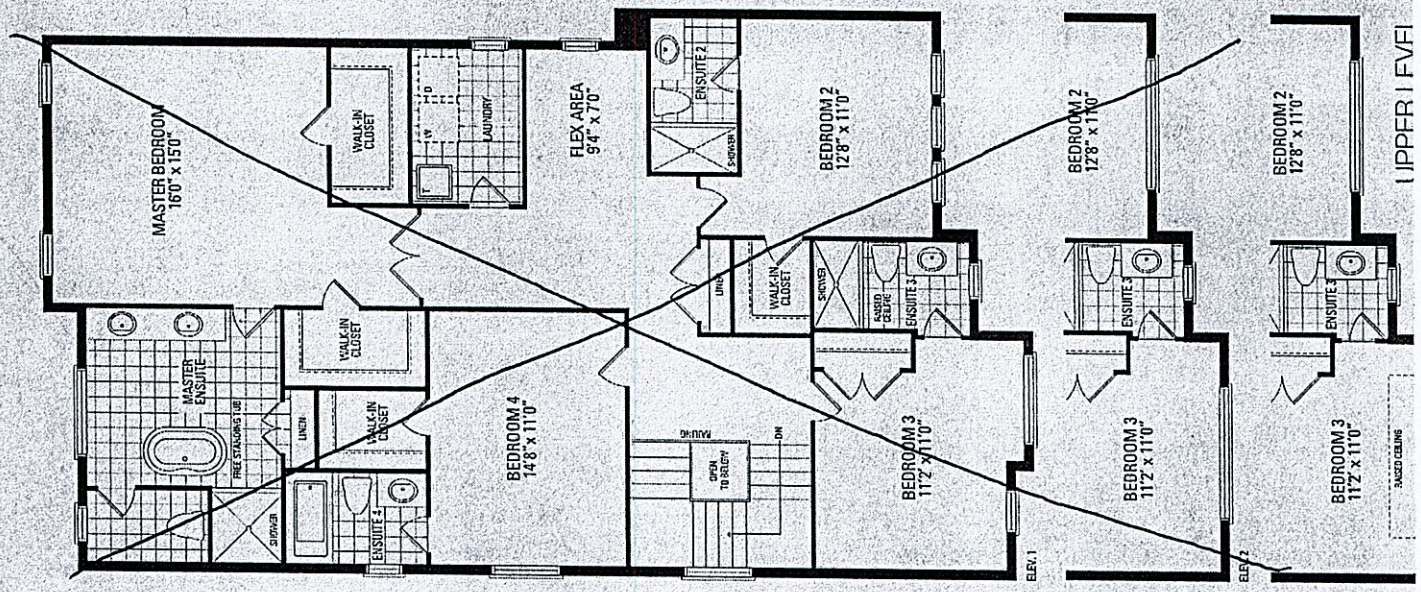

UPPER LEVEL

