

CONSTRUCTION SUMMARY - PARTIAL ONLY Legacy Hill - Trinigroup Development Inc.	
PURCHASERS: Lilian S. Z. HANNA and Fady Magdy Geor YOSSEF	TEL:

LOT NUMBER	PHASE	HOUSE TYPE	REG. PLAN #		
16	1	Rose 2 Elev 3	65M-4818		

INV#	QTY	EXTRA / CHANGE
------	-----	----------------

Offer	Note:
-------	-------

FIREPLACE AND ACCESSORIES

29,748 08May24	1 - GAS LINE ROUGH-IN FOR STOVE (INCLUDES ELECTRICAL OUTLET) - FIRST FLOOR Note:
-------------------	---


29,748 08May24	1 - GAS LINE ROUGH-IN FOR BARBECUE - FIRST FLOOR Note: <i>Location Attached</i>	RECEIVED APR 09 2025	
-------------------	--	-------------------------	--

This Document is Extremely Time Sensitive - Printed 9 Apr 25 at 9:46

Rose 2 40' Lot

Elev. 1: 3,005 sq.ft. Elev. 2: 2,999 sq.ft. Elev. 3: 2,998 sq.ft.

Lot 16 Legacy ~~BBQ Gas line~~

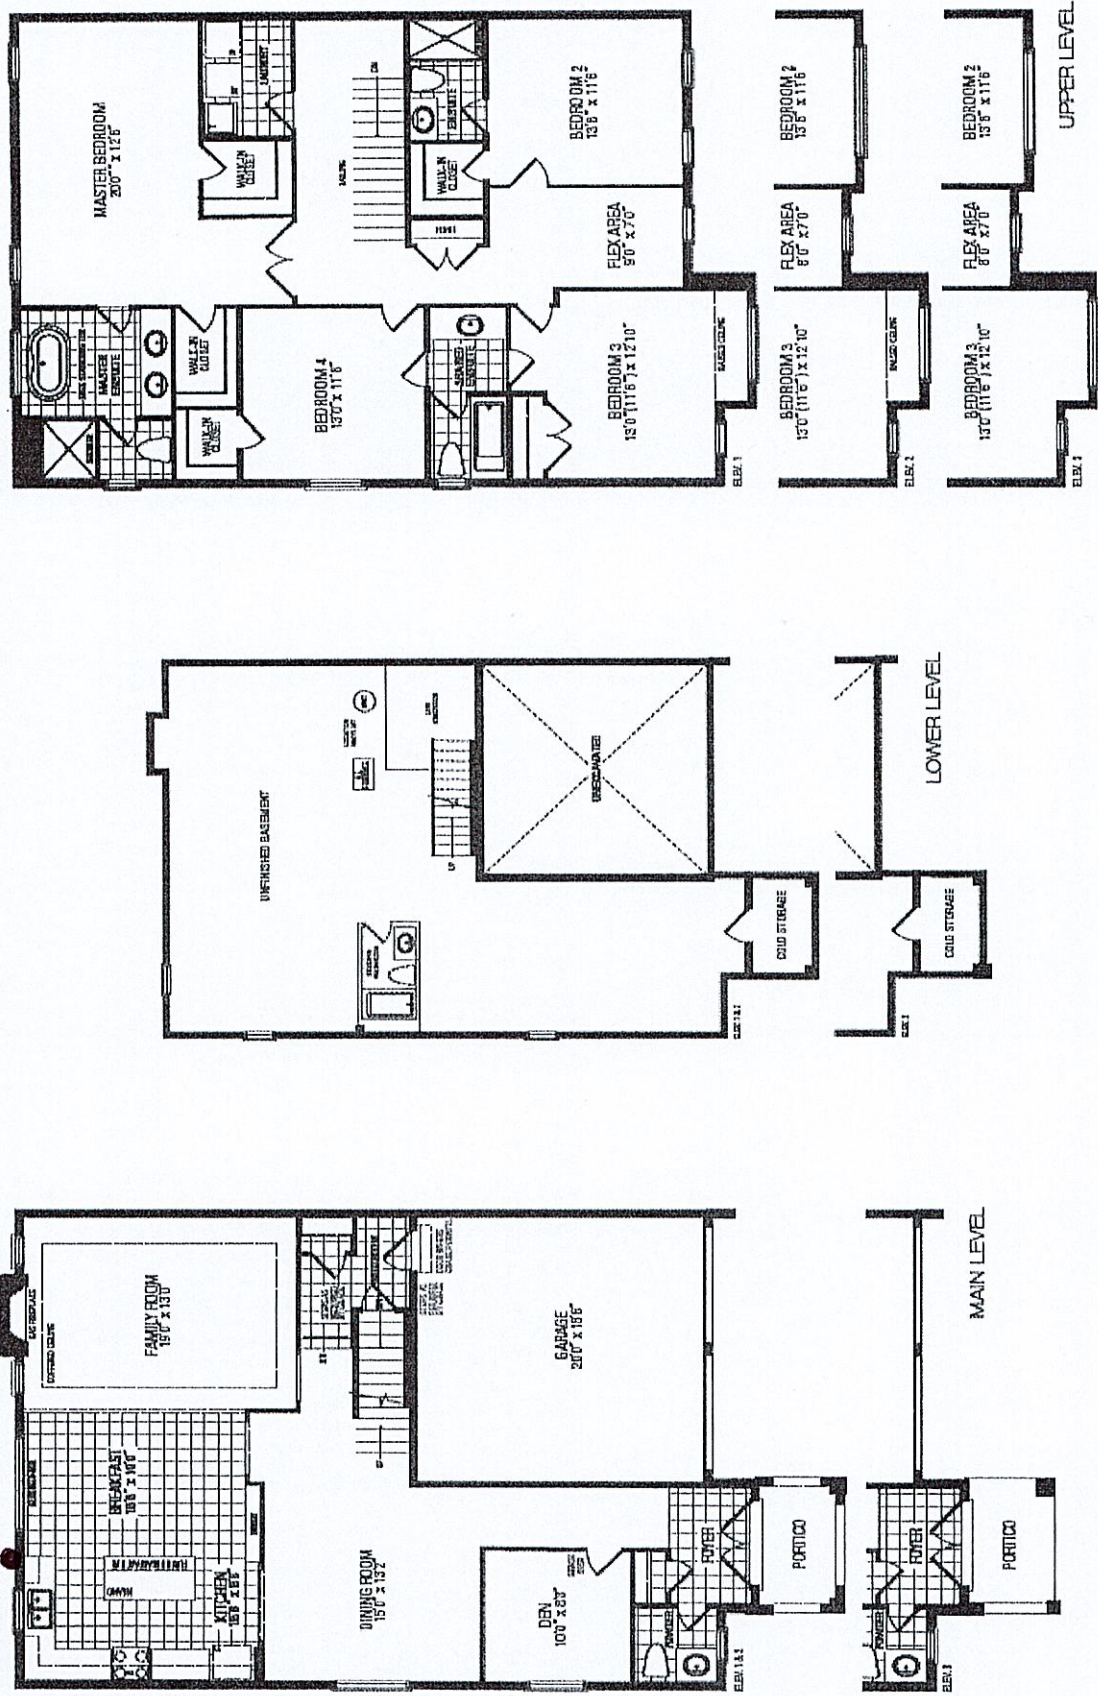

Orientation of home may be reversed and purchaser agrees to accept the same. Steps and porches may vary at any exterior entrance ways due to grading variance. Actual usable floor space may vary from the stated floor area. All renderings are artist's concept. Dimensions, specifications and architectural detailing subject to modifications. Roofline and adjoining model types may vary due to siting. E. O. E. September 2023