

| CONSTRUCTION SUMMARY - PARTIAL ONLY       |  |  |  |  |      |
|-------------------------------------------|--|--|--|--|------|
| Legacy Hill - Trinigroup Development Inc. |  |  |  |  |      |
| PURCHASERS: Chun Hon PAK and Hiu Pui LAM  |  |  |  |  | TEL: |

| LOT NUMBER | PHASE | HOUSE TYPE     | REG. PLAN # |  |  |
|------------|-------|----------------|-------------|--|--|
| 73         | 1     | Villa 6 Elev 3 | 65M-4818    |  |  |

| INV# | QTY | EXTRA / CHANGE |  |
|------|-----|----------------|--|
|------|-----|----------------|--|

CABINETRY

|                   |                                                                                                                                                                                                                                                  |
|-------------------|--------------------------------------------------------------------------------------------------------------------------------------------------------------------------------------------------------------------------------------------------|
| 30,248<br>04Mar25 | 1 - KITCHEN - SHIFT FRIDGE TO ACCOMODATE BUILT INS<br>Note:                                                                                                                                                                                      |
| 30,326<br>23Apr25 | <del>1 - KITCHEN CABINETRY - RELOCATE BANK OF DRAWERS TO ISLAND NEXT TO RECYCLE PULL OUT</del><br>Note:<br><b>RELOCATE BANK OF DRAWERS TO ISLAND</b>            |
| 30,185<br>28Feb25 | 1 - CABINETRY - KITCHEN - UPGRADE 6<br>Note:                                                                                                                                                                                                     |
| 30,185<br>28Feb25 | 1 - KITCHEN CABINETRY HARDWARE - DELETE HARDWARE NO HOLES DRILLED<br>Note:                                                                                                                                                                       |
| 30,185<br>28Feb25 | 1 - KITCHEN ISLAND - ADD APPROX. 2 FEET OF BASE CABINETS TO ISLAND AS PER SKETCH<br>Note: INCLUDES UPGRADE 6 CABINETRY AND QUARTZ COUNTERTOP                                                                                                     |
| 30,185<br>28Feb25 | 2 - CABINETRY PROVISION - PROVISION FOR PLUG ON ISLAND (PLUG EXTRA ORDERED SEPARATELY)<br>Note: PLUG TO BE INSTALLED ON DUMMY DOORS SIDE OF ISLAND<br>INSTALLED HORIZONTALLY AS HIGH AS POSSIBLE TO KITCHEN COUNTERTOP (IF CONSTRUCTION PERMITS) |
| 30,185<br>28Feb25 | <del>1 - KITCHEN - FLUSH INSTALL FOR FRIDGES &amp; FREEZER</del><br>Note:<br><b>CUSTOM CABINET TO HOUSE BUILT IN MIELE FRIDGE AND FREEZER X2</b>            |

CABINETRY ACCESSORIES


|                   |                                                                                                                                                                                              |
|-------------------|----------------------------------------------------------------------------------------------------------------------------------------------------------------------------------------------|
| 30,185<br>28Feb25 | <del>1 - KITCHEN CABINETRY UPPER - FULL DEPTH ABOVE FRIDGE UPPER - WITH GABLES - 650MM DEEP - PRICE IS EACH</del><br>Note: <del>X2 FRIDGE X1 FREEZER SIDE BY SIDE SEE SKETCH AND SPECS</del> |
| 30,185<br>28Feb25 | 1 - KITCHEN CABINETRY - BUILT-IN FRIDGE/FREEZER FEE - PRICE IS EACH<br>Note:                                                                                                                 |
| 30,185<br>28Feb25 | 1 - KITCHEN CABINETRY - APPLIANCE DOOR PANELS - FRIDGE & FREEZER DOOR PANELS - SUPPLY ONLY, INSTALLATION NOT INCLUDED, HARDWARE NOT INCLUDED - UPGRADE 6<br>Note:                            |
| 30,185<br>28Feb25 | 1 - KITCHEN CABINETRY - BUILT-IN MICROWAVE/OVEN COMBO WITH ONE POT DRAWER - UPGRADE 6<br>Note:                                                                                               |
| 30,185<br>28Feb25 | 1 - KITCHEN CABINETRY BASE - COOKTOP CABINET WITH POT DRAWERS (2 DRAWERS) - UPGRADE 6<br>Note:                                                                                               |
| 30,185<br>28Feb25 | 1 - KITCHEN CABINETRY - APPLIANCE DOOR PANELS - 24" DISHWASHER DOOR PANEL (SUPPLY ONLY, INSTALLATION NOT INCLUDED, HARDWARE NOT INCLUDED) - UPGRADE 6<br>Note:                               |
| 30,185<br>28Feb25 | <del>1 - CABINETRY FEE FOR FLUSH CUTOUT ON WALL OVEN/MICROWAVE COMBO CABINET ONLY</del><br>Note:                                                                                             |



FILE NAME: TRINIGROUP LOT 73-APR 1 25


MAR 6 25  
PAULINE  
REV APR 1 25 PB

PROTOTYPE FOR EXTRAS

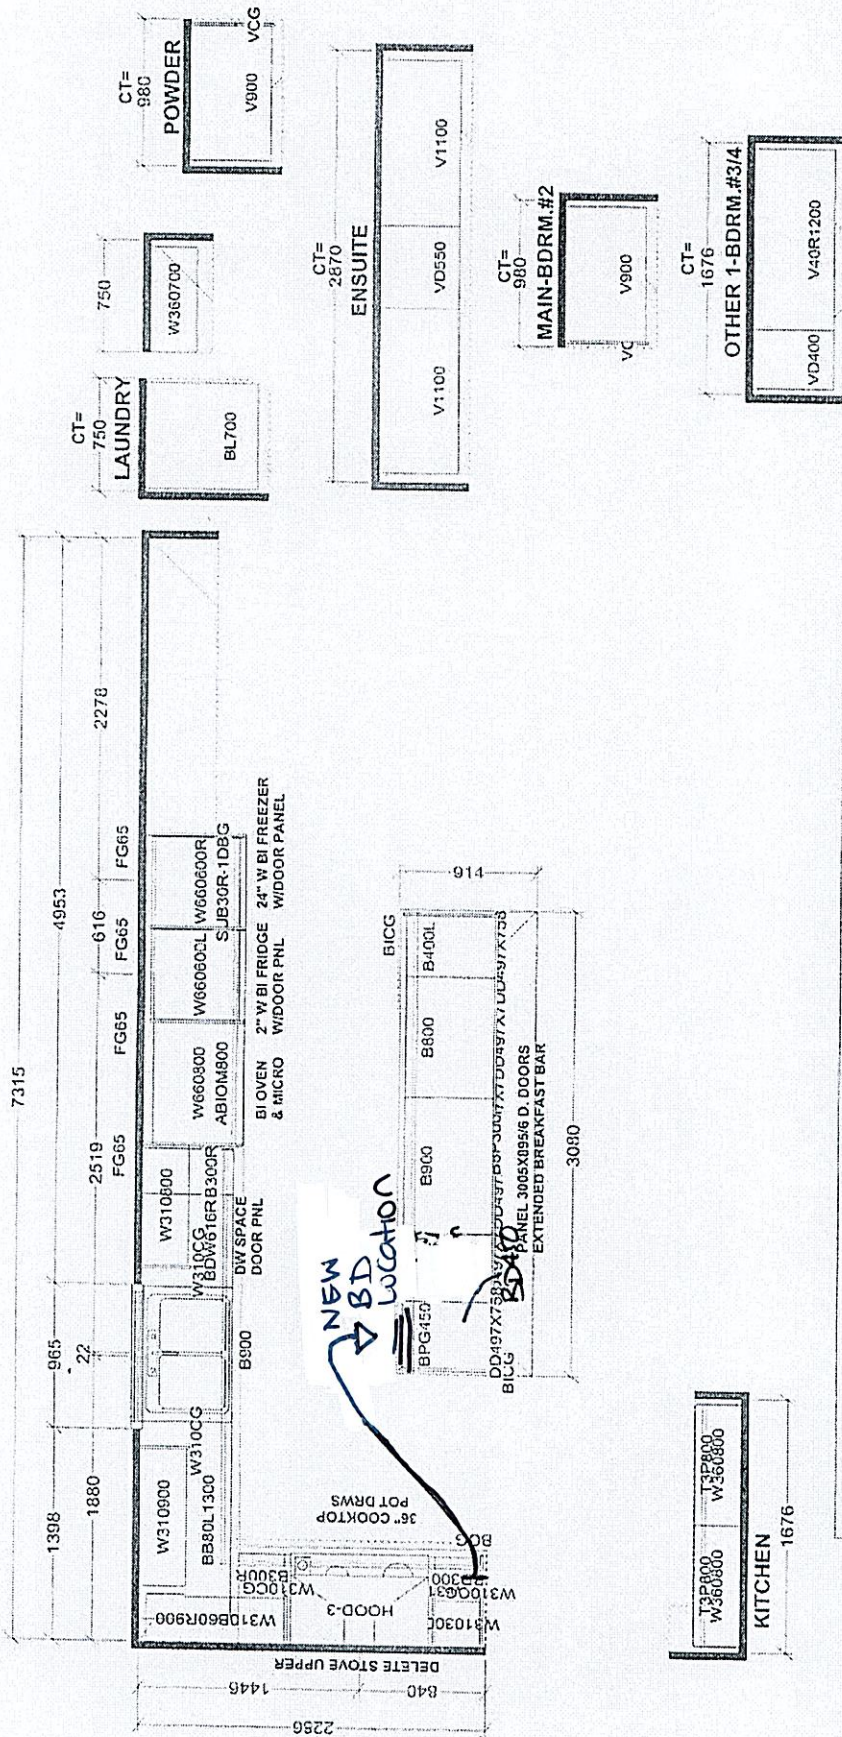

|                     |          |                |                                  |
|---------------------|----------|----------------|----------------------------------|
| Selba Industries J# |          |                |                                  |
| W WIDTH             | W HGT    | W CNT          | JOB NUMBER:                      |
| FLOOR HGT           | DOOR HGT |                | BUILDER: GREENPARK HOMES         |
| ST CENT             | 2x4      | VENT BOX COVER | SITE: TRINI GROUP, Richmond Hill |
|                     |          |                | MODEL: VILLA 6X EL 1.2.3         |
|                     |          |                | DESIGNER: KS                     |
|                     |          |                | DATE: OCT 19 23                  |
|                     |          |                | LOT #:                           |



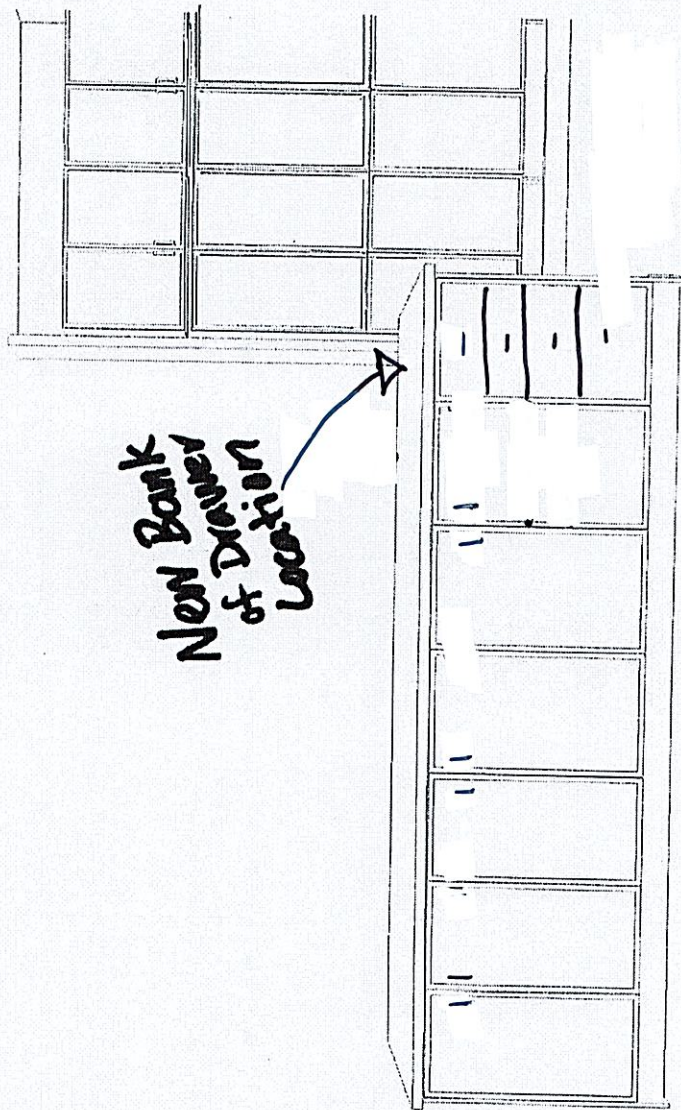

New Bank  
of Drawer  
Location

|                                                                                                                                                                                                        |                                                                                                                 |                                         |
|--------------------------------------------------------------------------------------------------------------------------------------------------------------------------------------------------------|-----------------------------------------------------------------------------------------------------------------|-----------------------------------------|
| This drawing is the intellectual property of<br>SELBA INDUSTRIES INC. and is an<br>artistic<br>interpretation of the general<br>appearance of the design. It is<br>not meant to be an exact rendition. | <br>Kitchens • Bath Design | Designed: 4/1/2025<br>Printed: 4/1/2025 |
|                                                                                                                                                                                                        |                                                                                                                 | INSIDE<br>ISLAND VIEW                   |
|                                                                                                                                                                                                        |                                                                                                                 | TRNIGROUP LOT 73-APR 1 25               |
|                                                                                                                                                                                                        |                                                                                                                 | LAYOUT Drawing #: 1                     |

May/2025