

CONSTRUCTION SUMMARY - PARTIAL ONLY
Legacy Hill - Trinigroup Development Inc.

PURCHASERS: Zhuo Keng Henry HU and Cuixian WU TEL:

LOT NUMBER	PHASE	HOUSE TYPE	REG. PLAN #		
105	1	Villa 6 Elev 3	65M-4818		
INV#	QTY	EXTRA / CHANGE			

Offer	Note:	Majestic + Const.	RECEIVED MAY 30 2025
-------	-------	-------------------	-------------------------

COUNTER TOP

30,354 29May25	1 - KITCHEN - STONE BACKSPLASH TO BE INSTALLED AROUND WINDOW ABOVE SINK Note:	
30,095 12Nov24	1 - KITCHEN COUNTERTOP - UPGRADE STONE COUNTERTOP Note:	
30,095 12Nov24	1 - KITCHEN BACKSPLASH FULL HEIGHT - UPGRADE STONE COUNTERTOP NoteDOES NOT INCLUDE AREA BEHIND CHIMNEY HOOD TO CEILING	


This Document is Extremely Time Sensitive - Printed 29 May 25 at 13:54

4267

02 colour
Kitchen

Island
cabs
- Sonata
Fossil

Kitchen
uppers & Bases & Pantay

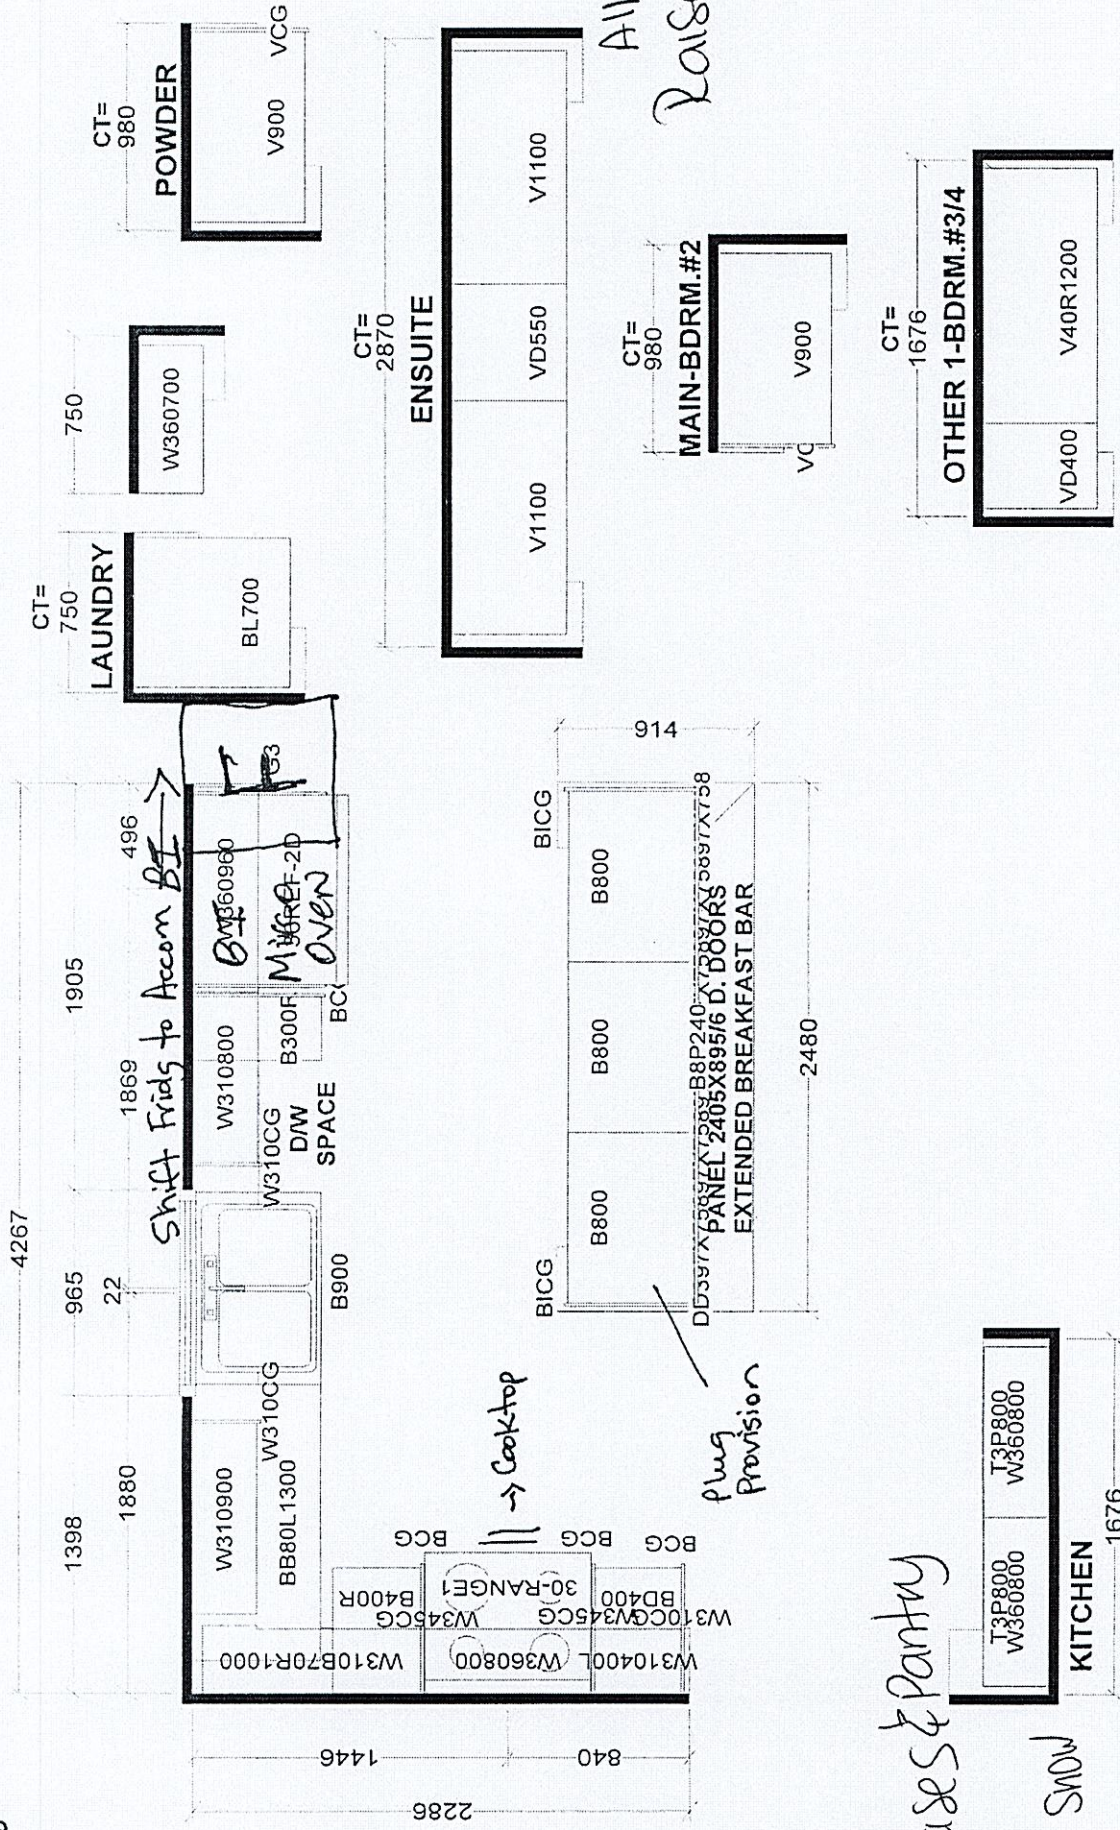

All varieties
Raise to 36"

Selba Industries

井

of JOB NUMBER:

BUILDER: GREENPARK HOMES

SITE: TRINI GROUP, Richmond Hill

MODEL: VILLA 6X EL 1,2,3

LOT #:

This drawing is the intellectual property of SELBA INDUSTRIES INC. and is an original design which must not be released or copied unless applicable fee has been paid or job order placed.

DESIGNER: KS


DATE: OCT 19 23

Frameless Shower Door

Center light above
island

Gas Line

-Tub to Shower

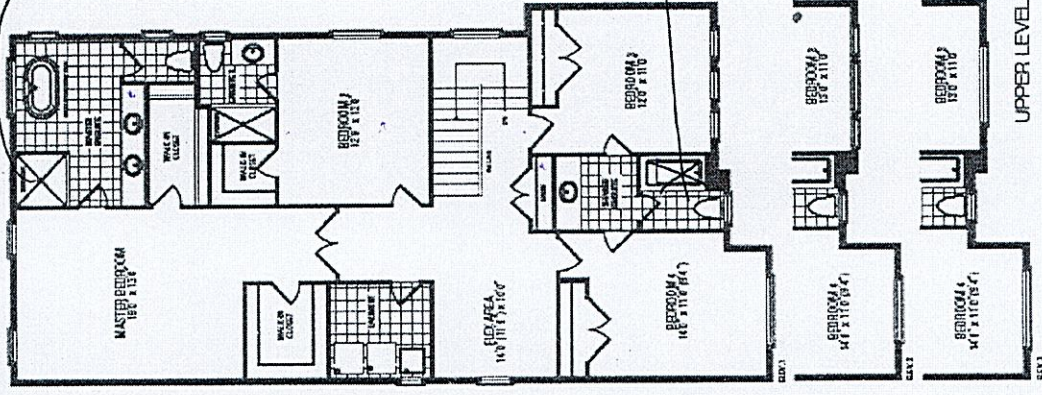

UPPER LEVEL

LOWER LEVEL

Orientation of home may be reversed and purchaser agrees to accept the same. Steps and porches may vary at any exterior entrance ways due to grading variance. Actual usable floor space may vary from the stated floor areas. All renderings are artist's concept. Dimensions, specifications and architectural detailing subject to modifications. Roofline and adjoining model types may vary due to siting. E. & O. E. September 2023