



CONSTRUCTION SUMMARY - PARTIAL ONLY

Legacy Hill - Trinigroup Development Inc.

RECEIVED

PURCHASERS: Pauline M.YAP and Dalton Frances YAP

JUL 22 2025

TEL:

LOT NUMBER	PHASE	HOUSE TYPE	REG. PLAN #		
98	1	Villa 12 Elev 2	65M-4818		
INV#	QTY	EXTRA / CHANGE			

Offer	Note:
-------	-------

URGENT



Revised Kitchen CABINetry NEW - Selba

30,223 21Jul25	1 - DELETE DOUBLE HEADER CROWN MOLDING CM11 AS PER SELBA DOES NOT FIT INSERT 868 MINI UPPERS WITH MODIFIED CROWN & HEADER Note: See sketch attached
30,019 03Mar25	1 - CABINetry - BEDROOM 4 ENSUITE RAISE VANITY TO 36" HIGH VANITY IN LIEU OF STANDARD HEIGHT Note:
30,019 03Mar25	1 - CABINetry - MASTER ENSUITE RAISE VANITY TO 36" HIGH VANITY IN LIEU OF STANDARD HEIGHT Note:
30,019 03Mar25	1 - CABINetry - POWDER ROOM RAISE VANITY TO 36" HIGH VANITY IN LIEU OF STANDARD HEIGHT Note:
30,019 03Mar25	1 - CABINetry - SHARED ENSUITE 2/3 RAISE VANITY TO 36" HIGH VANITY IN LIEU OF STANDARD HEIGHT Note:
30,019 03Mar25	1 - CABINetry - KITCHEN - LIGHT VALANCE Note:
30,019 03Mar25	1 - KITCHEN CABINetry - MINI STACKED UPPER CABINETS - STANDARD LEVEL - KITCHEN (BASED ON STANDARD PLAN) Note:
30,019 03Mar25	1 - CABINetry - KITCHEN - CROWN MOULDING WITH HEADER -CM11 Note:
30,019 03Mar25	1 - CABINetry - KITCHEN - HARDWARE UPGRADE 2 Note:

This Document is Extremely Time Sensitive - Printed 21 Jul 25 at 11:25

TRIM GROUP Lot 98

CH 11

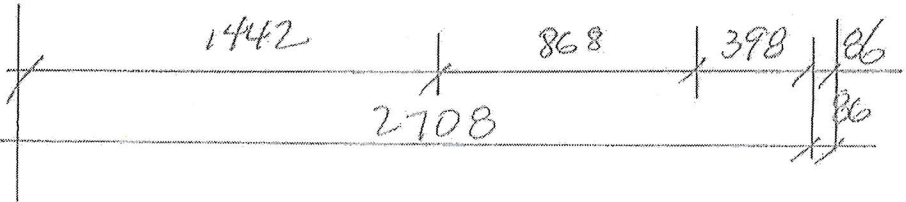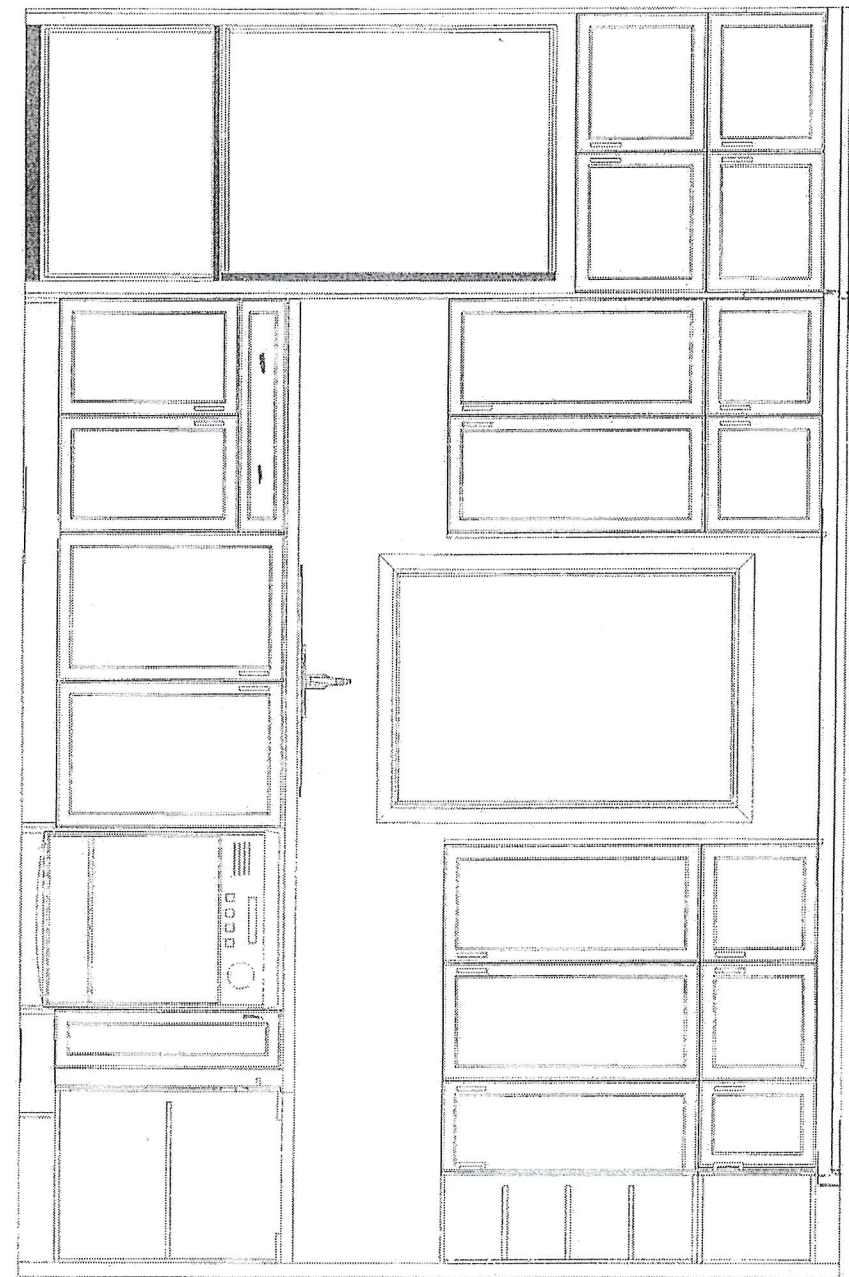

This drawing is the intellectual property of SELBA INDUSTRIES INC. and is an artistic interpretation of the general appearance of the design. It is not meant to be an exact rendition.



Kitchen + Bath Designs

Designed: 7/14/2025
Printed: 7/14/2025



2

2504026

LAYOUT

Drawing #: 1

TRINI GLOUF
Lot 98

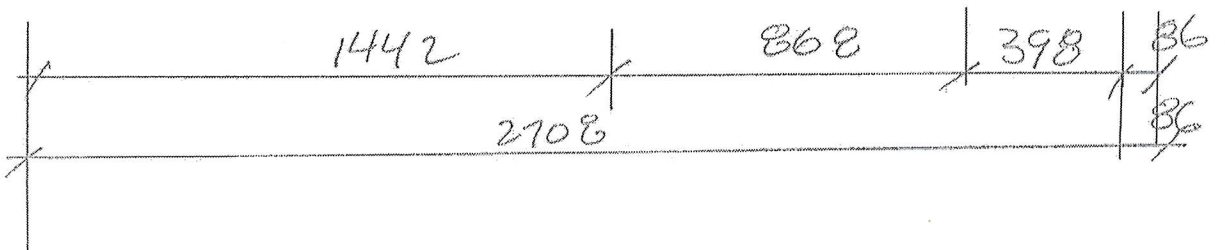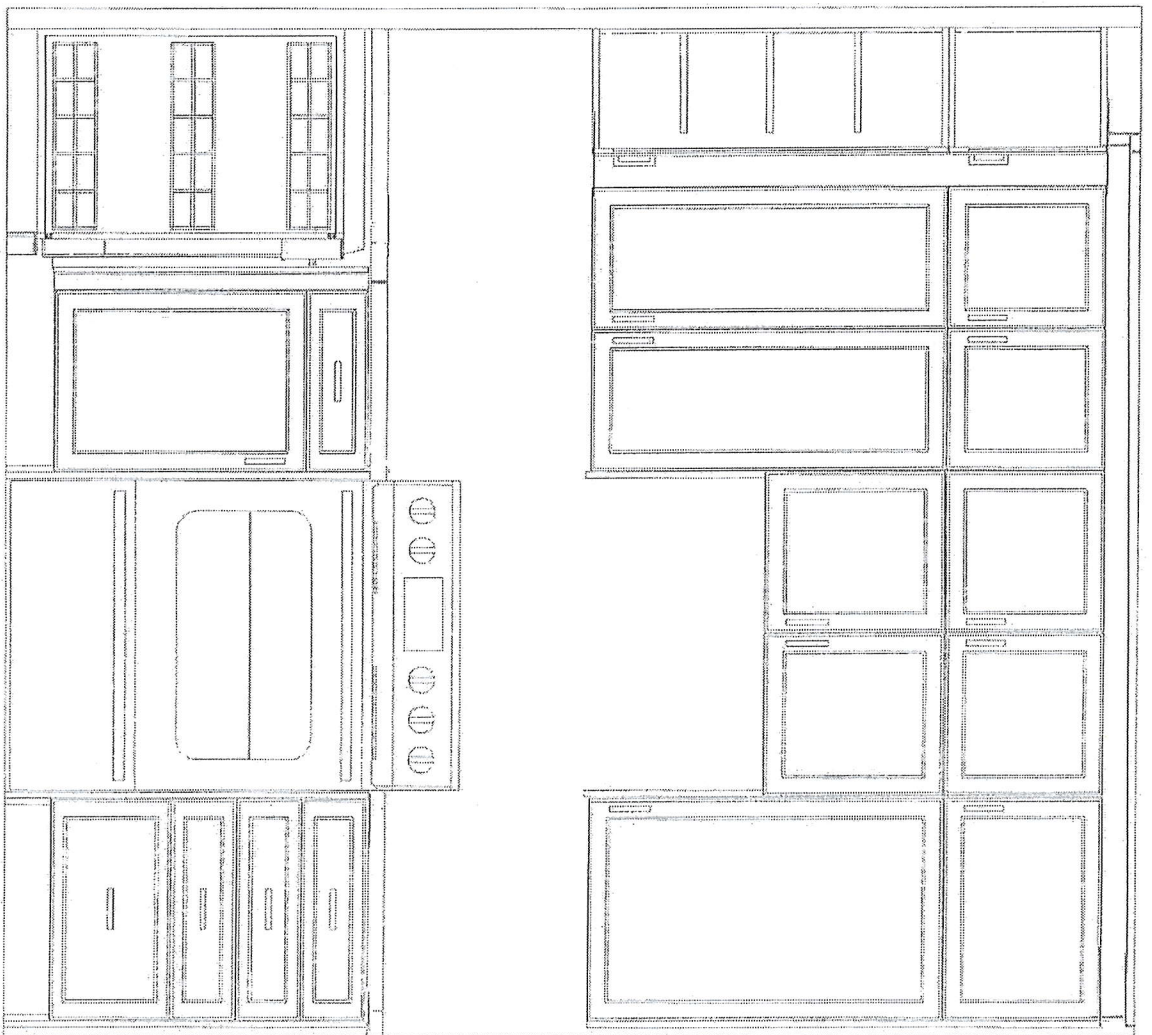

This drawing is the intellectual property of
SELBA INDUSTRIES INC. and is an
artistic
interpretation of the general
appearance of the design. It is
not meant to be an exact rendition.



Designed: 7/14/2025
Printed: 7/14/2025


2

2504026

LAYOUT

Drawing #: 1

Remi Group
Lot 98

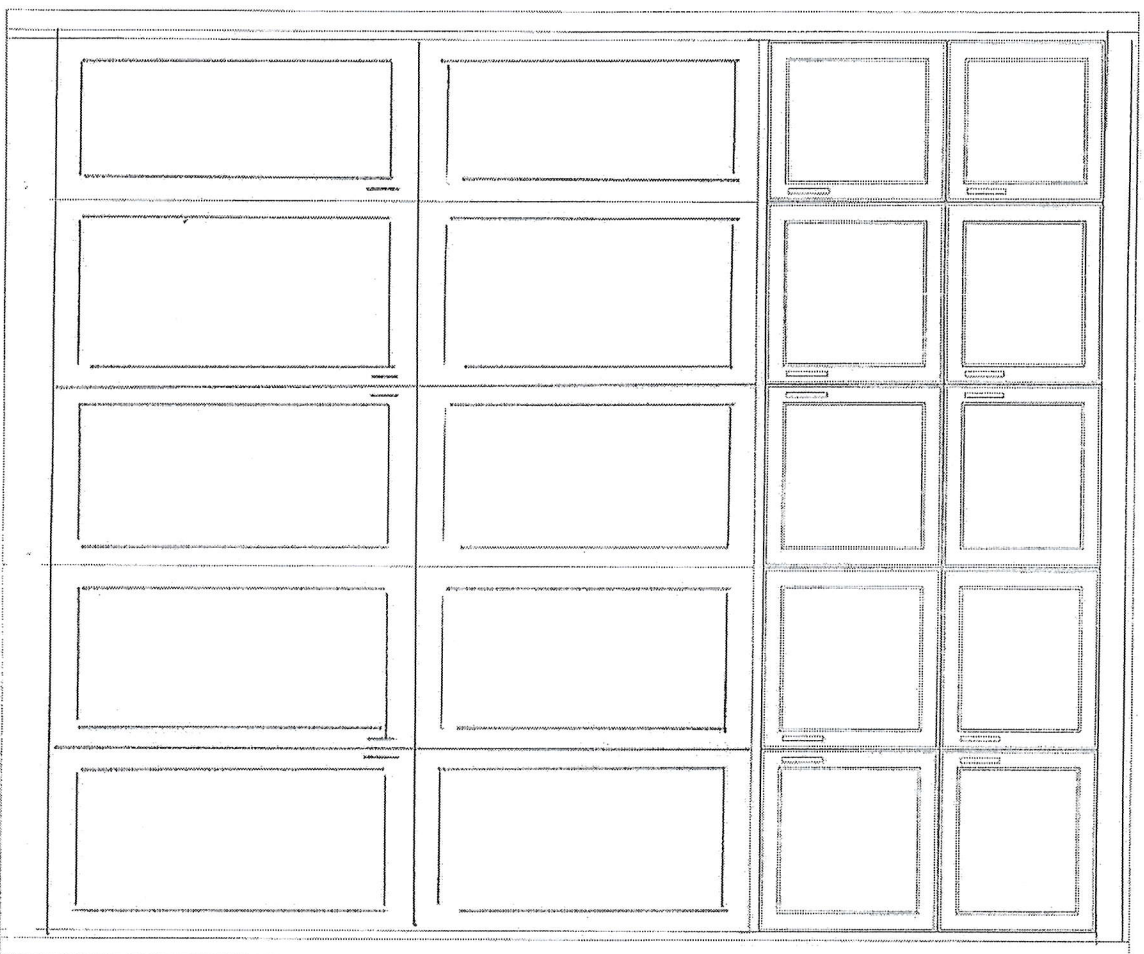

2708

98

This drawing is the intellectual property of
SELBA INDUSTRIES INC. and is an
artistic
interpretation of the general
appearance of the design. It is
not meant to be an exact rendition.



Kitchen + Bath Design

Designed: 7/14/2025
Printed: 7/14/2025

2

2504026

LAYOUT

Drawing #: 1