


- STORM CONNECTION
 --- SANITARY CONNECTION
 W- WATER CONNECTION
 H- HYDRO CONNECTION
 □ DOUBLE CATCH BASIN
 □ CATCH BASIN
 ○ HYDRANT
 ⊗ VALVE AND CHAMBER
 △ ENTRANCE DOOR LOCATION
 ▲ GARAGE DOOR LOCATION
 * ENGINEERED FILL LOT
 ● SANITARY MANHOLE
 ○ STORM MANHOLE
 [MAN] COMMUNITY MAILBOX
 ○ DOWNSPOUT LOCATION
 → SWALE DIRECTION
 ● STREET LIGHT
 ▲ TRANSFORMER
 ⊠ CABLE TV PEDESTAL
 ■ BELL PEDESTAL
 [M] HYDRO METER
 ⊕ GAS METER
 ⊗ AIR-CONDITIONING UNIT
 (SP) SUMP PUMP
 F.F.L.R. FINISHED FLOOR ELEVATION
 T.WALL TOP OF FOUNDATION WALL
 F.SLAB FIN. BASEMENT FLOOR SLAB
 U.F.T.G. UNDERSIDE FOOTING ELEVATION
 100.00 PROPOSED 3:1 SLOPE
 (100.00) PROPOSED GRADE
 SW EXISTING GRADE
 ×100.00 PROPOSED SWALE GRADE

COTTRELLE BOULEVARD

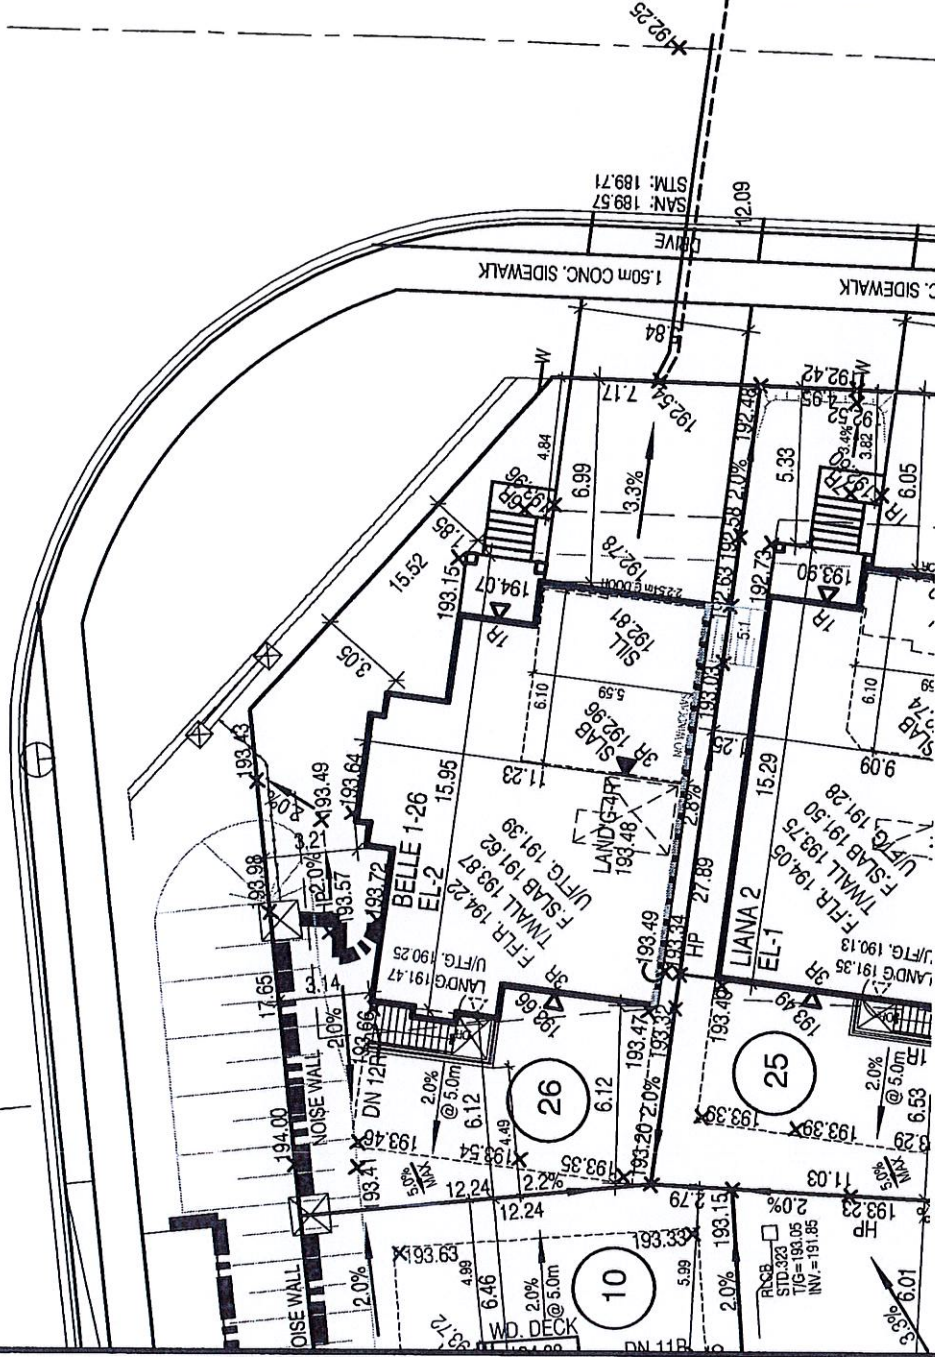

THORNDALE ROAD

SITE PLAN REVIEW

LOT NO. 26 REGISTERED PLAN H34-2017
 THE PROPOSED LOT GRADING AND DRAINAGE IS APPROVED AS BEING IN CONFORMITY WITH THE OVERALL APPROVED GRADING PLANS FOR THE SUBDIVISION
 THIS REVIEW DOES NOT WARRANT THAT OTHER INFORMATION SHOWN ON THIS DRAWING IS ACCURATE OR COMPLETE. SOLE RESPONSIBILITY FOR DESIGN AND DETAILS SHALL REMAIN WITH THE DESIGNER.

NO COMMENT
 COMMENTS AS NOTED
 REVIEWED BY [Signature]
 DATE 30.01.2017

SDC CANDEVCON LIMITED
 CONSULTING ENGINEERS AND PLANNERS

W Architect Inc.
DESIGN CONTROL REVIEW

FEB. 11, 2019

FINAL BY: MMI

This stamp is only for the purposes of design control and carries no other professional obligations.

45 MINUTE RATED WALL
 WITH SIDE YARD < 1.2m

5	
4	
3	
2	JAN. 7, 2019 ISSUED FOR PERMIT
1	NOV. 22, 2018 ISSUED FOR ENGINEERS GRADING REVIEW.

REVISIONS:

The undersigned has reviewed and takes responsibility for this design and has the qualifications and meets the requirements set out in the Ontario Building Code to be a designer.

QUALIFICATION INFORMATION
 Required unless design is completed under Division C, Subsection 13.2 of the Building Code

NAME: Walter Botter
 SIGNATURE: [Signature]
 BCIN: 21037

REGISTRATION INFORMATION
 Required unless design is completed under Division C, Subsection 13.2 of the Building Code

jardin design group inc. 27763

FIRM NAME: BCIN

GREENYORK HOMES
 SCALE 1:250
 5m 0m 10m

GRANELLI HOMES

PROJ. No. 17-55 MUNICIPAL ADDRESS

LOT No. 26

REG. PLAN
 PLAN OF SUBDIVISION OF PART OF BLOCK 203,
 PLAN 43M-1677 AND PART OF BLOCK 111,
 PLAN 43M-1712 CITY OF BRAMPTON
 REGIONAL MUNICIPALITY OF PEE



BILD

jardin
 DESIGN GROUP INC.

64 JARDIN DR. SUITE 3A
 VAUGHAN ONT. L4K 3P3
 TEL: 905 660-3377 FAX: 905 660-3713
 EMAIL: info@jardindesign.ca

AS CONSTRUCTED INCREASINGLY MUST BE VERIFIED PRIOR TO POURING FOOTINGS.
 JARDIN DESIGN GROUP INC. HAS NOT BEEN LICENSED TO PARTICIPATE IN GENERAL
 CONTRACTING AND ASSUMES NO RESPONSIBILITY FOR THE FAILURE OF
 THE CONSTRUCTION OF THE PROJECT OR FOR THE CONSTRUCTION OF THE WORK
 IN ACCORDANCE WITH THE CONTRACT DOCUMENTS.
 THIS DRAWING IS AN INSTRUMENT OF SERVICE. IT IS PROVIDED BY JARDIN INC.
 AND IS NOT TO BE REPRODUCED OR TRANSMITTED IN ANY FORM OR BY ANY MEANS
 ELECTRONIC OR MECHANICAL, INCLUDING PHOTOCOPYING, RECORDING, OR BY ANY INFORMATION
 STORAGE AND RETRIEVAL SYSTEM, WITHOUT PERMISSION IN WRITING FROM JARDIN DESIGN GROUP INC.