

## SITE PLAN REVIEW


LOT NO 37 REGISTERED PLAN ✓

THE PROPOSED LOT GRADING AND DRAINAGE IS APPROVED AS BEING IN CONFORMITY WITH THE OVERALL APPROVED GRADING PLANS FOR THE SUBDIVISION.

THIS REVIEW DOES NOT WARRANT THAT OTHER INFORMATION SHOWN ON THIS DRAWING IS ACCURATE OR COMPLETE. SOLE RESPONSIBILITY FOR THE DESIGN AND DETAILS SHALL REMAIN WITH THE DESIGNER.

NO COMMENT ☒ REVIEWED BY DL

COMMENTS AS NOTED ☐ DATE Dec. 7, 2013

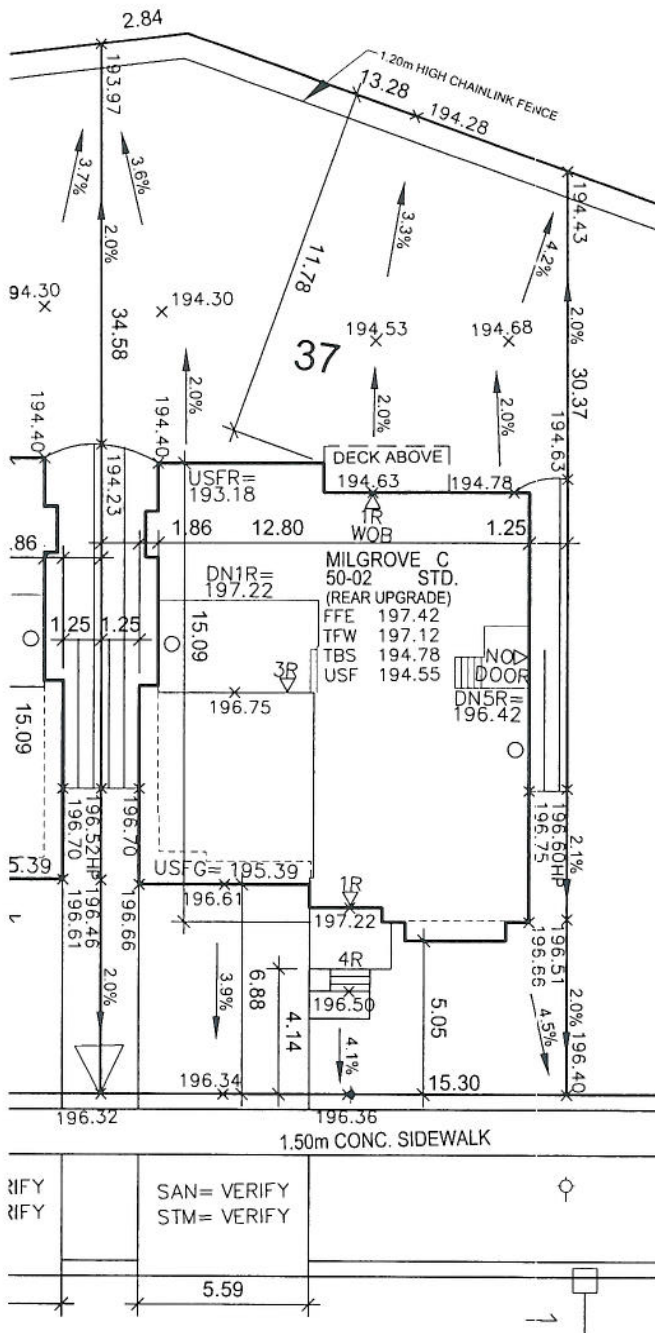

## DEGREY DRIVE

NOTES:  
THE ENGINEERING PLANS HAVE NOT BEEN FINALIZED  
BY THE CITY AND ARE SUBJECT TO CHANGE.

SANITARY AND STORM INVERTS ARE NOT AVAILABLE AT THE TIME OF SITING; BUILDER TO VERIFY ELEVATIONS OF SANITARY AND STORM LATERALS IN RELATION TO BASEMENT USE ELEVATIONS FOR COMPLIANCE WITH MUNICIPAL STANDARDS PRIOR TO EXCAVATION.

It is the builder's complete responsibility to ensure that all plans submitted for approval fully comply with the Architectural Guidelines and all applicable regulations and requirements including zoning provisions and any provisions in the subdivision agreement. The Control Architect is not responsible in any way for examining or approving site (lotting) plans or working drawings with respect to any zoning or building code or permit matter or that any house can be properly built or located on its lot.

This is to certify that these plans comply with the applicable Architectural Design Guidelines approved by the City of BRAMPTON.

ARCHITECTURAL REVIEW &amp; APPROVAL

DEC 09/2015

John G. Williams Limited, Architect



NOTE: BUILDER TO VERIFY LOCATION OF ALL HYDRANTS, STREET LIGHTS, TRANSFORMERS AND OTHER SERVICES. IF MIN. DIMENSIONS ARE NOT MAINTAINED BUILDER IS TO RELOCATE AT HIS OWN EXPENSE.

CLIENT  
HIGHCASTLE HOMES

PROJECT/LOCATION  
RIVERWALK, PHASE 2  
BRAMPTON, ON

DRAWING

SITE PLAN

## BUILDING STATISTICS

REG. PLAN No.	
ZONE	R1F-15.0-2163
LOT NUMBER	37
LOT AREA(m) <sup>2</sup>	505.34
BLDG AREA(m) <sup>2</sup>	N/A
LOT COVERAGE(%)	N/A
No. OF STOREYS	2
MEAN HEIGHT(m)	9.48
INT. GARAGE DIMS(m)	5.49 x 6.10
GARAGE DOOR WIDTH(m)	2 x 2.44

### LEGEND

FFE	FINISHED FLOOR ELEVATION
TFW	TOP OF FOUNDATION WALL
TBS	TOP OF BASEMENT SLAB
USF	UNDER SIDE FOOTING
USFR	UNDER SIDE FOOTING @ REAR
USFG	UNDER SIDE FOOTING @ GARAGE
TEF	TOP OF ENGINEERED FILL
R	NUMBER OF RISERS TO GRADE
WOD	WALKOUT DECK
LOB	LOOKOUT BASEMENT
WOB	WALK OUT BASEMENT
REV	REVERSE PLAN
STD	STANDARD PLAN
△	DOOR
○	WINDOW
⊠	BELL PEDISTAL
▣	CABLE PEDISTAL
□	CATCH BASIN
▤	DBL. CATCH BASIN
✱	ENGINEERED FILL
⊕	HYDRO CONNECTION
⦿	FIRE HYDRANT
● SL	STREET LIGHT
✉	MAIL BOX
⏚	TRANSFORMER
⊗	WATER VALVE
◆	WATER CONNECTION
▽	SEWER CONNECTIONS 2 LOTS
∇	SEWER CONNECTIONS 1 LOT
⌞ AC	AIR CONDITIONING
⊞→	DOWN SPOUT TO SPLASH PAD
→	SWALE DIRECTION
—x—	CHAINLINK FENCE
—xx—	PRIVACY FENCE
—xxx—	SOUND BARRIER
— --	FOOTING TO BE EXTENDED TO 1.25 (MIN) BELOW GRADE

ISSUED OR REVISION COMMENTS
-----------------------------

[illegible]

I, NATALIE PANDOLFI, DECLARE THAT  
I HAVE REVIEWED AND TAKE DESIGN RESPONSIBILITY

I, Natalie Pandolfi declare that I have reviewed and take design responsibility for the design work on behalf of RN Design Limited under subsection 3.2.4 of the Building Code. I am qualified, and the firm is registered, in the appropriate class/categories.

**QUALIFIED DESIGNER BCIN 41549**

FIRM BCIN 26995

DATE \_\_\_\_\_ SIGNATURE \_\_\_\_\_

DATE \_\_\_\_\_ SIGNATURE \_\_\_\_\_

DRAWN BY

SCALE  
1:250

PROJECT No.  
14021

LOT NUMBER  
37



RN design  
Imagine • Inspire • Create

TEL.(905)738-3177  
FAX.(905)738-5449  
DWG@RNDESIGN.COM