




FIRST FLOOR
ELEVATION A, B

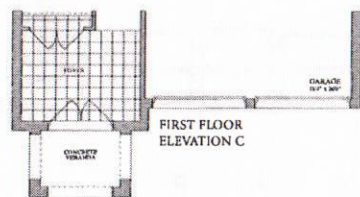

FIRST FLOOR
ELEVATION C

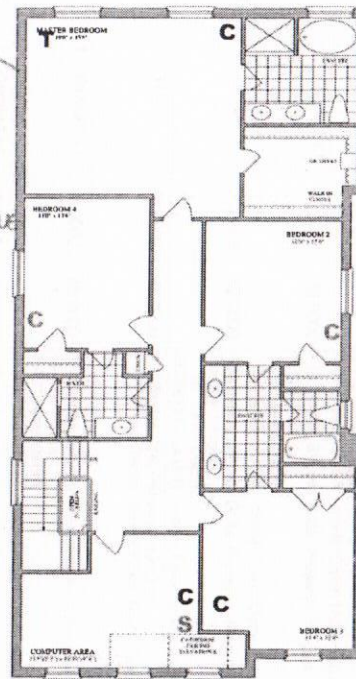


SECOND FLOOR
ELEVATION A, B

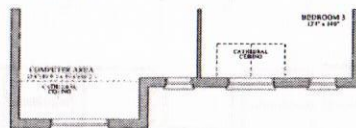


SECOND FLOOR
ELEVATION C

C = CABLE R/I
T = TELEPHONE R/I
S = SMARTWIRE R/I

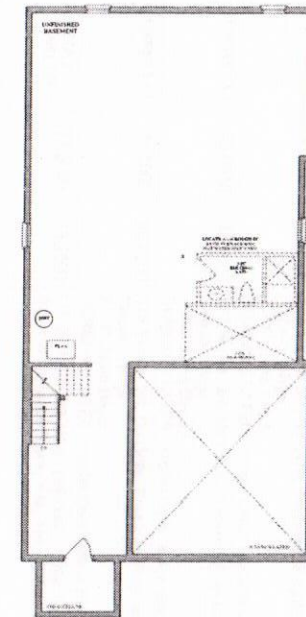

BASEMENT
ELEVATION A, B

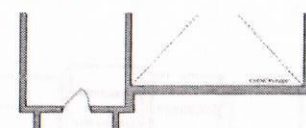

BASEMENT
ELEVATION C

The
LEXINGTON

ELEVATION A 3,240 SQ. FT.
ELEVATION B 3,240 SQ. FT.
ELEVATION C 3,240 SQ. FT.

Lormel
HOUSES

Plans and dimensions are subject to change without notice. All dimensions are approximate. For more information, call 1-800-850-8500.