



REVISED RSO 31'x43'
 CENTER OVER TOILET


LOT 122, Ph 3

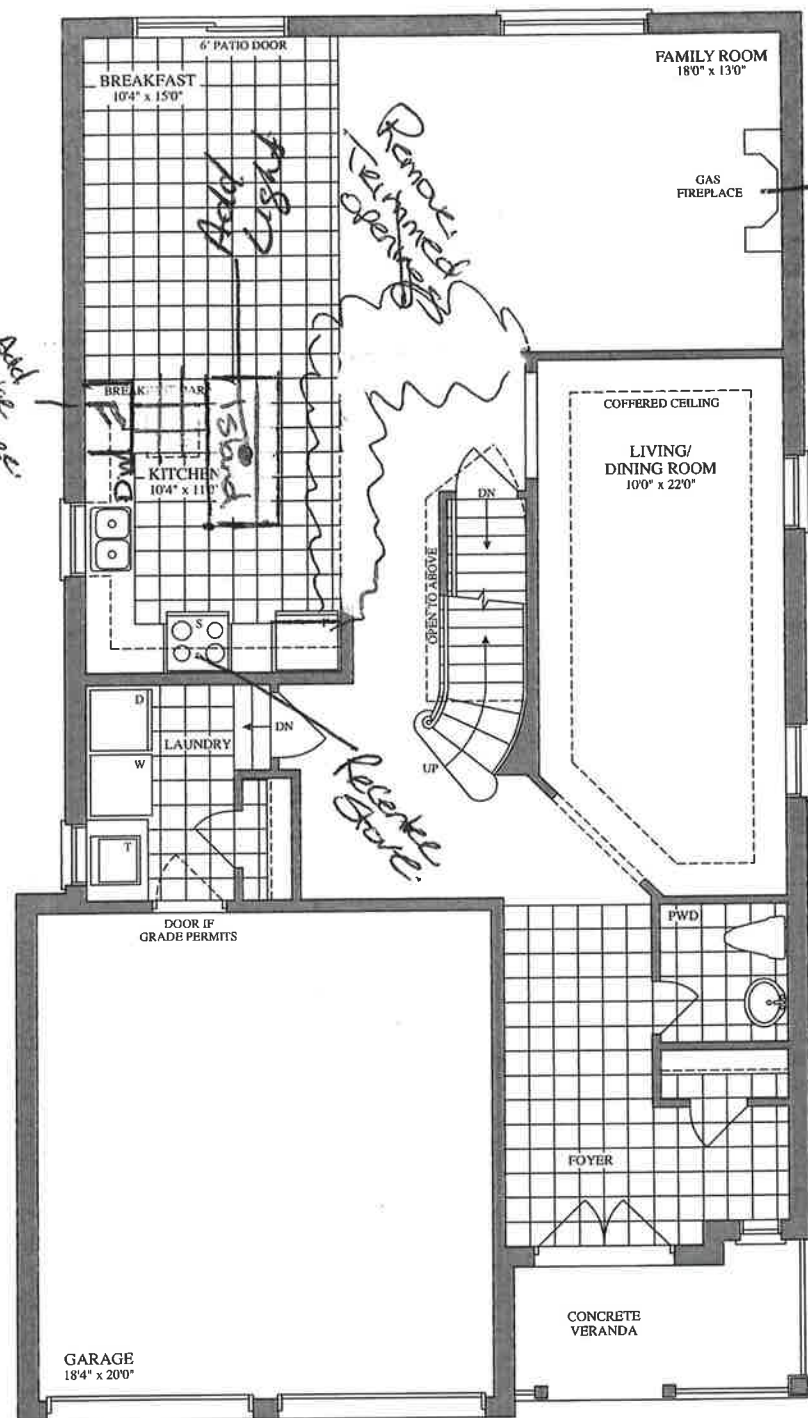


FIRST FLOOR
ELEVATION A, C

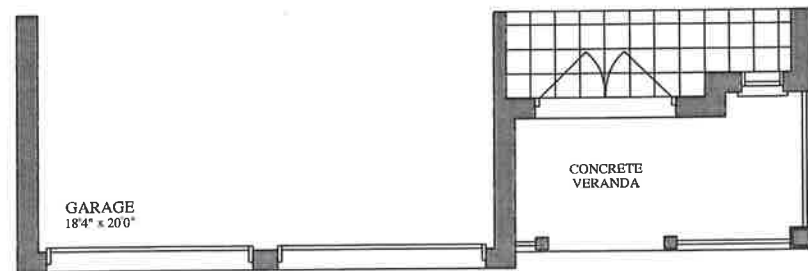


FIRST FLOOR
ELEVATION B

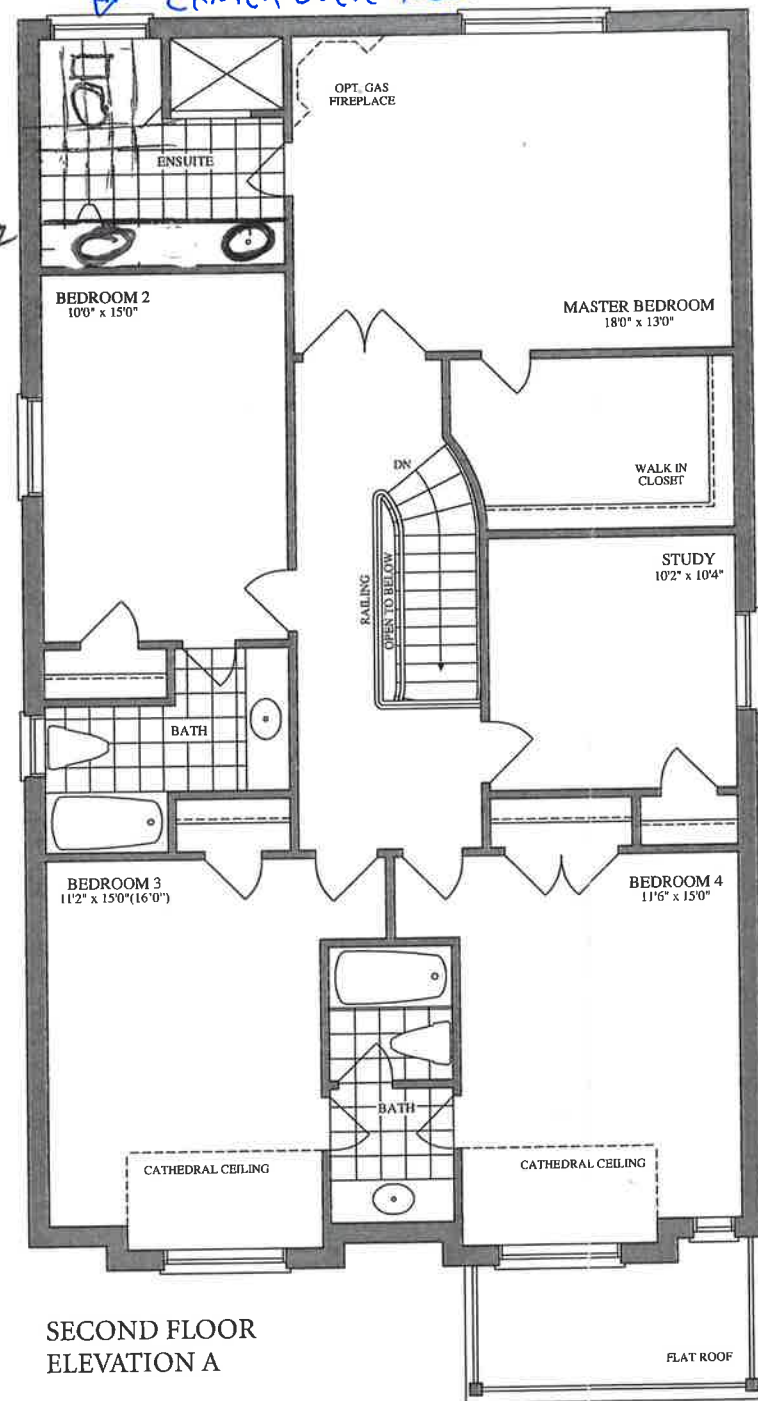


SECOND FLOOR
ELEVATION A

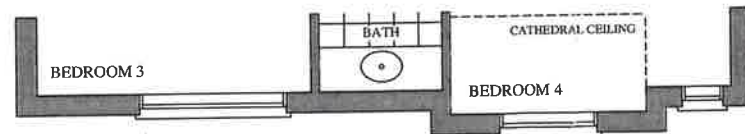

SECOND FLOOR
ELEVATION B

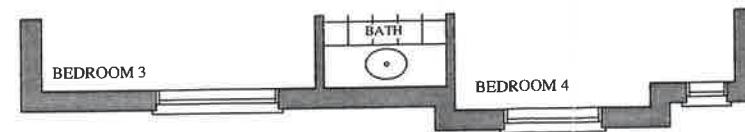

SECOND FLOOR
ELEVATION C

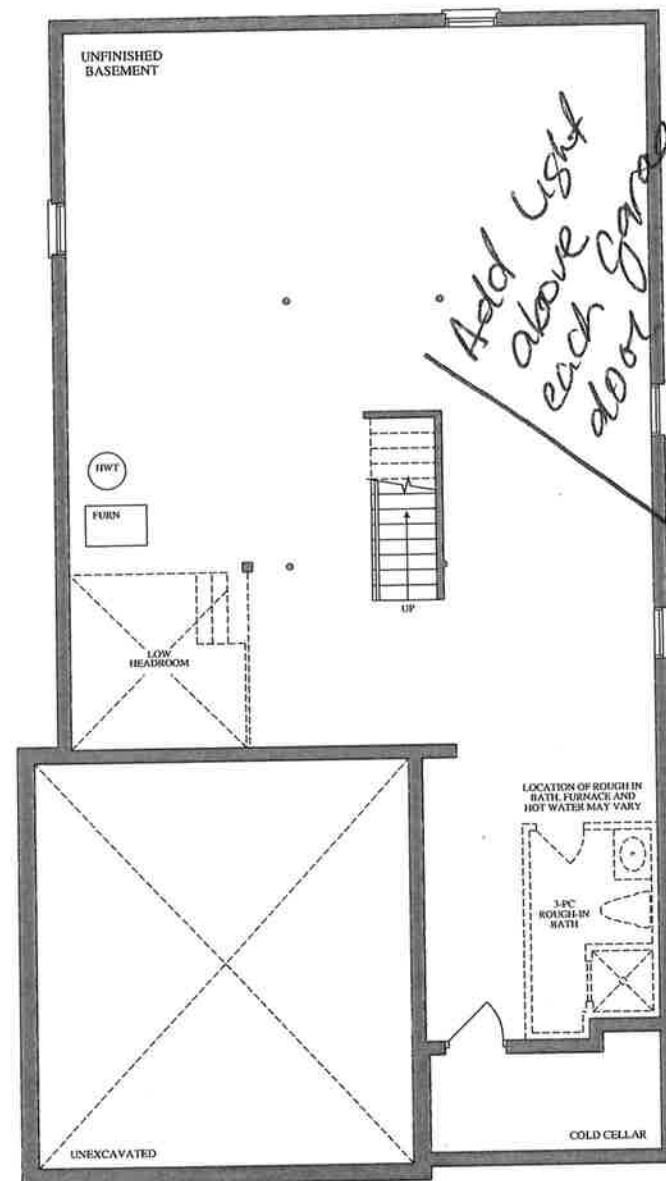

BASEMENT
ELEVATION A, B, C

The ROSEMOUNT



ELEVATION A ▲ 2,800 SQ. FT.



ELEVATION B ▲ 2,800 SQ. FT.



ELEVATION C ▲ 2,800 SQ. FT.

Lorne
HOMES

Plans and specifications are subject to change without notice. E. & O. E. Actual usable floor space may vary from the stated floor area. All renderings are artist's concept.