



KIMBERLY 3020

LOT 108

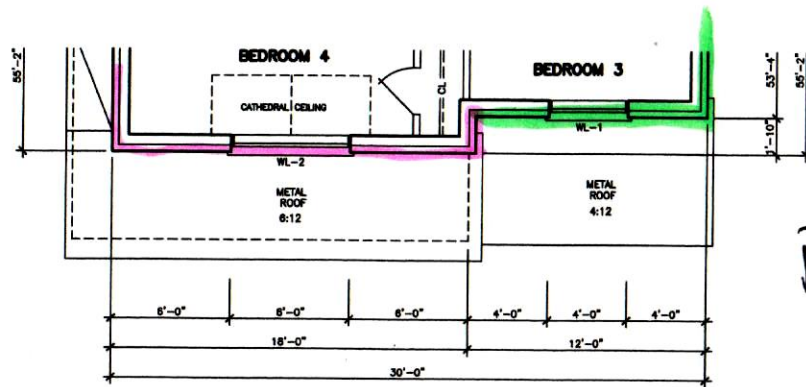


SECOND FLOOR PLAN 'C'

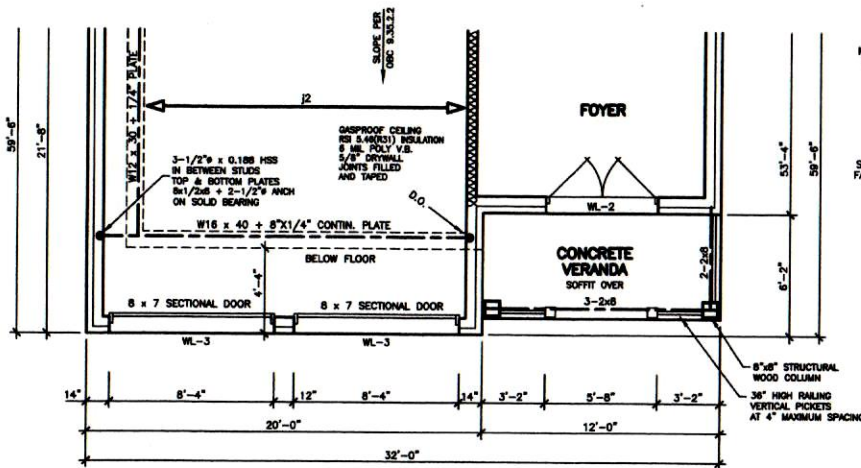

FIRST FLOOR PLAN 'C'

WALLS AND WINDOWS AREA			
ELEVATION	WALL AREA	WINDOWS AREA	%
FRONT ELEVATION	64.70 SM	5.51 SM	
RIGHT SIDE ELEVATION	107.79 SM	8.67 SM	
LEFT SIDE ELEVATION	107.79 SM	4.24 SM	
REAR ELEVATION	107.79 SM	11.71 SM	

STONE
RETURN

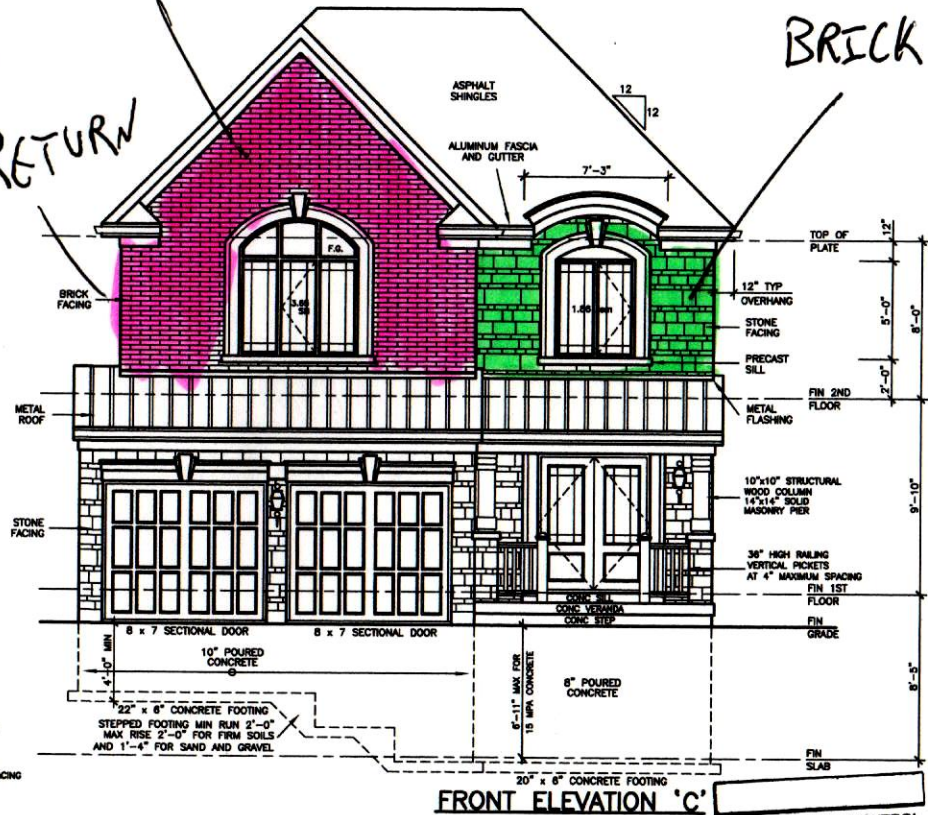

FRONT ELEVATION 'C'

ARCHITECTURAL CONTROL

☒ Approved

☐ Approved as Noted

MARTIN ASSOCIATES

This approval is for architectural control review only as defined by the applicable Community Control Guidelines and does not constitute compliance or

REVISIONS

LEONARD KALUSHENKO
AND ASSOCIATES
STRUCTURAL ENGINEERS
FOR STRUCTURAL DESIGN ONLY



Lorne HOM

ONTARIO ASSOCIATION
OF
ARCHITECTS