



LOT 108

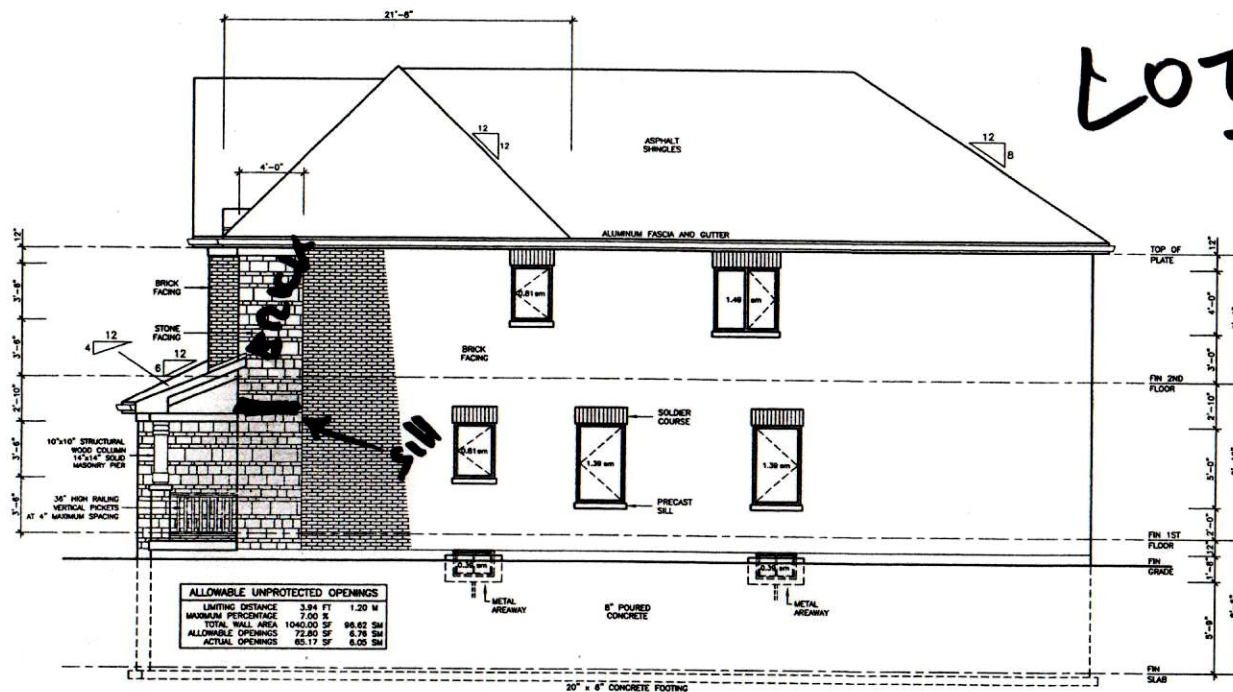

RIGHT SIDE ELEVATION 'C'

DWL TO BE 5/8" TYPE "X" WHERE WALL IS LESS THAN 4" FROM LOT LINE IN GARAGE WHERE THERE IS NO DWL 1/2" DWL TYPE "X" E.S. OF NO STUDS IF WALL IS LESS THAN 4'-0" TO LOT

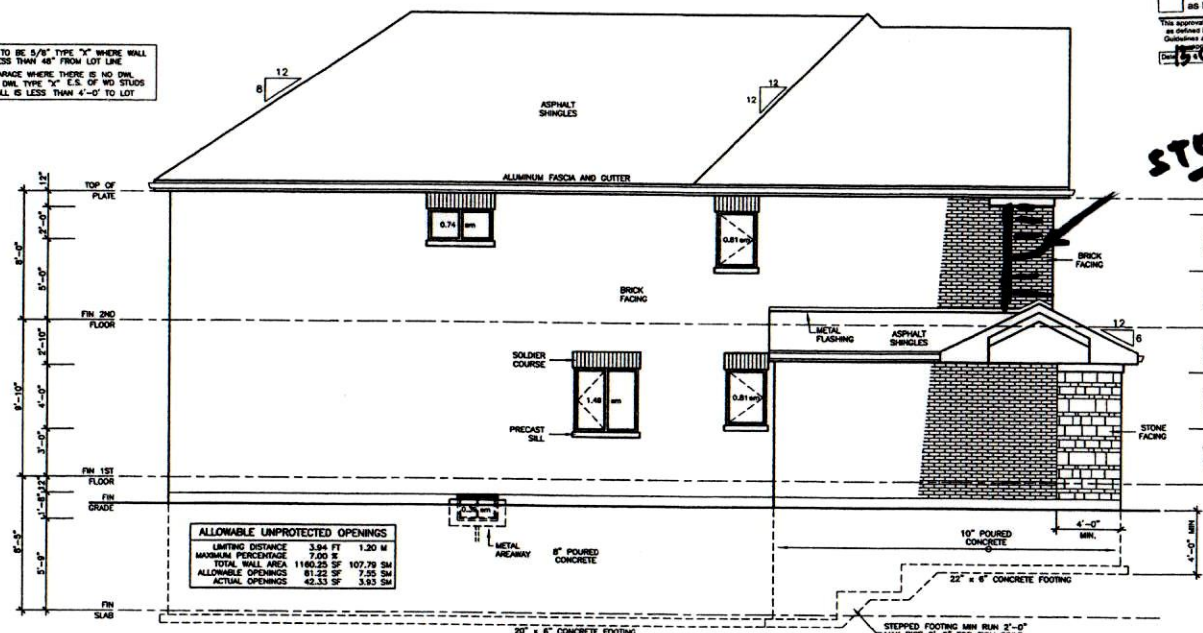

LEFT SIDE ELEVATION 'C'

ARCHITECTURAL CONTROL

☒ Approved ☐ Approved as Noted

MARTIN ASSOCIATES

15-04-2020 - TM

STONE

REVISIONS	
#	DATE



Lormel HOMES



ALL DRAWINGS & SPECIFICATIONS ARE THE PROPERTY OF THE ARCHITECT AND SHOULD BE USED OR REPRODUCED WITHOUT HIS PERMISSION. THE CONTRACTOR SHALL OBTAIN AND VERIFY ALL NECESSARY PERMITS AND SECURE ANY DISCREPANCIES TO THE JOBSITE. DRAWINGS MUST NOT BE SCALED.

ARCHITECTURAL DESIGN INC.
56 PENNSYLVANIA AVE.
UNIT 1
CONCORD, ONT. L4K 3V9
TEL 905 660-8383
FAX 905 660-8418

KIMBERLEY MODEL 3020

PROJECT
PROPOSED
TWO STOREY DWELLING
FOR: LORMEL HOMES
AT: BRADFORD

DRAWING
RIGHT AND LEFT
SIDE ELEVATIONS 'C'

DATE JAN '19 PROJECT NO 19-64
DRAWN N.L. DRAWING NO A-9
CHECKED
SCALE 3/16"=1'-0"