


LOT 108, PHASE 2, BRADFORD

Purchaser Allen

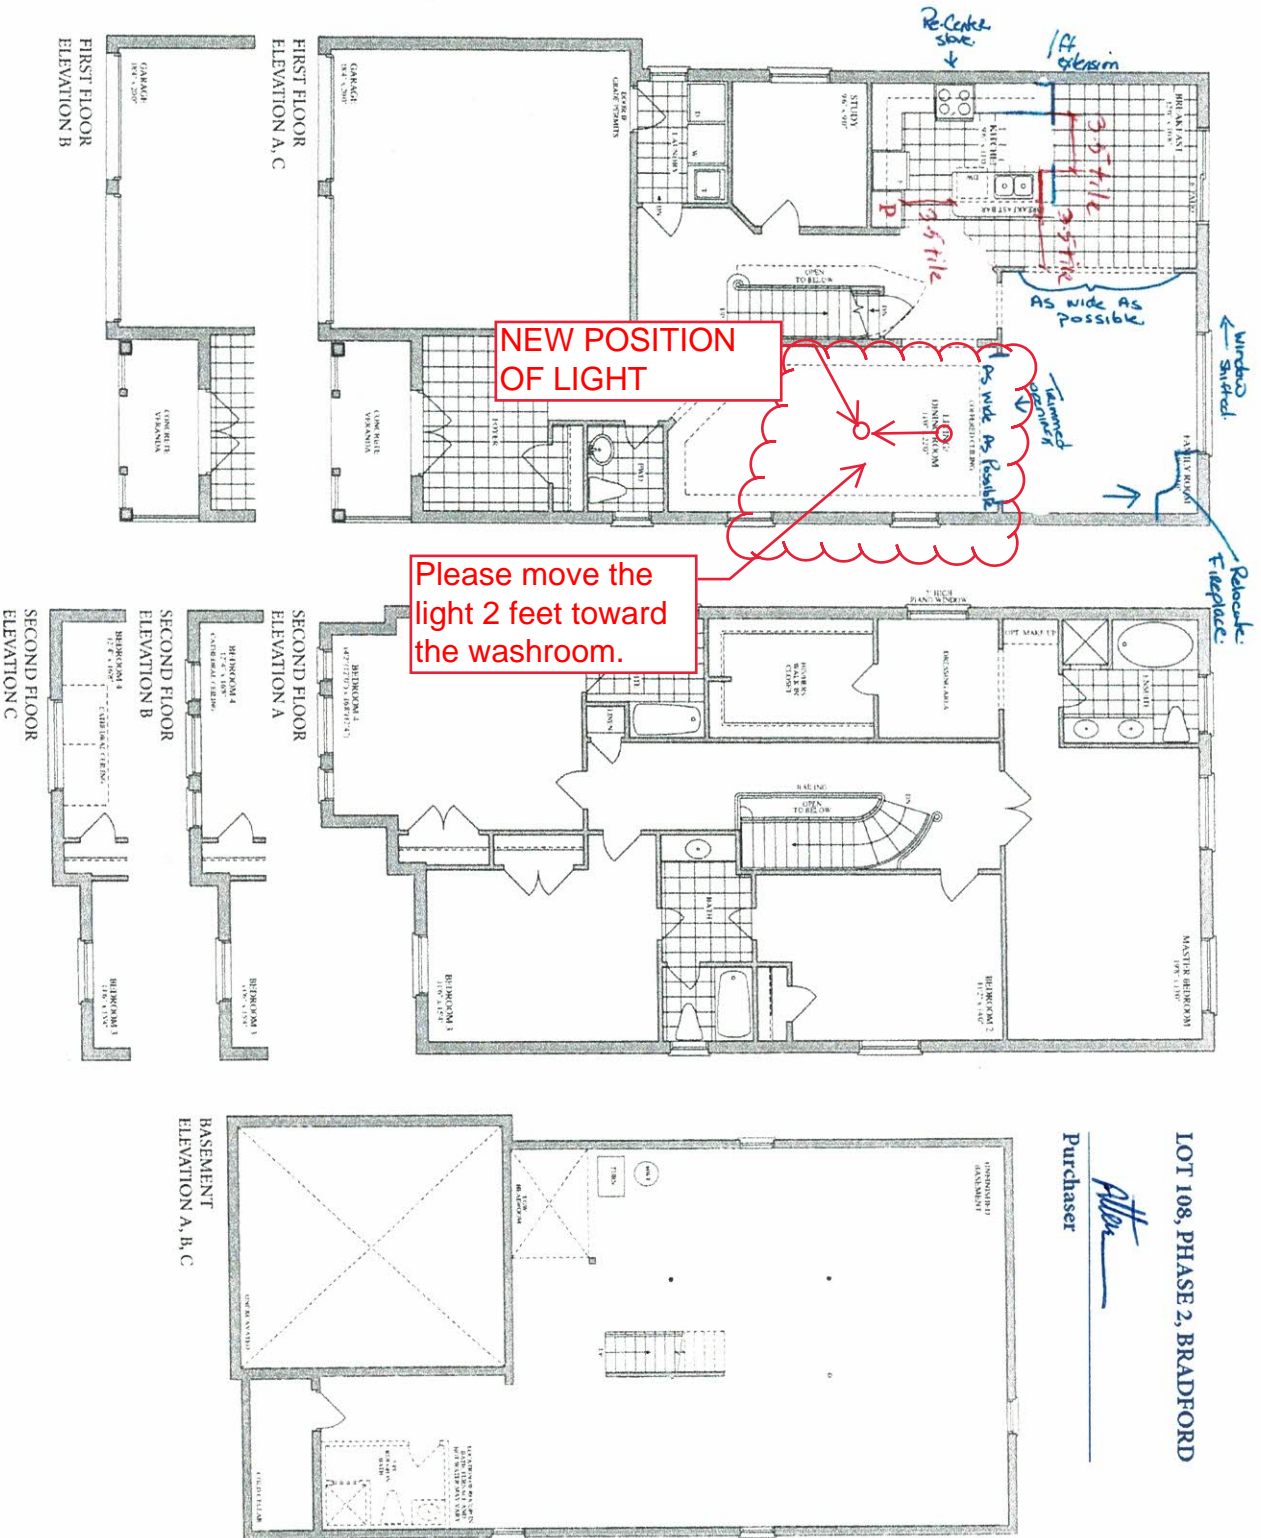


28


The KIMBERLEY




ELEVATION A ▲ 3,020 SQ. FT.



ELEVATION B ▲ 3,020 SQ. FT.



ELEVATION C ▲ 3,020 SQ. FT.



Lorne HOMES

Plans and specifications are subject to change without notice. E.A.D. E. Actual results may vary from the actual floor plans and specifications and are not to be used for construction.