



LIBERTY
CUSTOM CABINETS

1318 CARLAUREN RD., WOODBRIDGE, ONTARIO L4L 8A0
TEL: (905) 856-7678 • FAX: (905) 856-7379
www.libertycustomcabinets.com

QUOTATION

DATE

JOB NO.

TO:

LOMIE

SHIP TO:

BRANER

TYPE OF CABINETS:

FINISH OF CABINETS

HARDWARE

COUNTERTOP

INSTALLATION


WITH

WITHOUT

HOUSE TYPE

REMARKS

LOT # 120

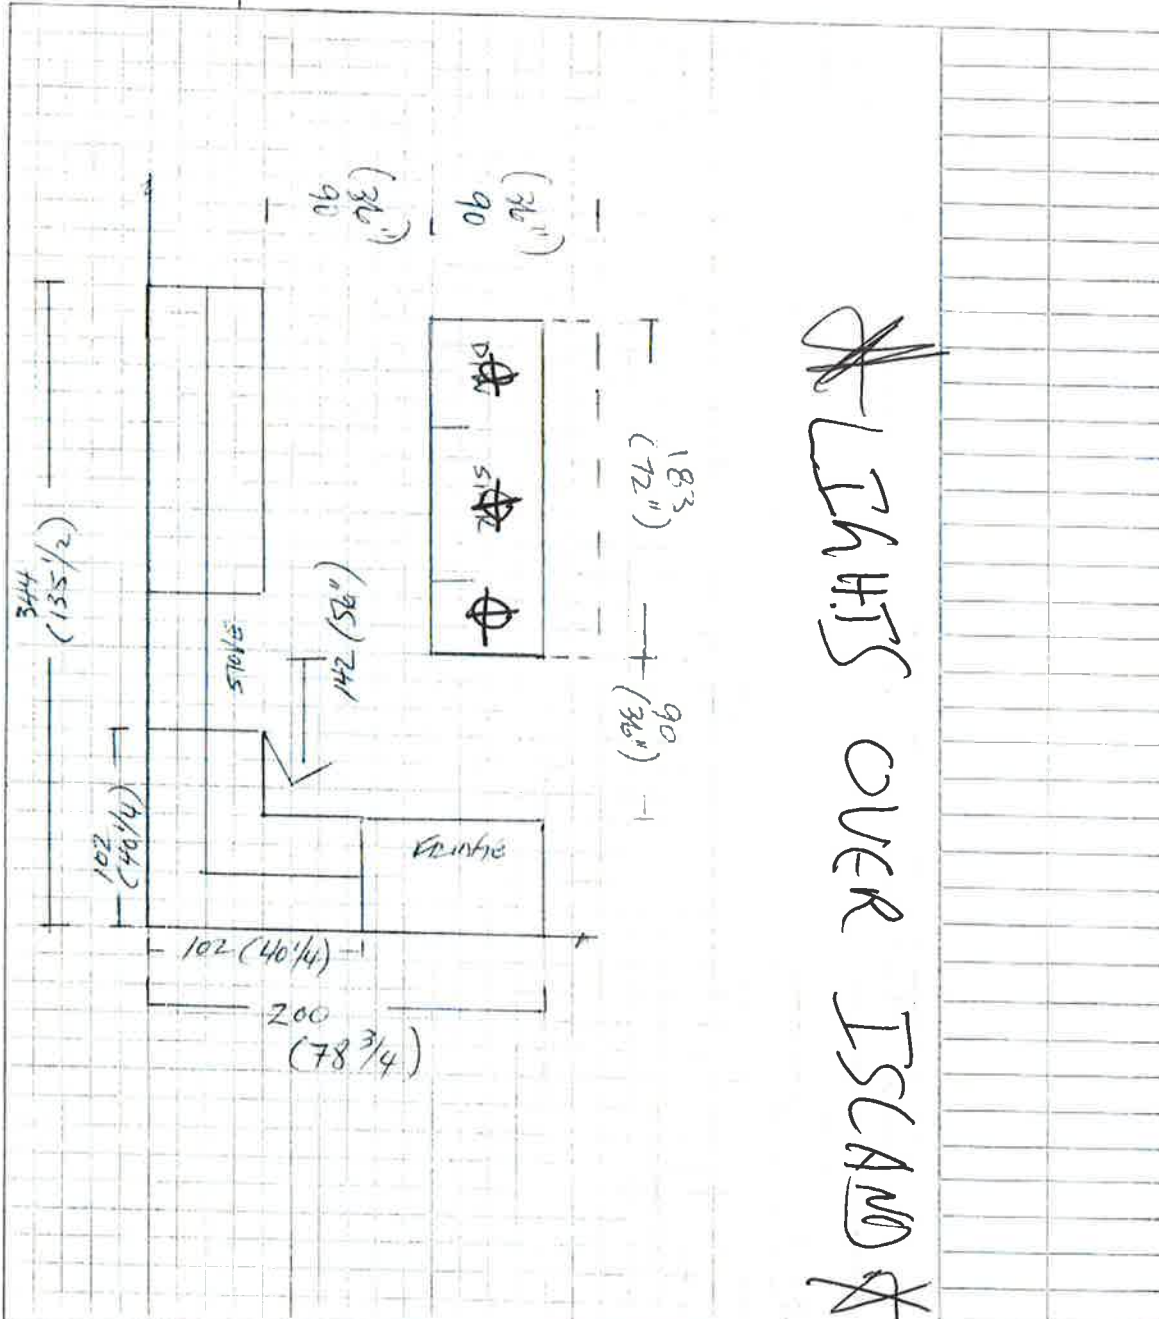

All prices subject to confirmation from head office.
Goods delivered shall be checked and inspected on delivery. We shall not be responsible for any claims or complaints after this inspection.

All agreements are contingent upon strikes, accidents, and delays beyond our control.
Please provide our installer with template for sinkholes or \$100.00 will be charged for callback.

ACCEPTED DATE:

TERMS:

LAYOUT THOROUGHLY EXPLAINED AND FULLY UNDERSTOOD

TOTAL \$

CUSTOMER SIGNATURE

SALESMAN'S SIGNATURE