

Schedule B-3 - Purchaser's Extras

forming part of the Agreement of Purchase and Sale



VENDOR:

LORMEL DEVELOPMENTS (BRADFORD) LTD.

PURCHASER(S): PRE-SITED

LOT NUMBER: PART 002 PHASE: 3

MODEL: Rosemount 2800

P.E.#: 002


It is understood and agreed that no requests for changes, additions or deletions will be accepted by the Vendor for the above extras after the date of acceptance of this order.

No.	DESCRIPTION OF THE PROPERTY OF	P	RICE
	Net upgrades continued from page 1	e 1	5.
11.	Provide and install revised kitchen layout, as per sketch.		
12.	Increase the size of the window in the family room to aprroximately 8'ft wide, as per sketch.		
13.	Increase the size of the window in the master bedroom to aprroximately 8'ft wide, as per sketch.	D	
14.	the sign word between reals make a constraining disting room (to from or powder room), as part		N.
15.	stantes d'utats pagnes (neculationem bas mennonieure), le sance d'attant la mobile par la seconda de la compand		.5
16.	one yeseted niem uso zase. Te w bije sone nodmik bi ne yewika a niche in zavesi itaw iki sa		Ą
17.			1
18.			
19.	common the state well mount TV (institutes declinated confinct, for the fire has each to the state has a confine the fireplace) above the fire of the sacration	944 j	- 64
	Net upgrades continued on page 3	15/4	
	Extra's Subtotal: H.S.T.		\$ 0.00
	New Total: Less Bonus Package (if Applicable) TOTAL:		\$ 0.00 \$ 0.00
	TOTAL		

The above extras and upgrades are to be included during the construction of the above house for the above named purchaser subject to the following terms and conditions:


- The Vendor will undertake to install the above extras but will not be liable to the purchaser if for any reason the work covered by the extra is not carried out. In that event, the price of the extra shall be refunded to the purchaser without any interest.
- It is understood and agreed that if the transaction of Purchase and Sale is not completed for any reason whatsoever, the total cost of this extra is not refundable.

PAID: ______ TERMS: CASH OR CHEQUE IN ADVANCE

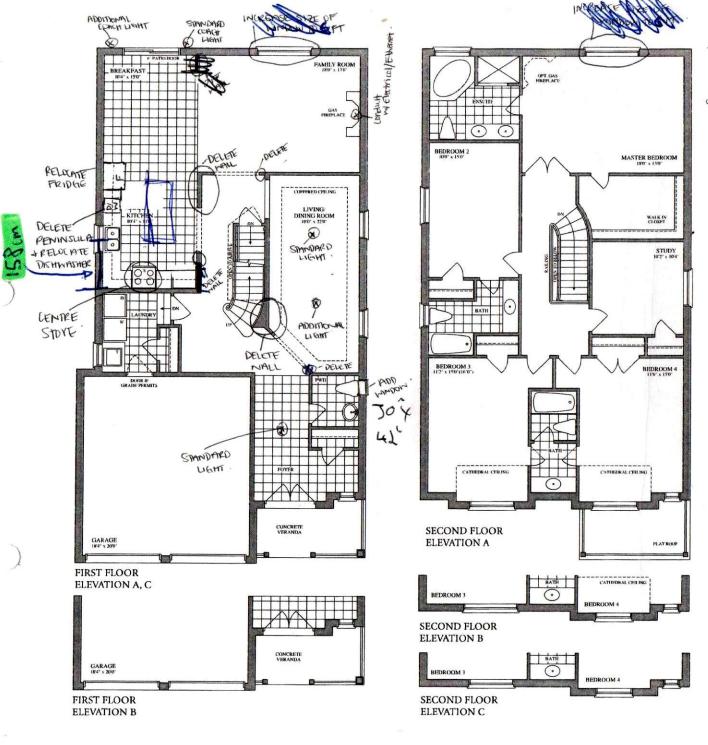

PART 2. BLK 164.

2800 ROSEMOUNT, ELEV. "C"

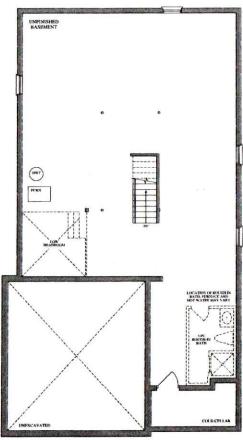

BASEMENT ELEVATION A, B, C