



LORMEL DEVELOPMENTS (BRADFORD) LTD.
PURCHASER EXTRAS

PART # 010 P.E #002 — Model - ROSEMOUNT - 2800

Attention Trades...

The following items below are Purchaser Extras, please make sure that they are done on time and properly complete. Any outstanding items will be Back Charged. If you have any questions please call Roberto Ruiz. Make sure that you review ALL of the items on the Purchaser Extras.

Please be advised that Purchase Orders will come at a later date.

*****Also, it is very important to speak to Roberto Ruiz before starting on site ****

TRADE:		ITEMS TO BE COMPLETED	
North York Tile		#1	
Railing Excellence		#2	
Miranda Painting		#3	
Liberty		#4	
Qsg		#5	

Date: May 04/21
From: Lormel Homes
Site Clerk: Jai Fitzgerald
Site Tel: 905-775-3633
Site Fax: 905-775-9083

NOTE: If more information is needed please call Roberto Ruiz cell-416-688-9324
If more information needed on quotes or changes, please call Zachary 905-832-2023 ext. 224

Schedule B-3 – Purchaser's Extras

forming part of the Agreement of Purchase and Sale

VENDOR:

LORMEL DEVELOPMENTS (BRADFORD) LTD.



PURCHASER(S): Talat Rehan

LOT NUMBER: PART 010 **PHASE: 3**

MODEL: Rosemount 2800

P.E.#: 002

It is understood and agreed that no requests for changes, additions or deletions will be accepted by the Vendor for the above extras after the date of acceptance of this order.

[illegible]

The above extras and upgrades are to be included during the construction of the above house for the above named purchaser subject to the following terms and conditions:

- The Vendor will undertake to install the above extras but will not be liable to the purchaser if for any reason the work covered by the extra is not carried out. In that event, the price of the extra shall be refunded to the purchaser without any interest.
- It is understood and agreed that if the transaction of Purchase and Sale is not completed for any reason whatsoever, the total cost of this extra is not refundable.

PAID:

TERMS: CASH OR CHEQUE IN ADVANCE

Talat Rehan

PURCHASER**PURCHASER**

File Copy for
CORPUS DEVELOPMENTS (SINGAPORE) LTD.


Construction

Office

**(original verified at
Head Office)**

TILE DIRECTION


Purchaser
Initials: TR

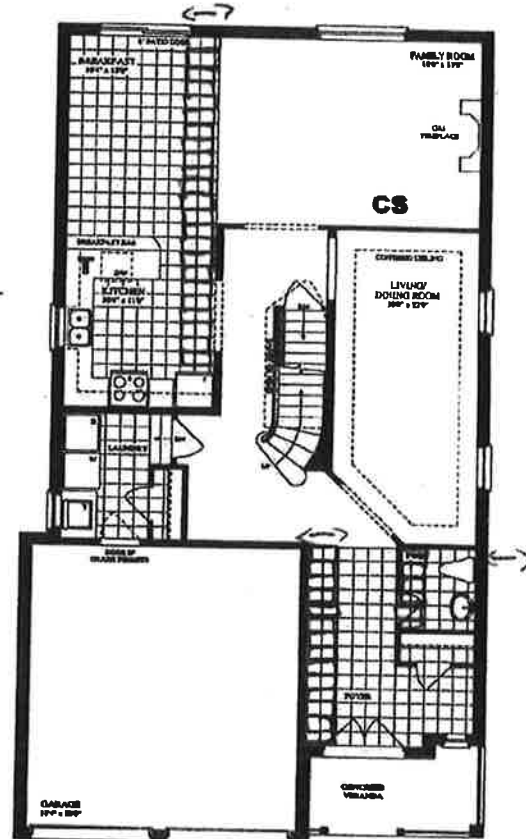


FIRST FLOOR
ELEVATION A, C




FIRST FLOOR
ELEVATION B

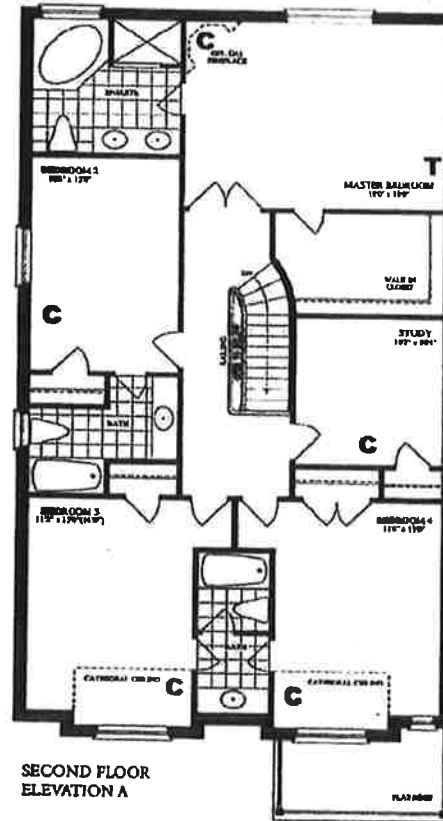

SECOND FLOOR
ELEVATION A

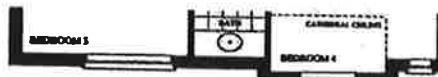


SECOND FLOOR
ELEVATION B

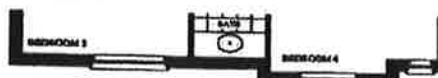

SECOND FLOOR
ELEVATION C

Lot #: 10

C = CABLE R/I
T = TELEPHONE R/I
S = SMARTWIRE R/I

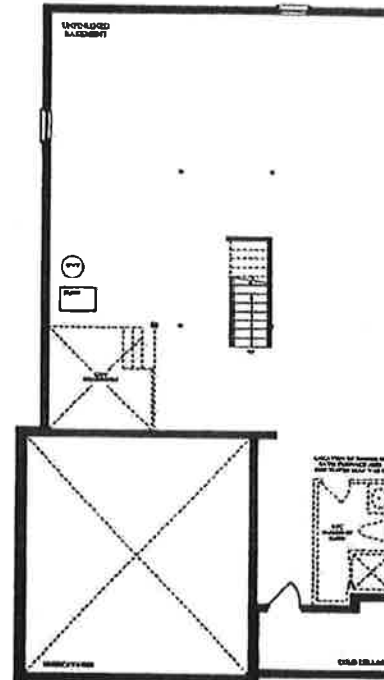

BASEMENT
ELEVATION A, B, C

Purchaser: Talat Rehan

Purchaser: _____

Date: May 28, 2010

The ROSEMOUNT

STYLATION A 2,800 sq. ft.

STYLATION B 2,800 sq. ft.

STYLATION C 2,800 sq. ft.