



LORMEL DEVELOPMENTS (BRADFORD) LTD.


It is understood and agreed that no requests for changes, additions or deletions will be accepted by the Vendor for the above extras after the date of acceptance of this order.

The above extras and upgrades are to be included during the construction of the above house for the above named purchaser subject to the following terms and conditions:

- PAID: _____ TERMS: CASH OR CHEQUE IN ADVANCE

PURCHASER

**(original verified at
Head Office)**

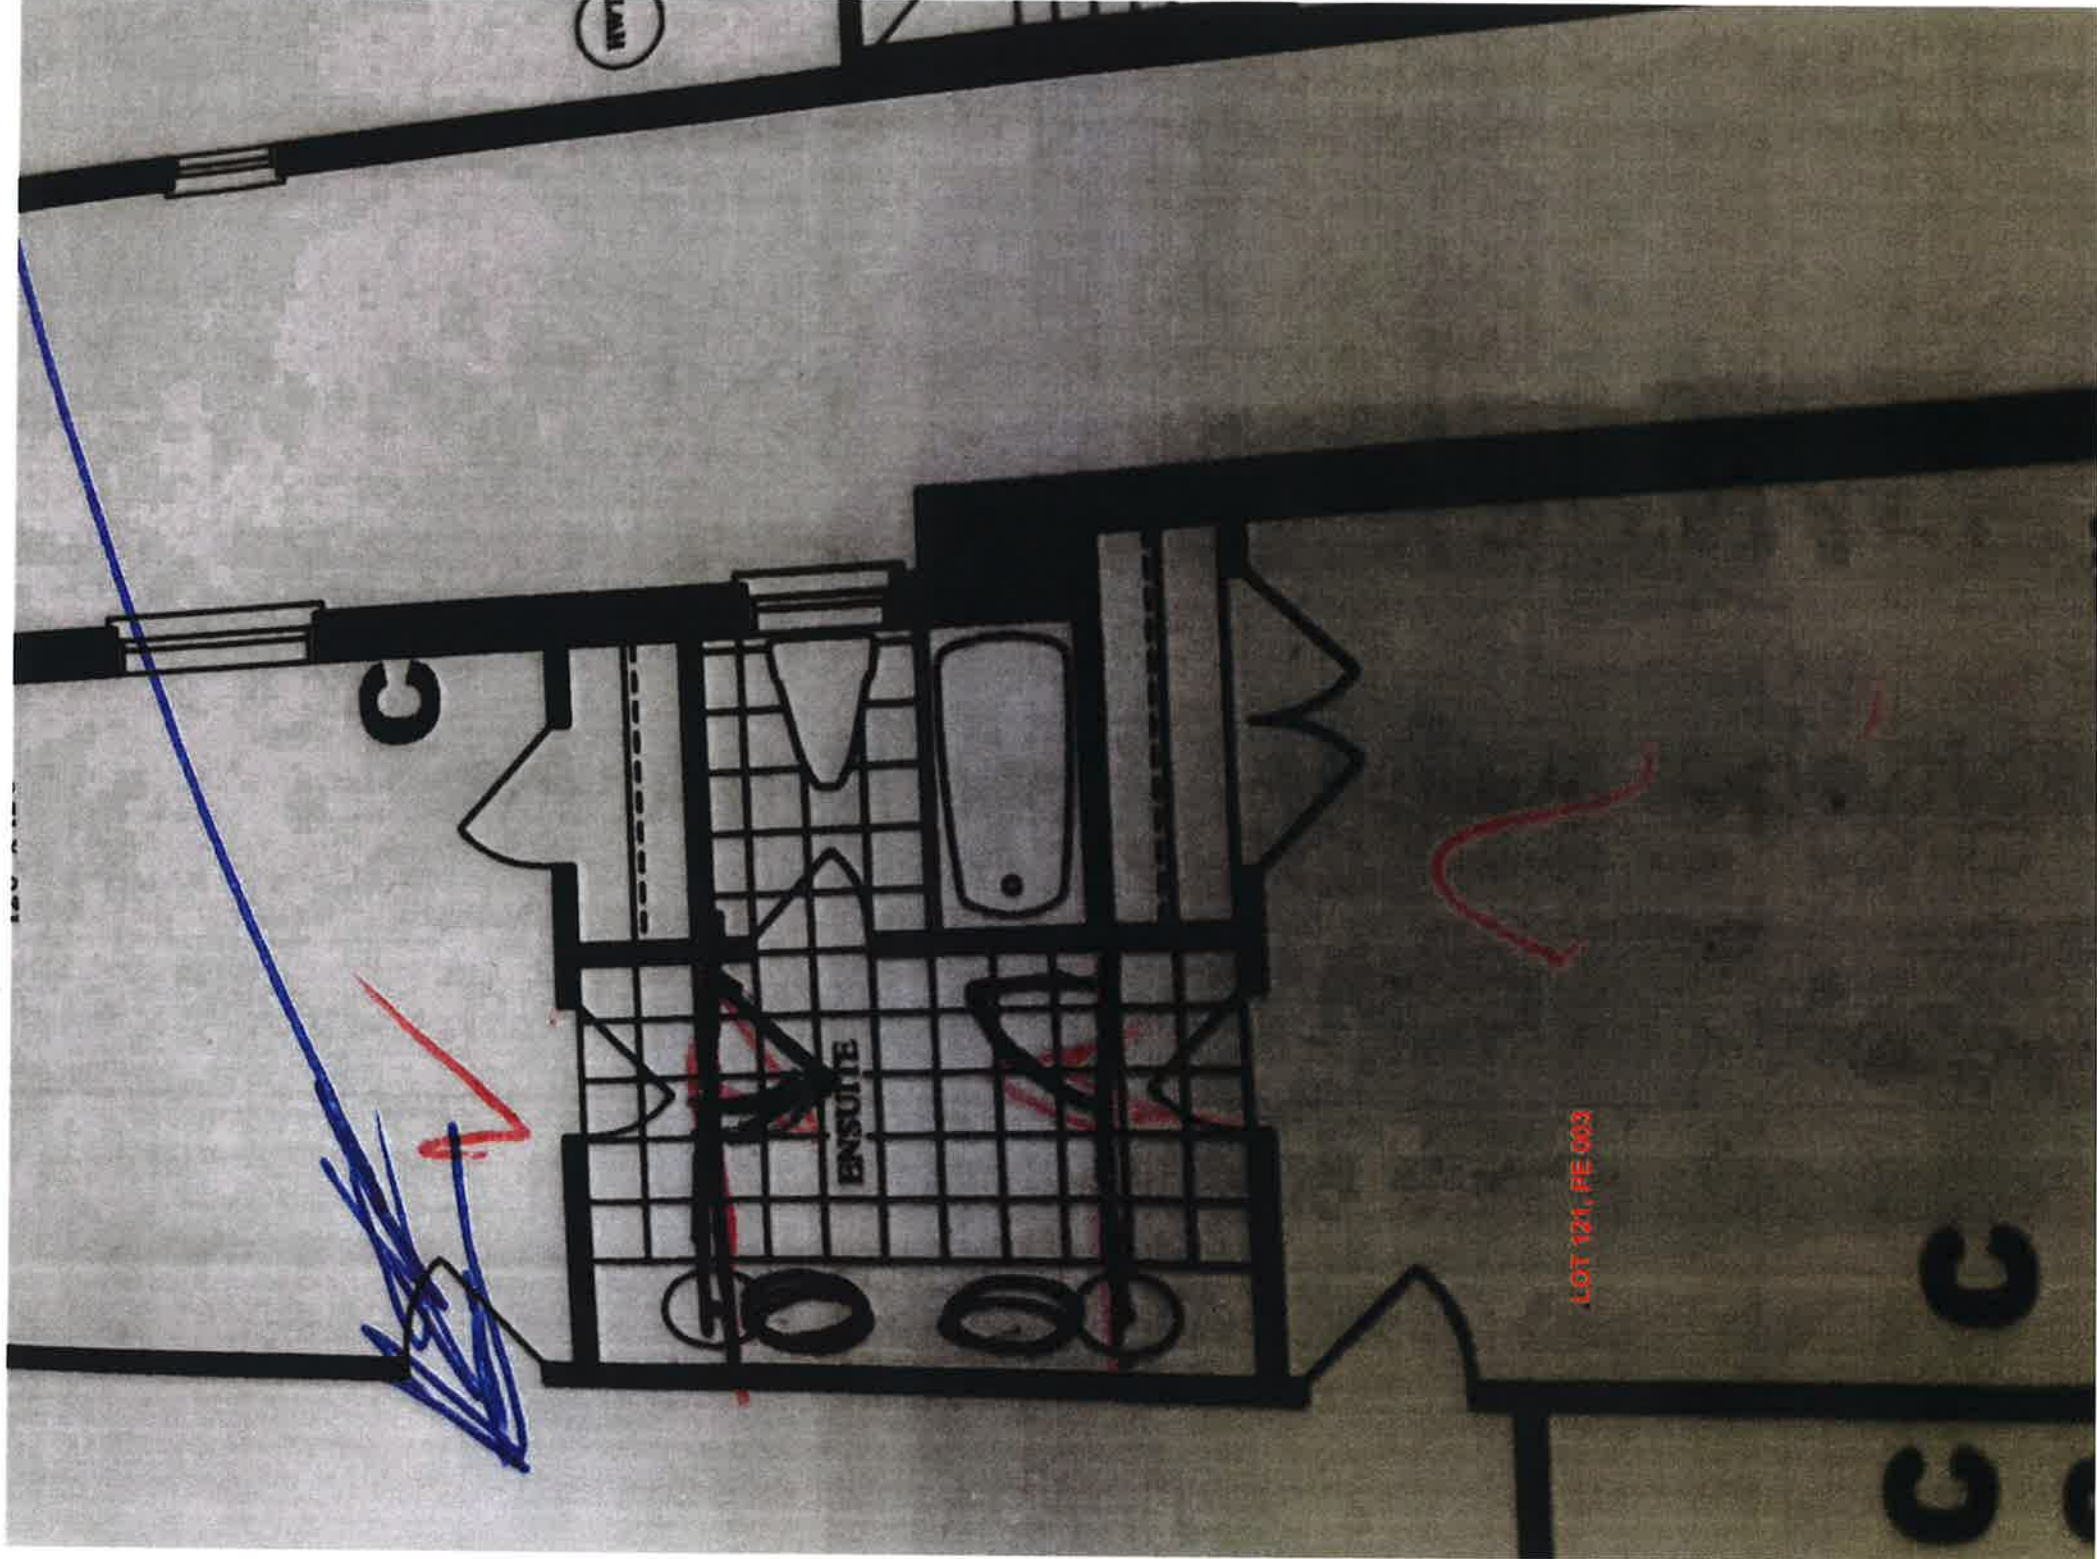

LOT 121, FE 003