

alc/conduit


Side door

Decrease
Breakfast by
1 1/4"


OTR
Increase
the laundry
by 1 1/4"

door is rough in
stackable w/d.
3 1/2' shower
wall to wall
8' tall openings
GARAGE
18'0" x 20'0"


FIRST FLOOR
ELEVATION A, B, C

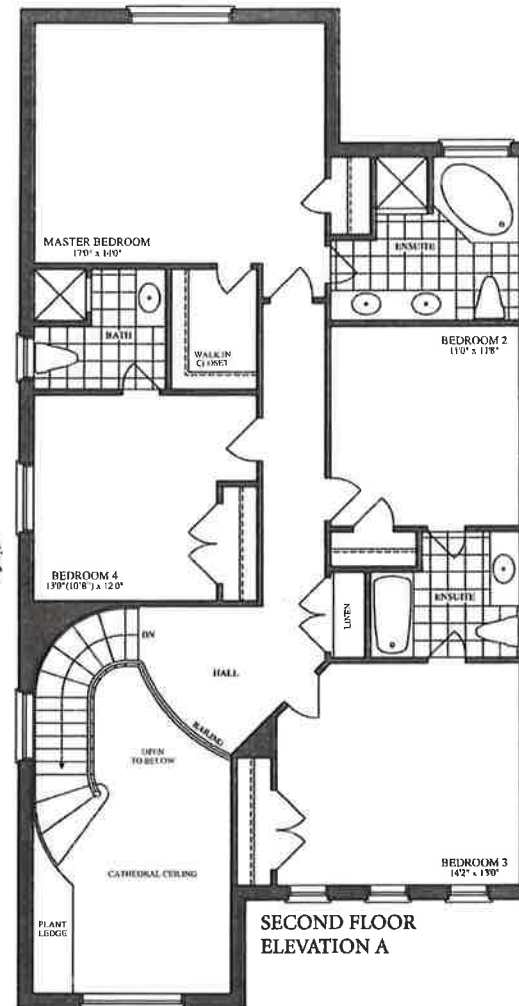

SECOND FLOOR
ELEVATION A

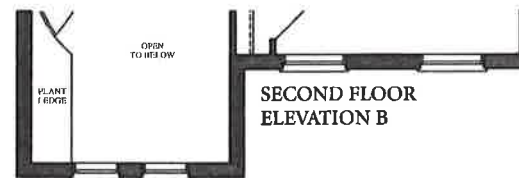


SECOND FLOOR
ELEVATION B

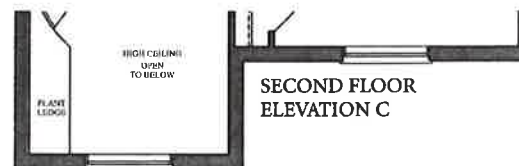

SECOND FLOOR
ELEVATION C

Lot 123, Phase 3

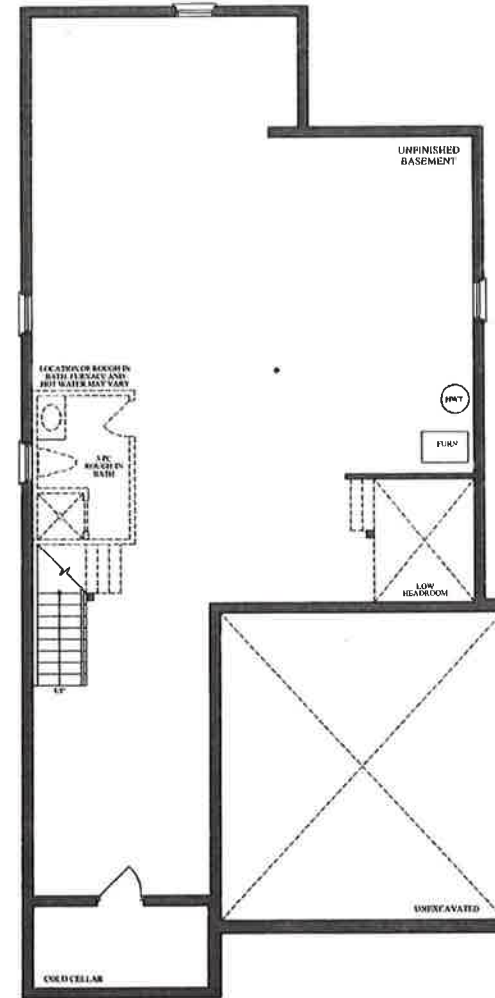

BASEMENT
ELEVATION A, B, C

The STANTON



ELEVATION A 2,760 SQ. FT.



ELEVATION B 2,760 SQ. FT.



ELEVATION C 2,760 SQ. FT.

Lornel HOMES

Plans and specifications are subject to change without notice. Actual results may vary from the stated information. All dimensions are subject to change.