




131B CARLAUREN RD., WOODBRIDGE, ONTARIO L4L 8A8  
TEL: (905) 856-7678 • FAX: (905) 856-7379  
www.libertycustomcabinetry.com

DATE:  
JOB NO:

|                  |                          |
|------------------|--------------------------|
| TO: <u>LOMER</u> | SHIP TO: <u>BRADFORD</u> |
|                  |                          |
|                  |                          |

|                   |                                      |           |             |                                                                                    |
|-------------------|--------------------------------------|-----------|-------------|------------------------------------------------------------------------------------|
| TYPE OF CABINETS: | FINISH OF CABINETS:                  | HARDWARE: | COUNTERTOP: | INSTALLATION:<br><input type="checkbox"/> WITH<br><input type="checkbox"/> WITHOUT |
| HOUSE TYPE:       | REMARKS:<br><u>LOT # 114 REVISED</u> |           |             |                                                                                    |

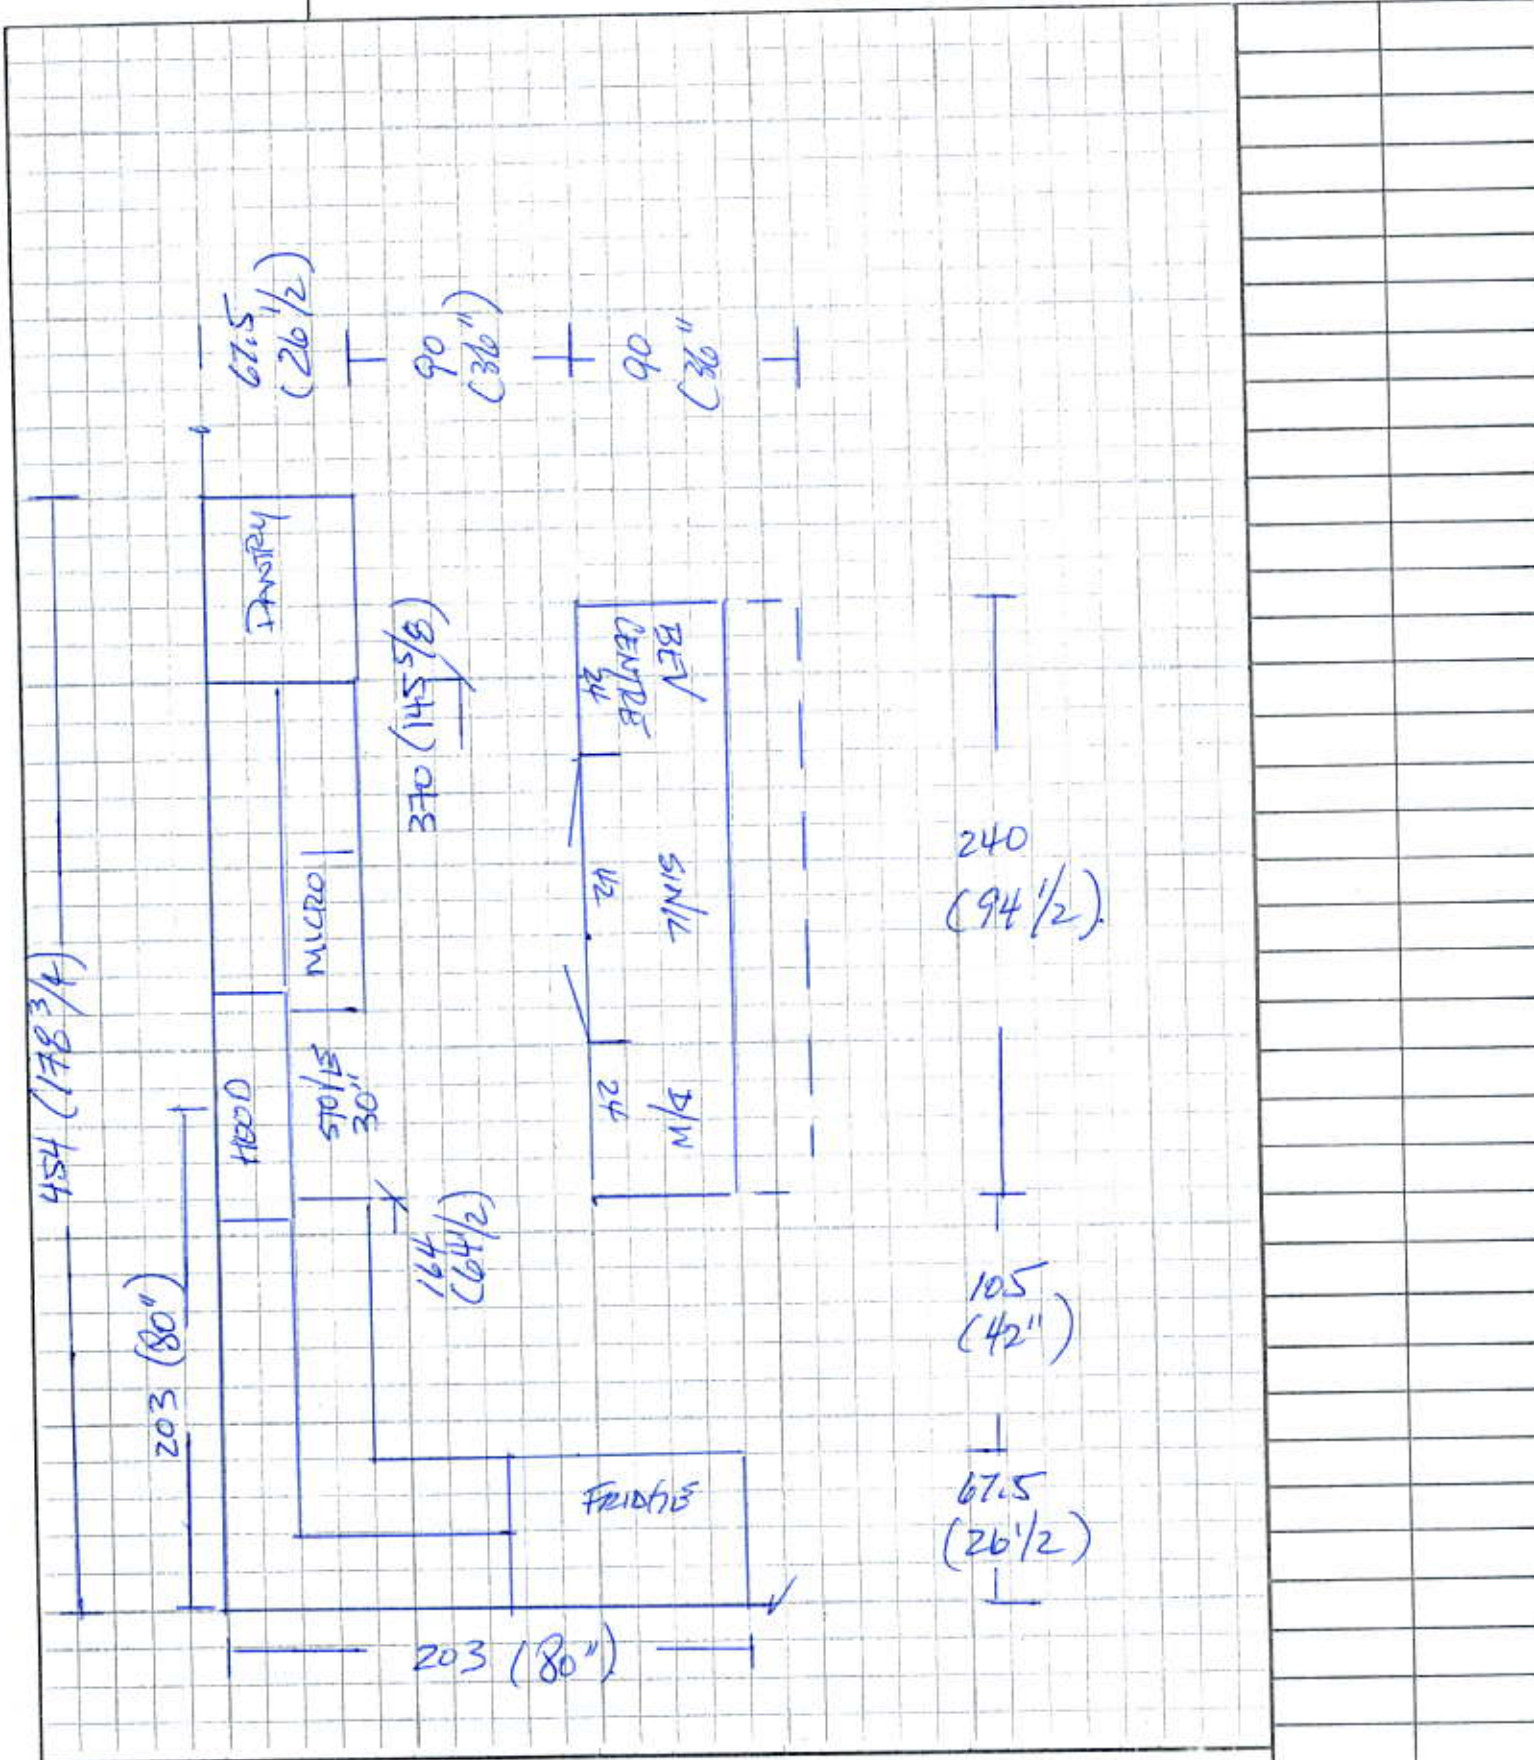

All prices subject to confirmation from head office.  
Goods delivered shall be checked and inspected on delivery. We shall not be responsible for any claims or complaints after this inspection.

All agreements are contingent upon strikes, accidents, and delays beyond our control.  
Please provide our installer with template for sinkholes or \$100.00 will be charged for callback.

ACCEPTED DATE: \_\_\_\_\_ TERMS: \_\_\_\_\_ TOTAL \$ \_\_\_\_\_  
LAYOUT THOROUGHLY EXPLAINED AND FULLY UNDERSTOOD

CUSTOMER SIGNATURE

SALESMAN'S SIGNATURE



### QUOTATION


DATE: \_\_\_\_\_  
JOB NO. \_\_\_\_\_

LOPMBL

BRADFORD

REMARKS:

LOT # 114 REVISED

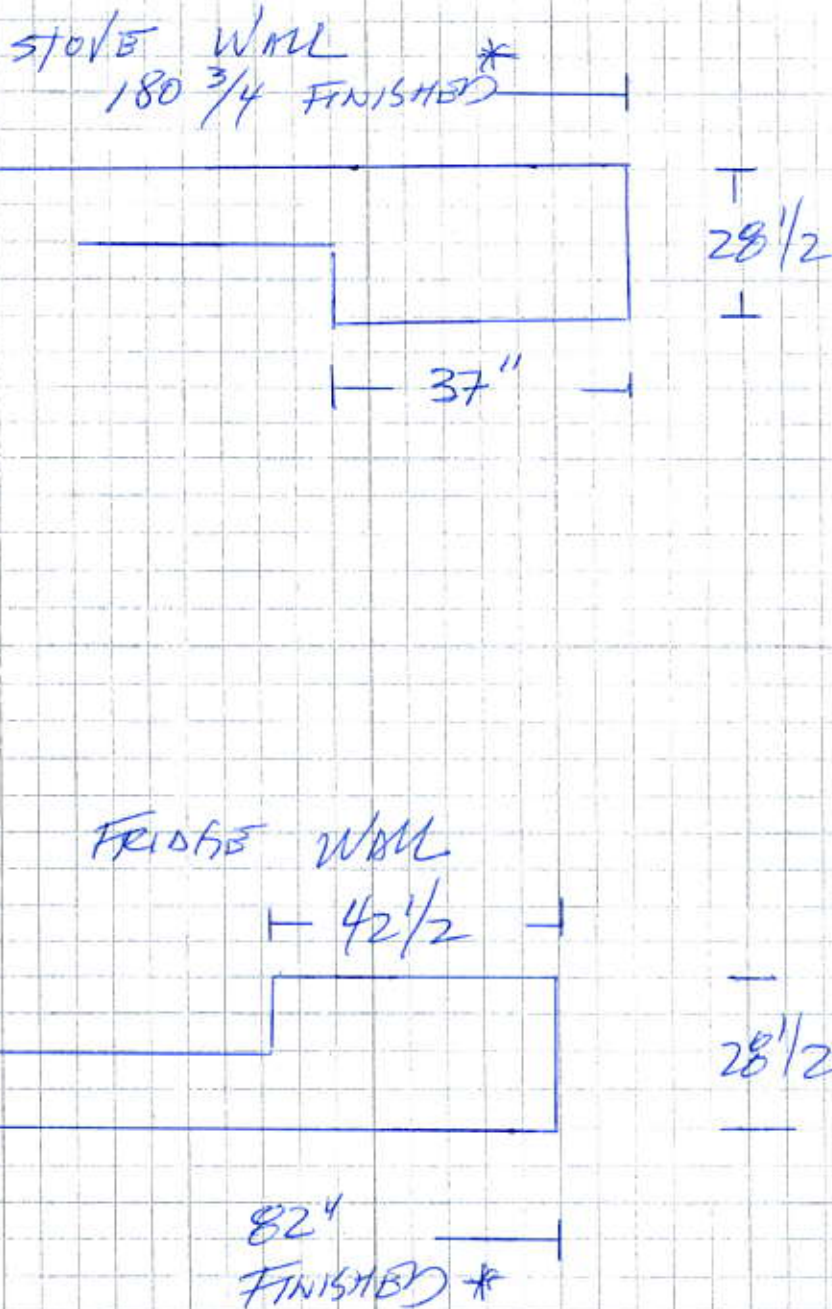

TOTAL \$

SALESMAN'S SIGNATURE \_\_\_\_\_