

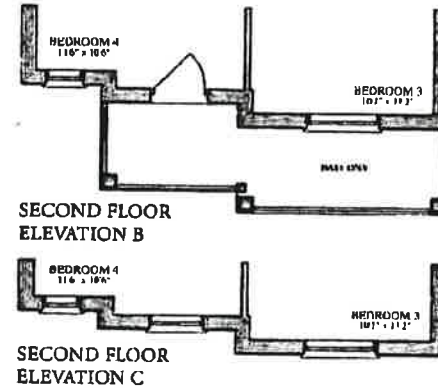
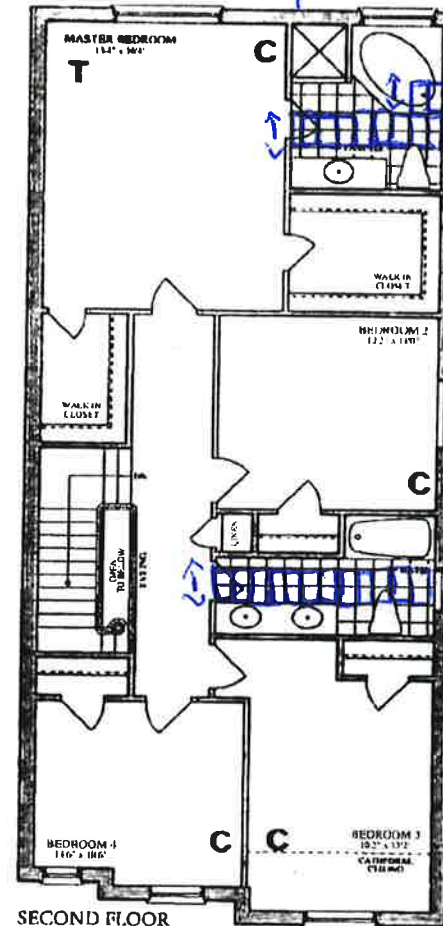
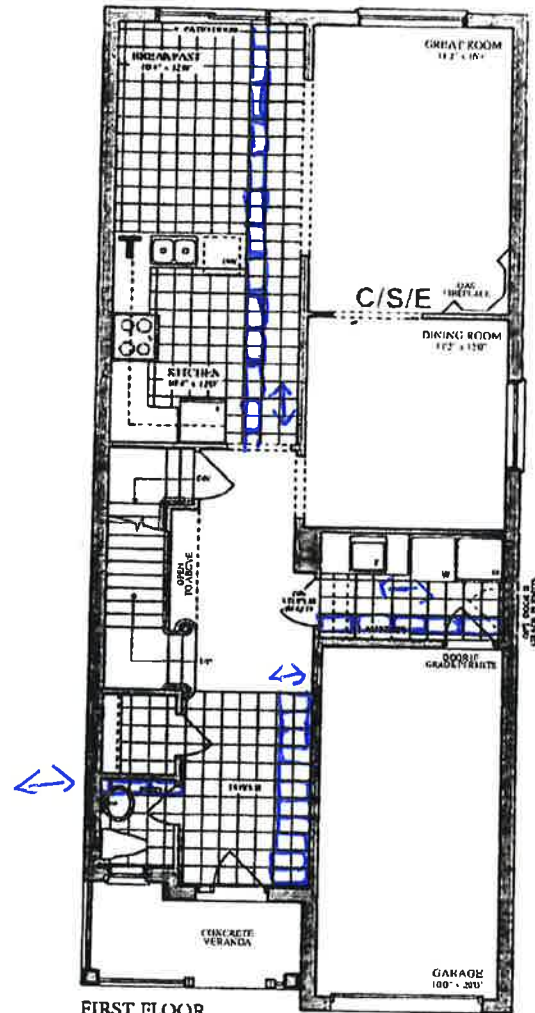



LOT 112, PH 3, BRADFORD. PE003 - *TILE Sketch Only*

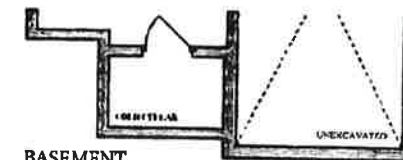

LOT # _____

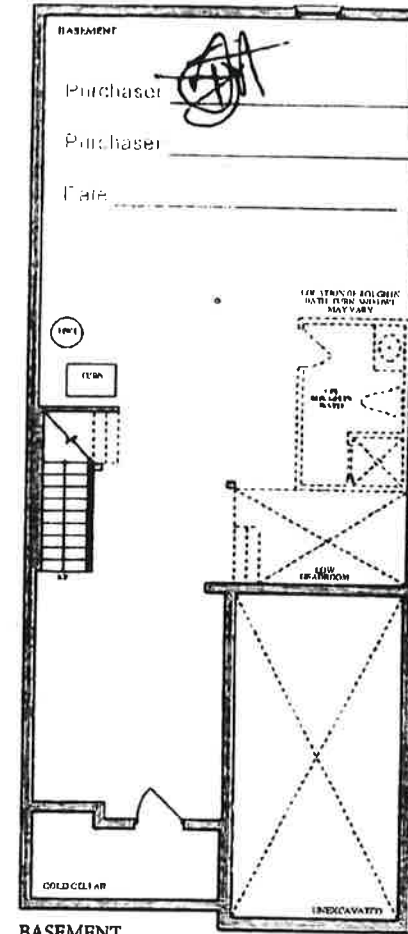

C = CABLE R/I
T = TELEPHONE R/I
S = SMARTWIRE R/I

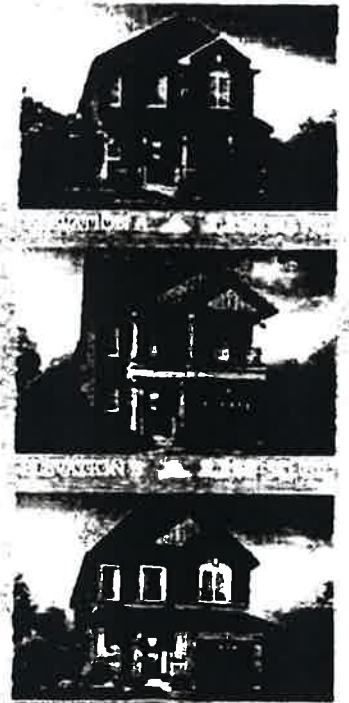

Lorne Homes