




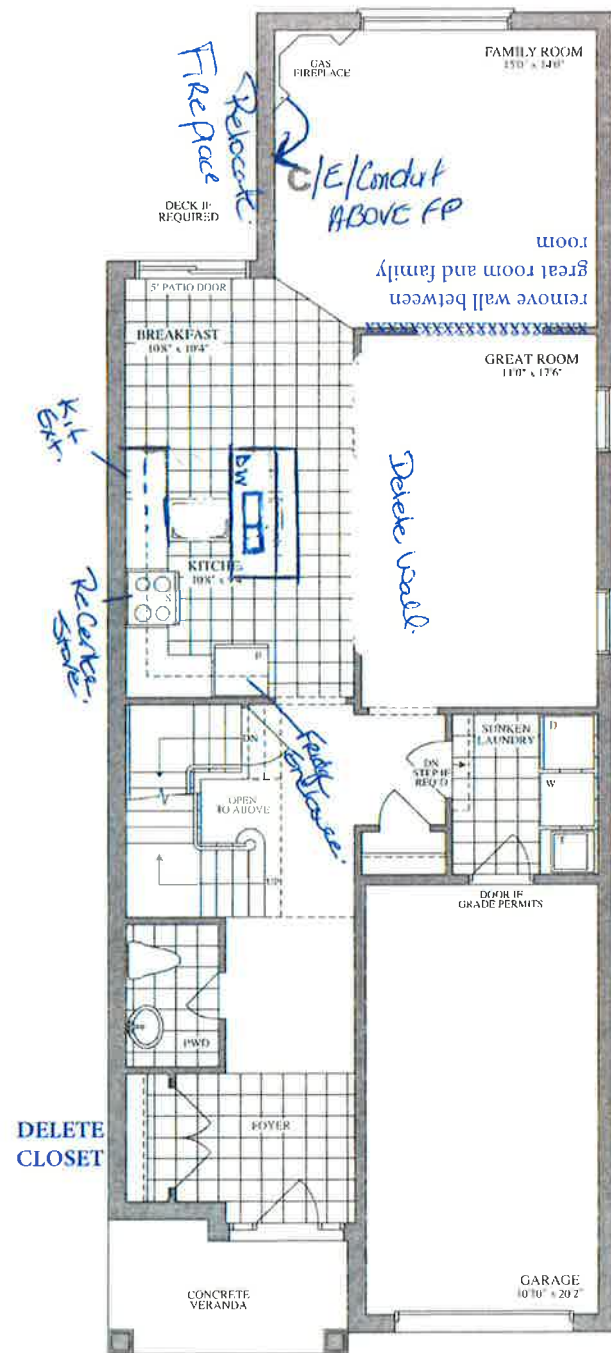

FIRST FLOOR
ELEVATION A, B, C

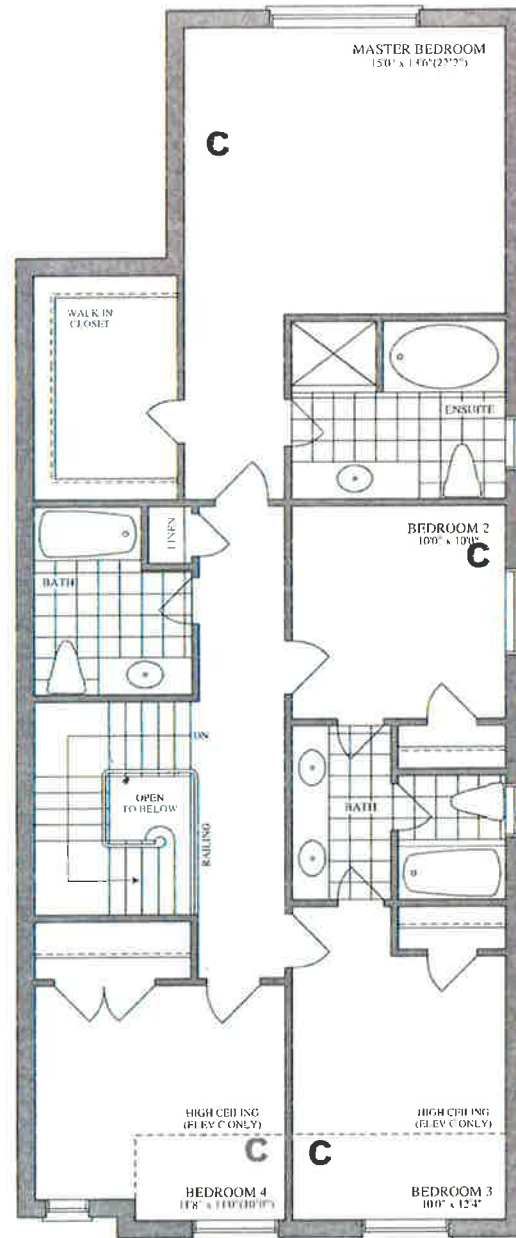

SECOND FLOOR
ELEVATION A, B, C

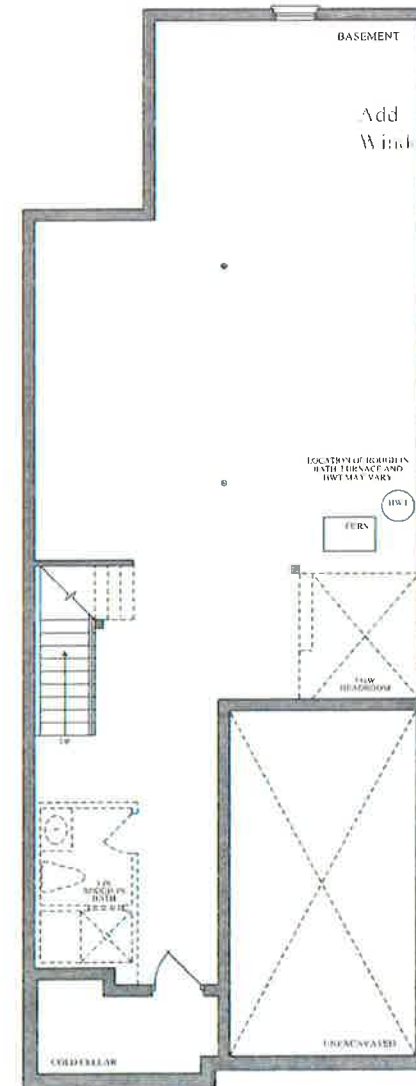

BASEMENT
ELEVATION A, B, C

30'

The ASHBURY



ELEVATION A ▲ 2,350 SQ. FT.



ELEVATION B ▲ 2,350 SQ. FT.



ELEVATION C ▲ 2,350 SQ. FT.



Plans and specifications are subject to change without
 notice. All dimensions are approximate and may vary.
 © 2010 Lornel Homes, Inc. All rights reserved.