GRADE'S PROFILE LINE IS GENERIC ; NOT REFLECT EXACT ELEVATION. GLASS AND PROTECTION OF GLASS IN ACCORDANCE WITH

E TO FORCED ENTRY SHALL BE FOR DOORS IN ACCORDANCE WITH 2 AND FOR WINDOWS IN ICE WITH OBC 9.7.5.3.

SHALL CONFORM TO OBC 9.8.8.1 LL RESIST LOADS IN CONFORMANCE LE 9.8.8.2.

GUMIOS CONFORM TO OBC 1.8.1.

MUM AGGREGATE AREA OF :TEO OPENINGS IN AN EXPOSING FACE SHALL CONFORM TO 0.14.4

NINGS CONTAINING ONLY DWELLING NSTRUCTION OF EXPOSING BUILDING ALL CONFORM TO OBC 9 10.15.5.

EP FOOTINGS ARE USED, THE RISE BETWEEN THE HORIZONTAL SHALL NOT EXCEED 800 mm, HORIZONTAL DISTANCE BETWEEN HALL BE NOT LESS THAN 800 mm, 15.3.9]

(NESS AND HEIGHT OF FOUNDATION DE OF UNREINFORCED CONCRETE IR SOLID CONCRETE AND SUBJECT V. EARTH PRESSURE SHALL TO TABLE 9:15.4.2 A. FOR WALLS EDING 2.5 m IN UNSUPPORTED DBC 9:15.4.2]

FOUNDATION WALLS SHALL EXTEND THAN 150 mm ABOVE FINISHED EVEL [OBC 9\_15.4.6]

FOR ROOF SPACES SHALL CONFORM (J.19.1.2)

ISTRUCTED ROOF VENT AREA SHALL SS THAN 1/300 OF THE INSULATED REA WHERE THE ROOF SLOPE IS V 1 IN 6, OR IN ROOFS THAT ARE TED WITH ROOF JOISTS THE ICTED VENT AREA SHALL BE NOT V 1/190 OF THE INSULATED REA [OBC 9.18.1.2]

SHALL BE INSTALLED IN MASONRY JURY VENEER WALLS IN UNCE WITH OBC 0.20,13,3,(1),

ALL FLASHING SHALL BE PROVIDED INRY VENEER WALL SUCH THAT ANY WHICH ACCUMULATES IN THE AR L BE DIRECTED TO THE EXTERIOR UILDING. [OBC 9.20.13.3 (2)]

WEEP HOLES THAT ARE SPACED NOT MORE THAN 800 mm APART SHALL BE PROVIDED AT THE BOTTOM OF CAVITIES OR AIR SPACES IN MASCORY VENEER WALLS AND ABOVE LINTELS OVER WINDOW AND DOOR OPENINGS. [OSC 9.20.13.8]

A CHIMNEY FLUE SHALL EXTEND NOT LESS THAN 900 mm ABOVE THE HIGHEST POINT AT WHICH THE CHIMNEY COMES IN CONTACT WITH THE ROOF, AND SHALL EXTEND NOT WITH THE ROOF AND SHALL EXTEND NOT SHAPE OF STREAM SHALL EXTEND NOT THE CHIMNEY. [OBC 9.21.4.4]

THE SLOPE OF ROOF SURFACES, ON WHICH ROOF COVERINGS MAY BE APPLIED, SHALL CONFORM TO OBC 9 26 3.1

FLASHING SHALL BE INSTALLED AT ALL INTERSECTIONS LISTED OBC 9.26.4


WHERE SLOPING SURFACES OF SHINGLED ROOFS INTERSECT TO FORM A VALLEY, THE VALLEY SHALL BE FLASHED IN CONFORMANCE WITH OBC 9.26,4.3.

AN EXTERIOR LIGHTING OUTLET WITH FIXTURE CONTROLLED BY A WALL SWITCH LOCATED WITHIN THE BUILDING SHALL BE PROVIDED AT EVERY ENTRANCE TO BUILDINGS OF RESIDENTIAL OCCUPANCY, [OBC  $\theta_134.2.1$ ]

REFER TO LOT GRADING / SITE PLAN FOR REQUIRED NUMBER OF EXTERIOR STEPS, DOOR BETWEEN GARAGE AND DWELLING, DECK OR BASEMENT WALKOUT CONDITION.

EVENT SUMMACE TO WHICH ACCESS IS PROVIDED, FOR OTHER THAN MARIENANCE PROVIDED, FOR OTHER PROVIDED BY A SUMMAN SUMM

FOR BULLDINGS CONTAINING ONLY DWELLING UNITS, EACH DAYDSING BUILDING FACE, AND WILLIAM FACE, AND WILLI

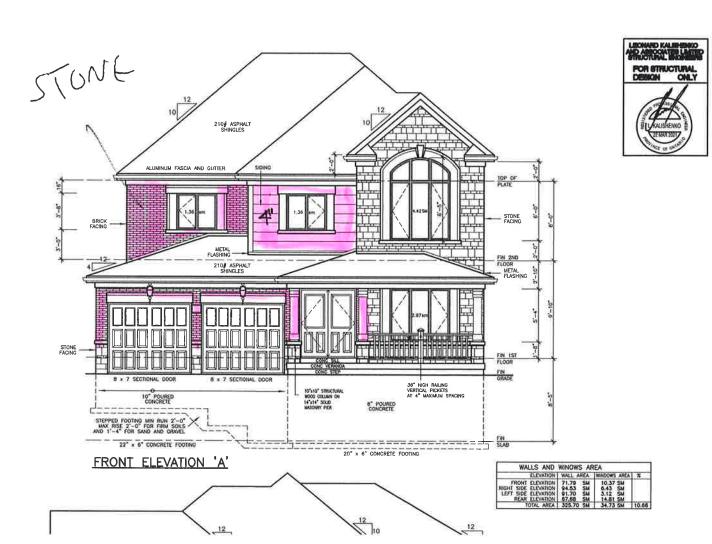

REV

ARCHITECTU Approved

Approved as Noted

This approval is for and as defined by the app