


The **Nipissing /** Elev. A & **3210** SQ.ft.

 \Box



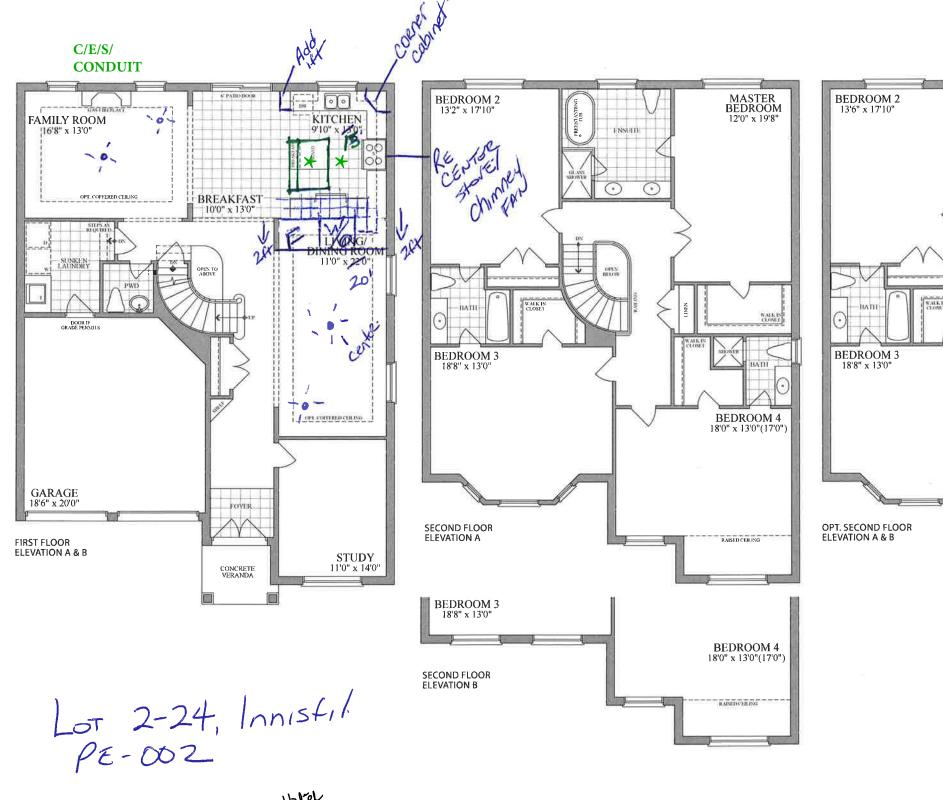

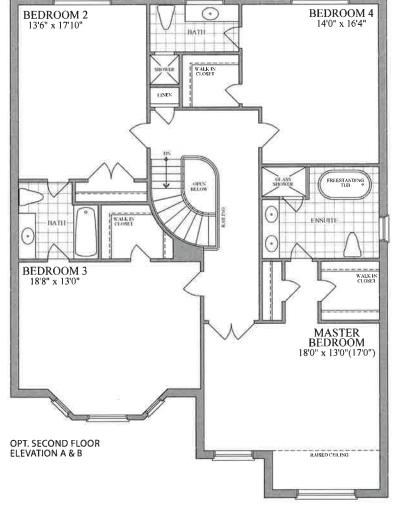

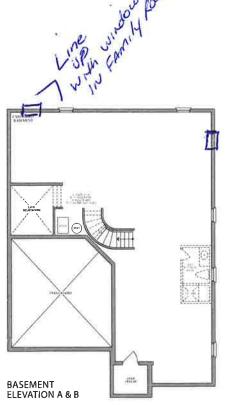



Purchaser's Initial Hemantkumar Patel (Jul 15, 2021 19:38 EDT)

lans and specifications are subject to change without notice. E. & O. E. Actual usable floor space may vary from the stated floor area. All renderings are artist's con-

Lot 2-24, PE002 Sketch

Final Audit Report 2021-07-15

Created: 2021-07-13

By: Luana Casale (luanac@rogers.com)

Status: Signed

Transaction ID: CBJCHBCAABAA397QaqyIM6-o6htoWlaTFsT6W8d7PzA0

"Lot 2-24, PE002 Sketch" History

Document created by Luana Casale (luanac@rogers.com) 2021-07-13 - 9:49:31 PM GMT- IP address: 207.35.220.226

Document emailed to Hemantkumar Patel (hempatel091@gmail.com) for signature 2021-07-13 - 9:49:52 PM GMT

Email viewed by Hemantkumar Patel (hempatel091@gmail.com) 2021-07-13 - 9:49:56 PM GMT- IP address: 64.233.172.103

Email viewed by Hemantkumar Patel (hempatel091@gmail.com) 2021-07-14 - 9:57:46 PM GMT- IP address: 64.233.172.125

Document e-signed by Hemantkumar Patel (hempatel091@gmail.com)

Signature Date: 2021-07-15 - 11:38:23 PM GMT - Time Source: server- IP address: 184.145.98.158

Agreement completed.
 2021-07-15 - 11:38:23 PM GMT