


47'
DESIGNS

The Kahshe / Elev. A & B
3000 sq.ft.

LOT 2-27, PE002 AND PE003


PURCHASER: Rasitha Ehangaram (Jul 25, 2021 13:29 EDT)

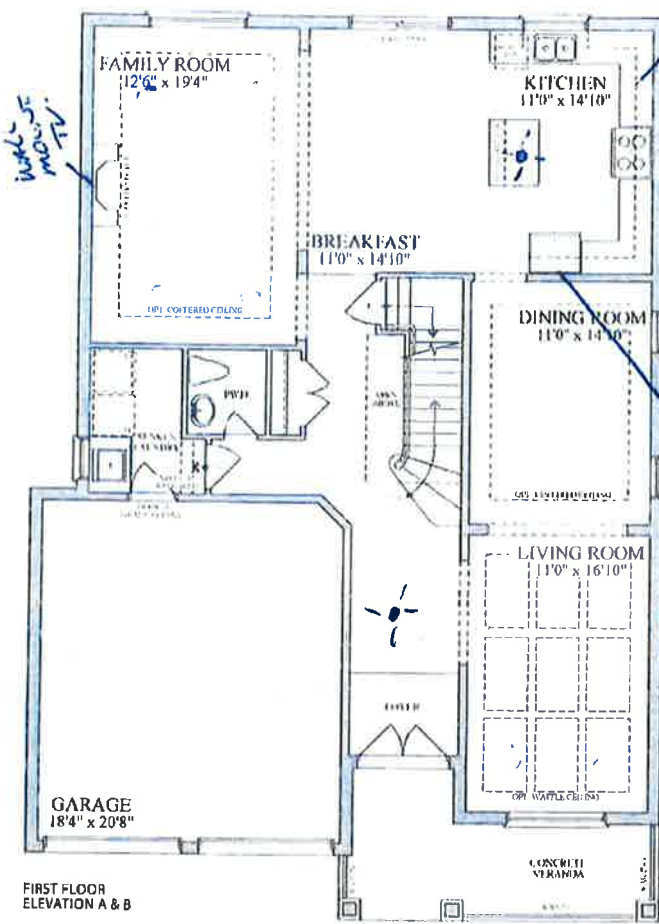

R/L Light Valve

Center clean Fridge Enclosure


FIRST FLOOR
ELEVATION A & B

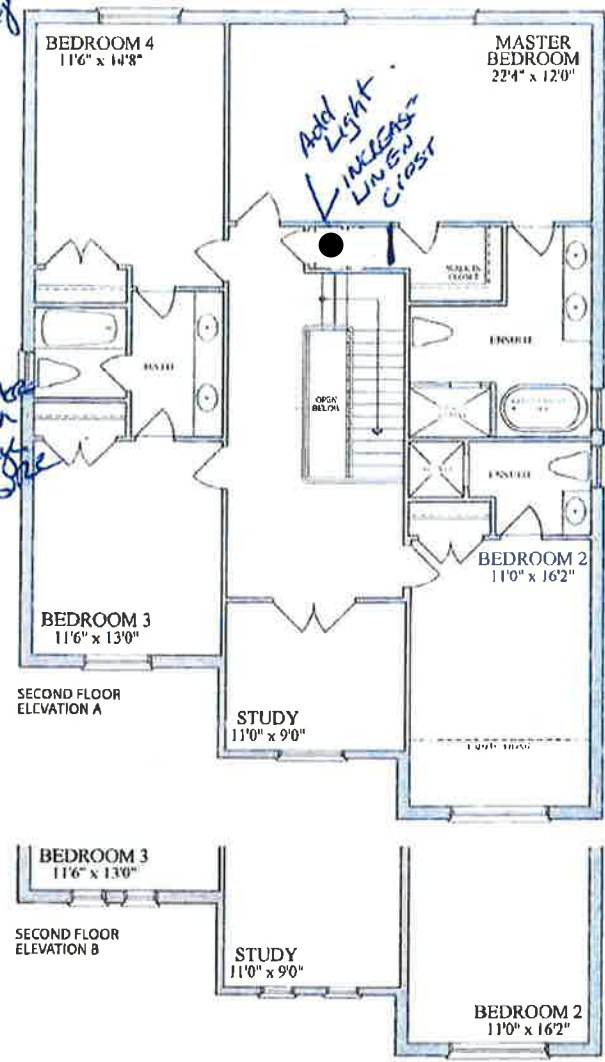

Add Light Linen Closet

SECOND FLOOR
ELEVATION A

SECOND FLOOR
ELEVATION B

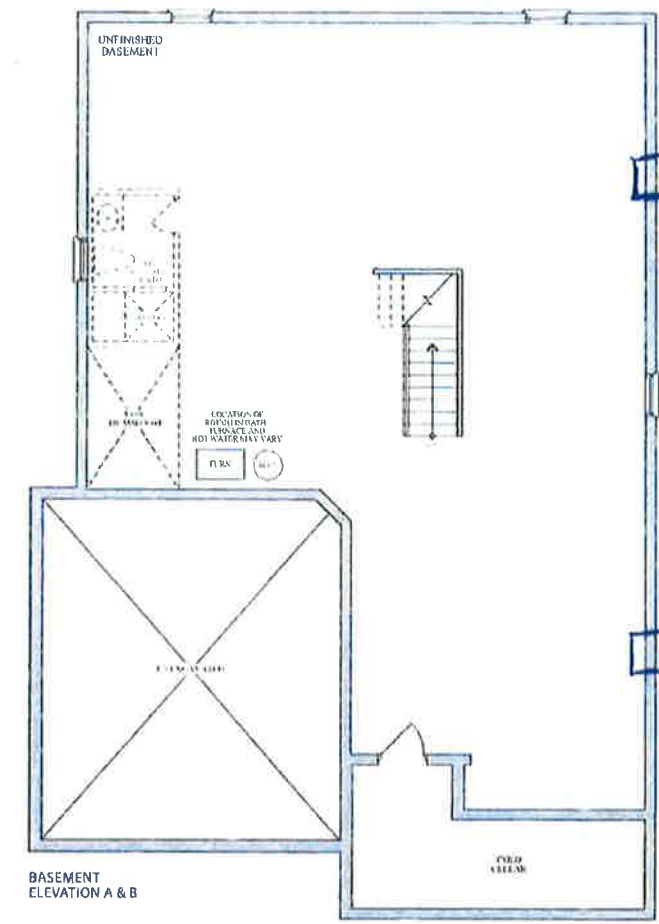

Add Window

Add Window

BASEMENT
ELEVATION A & B



Plans and specifications are subject to change without notice. E & B: Actual wall thicknesses may vary from the stated floor area. All dimensions are in feet and inches.