




47'
DESIGNS

The nipping / Elev. A & B
3210 sq.ft.

- sonos speaker locations.

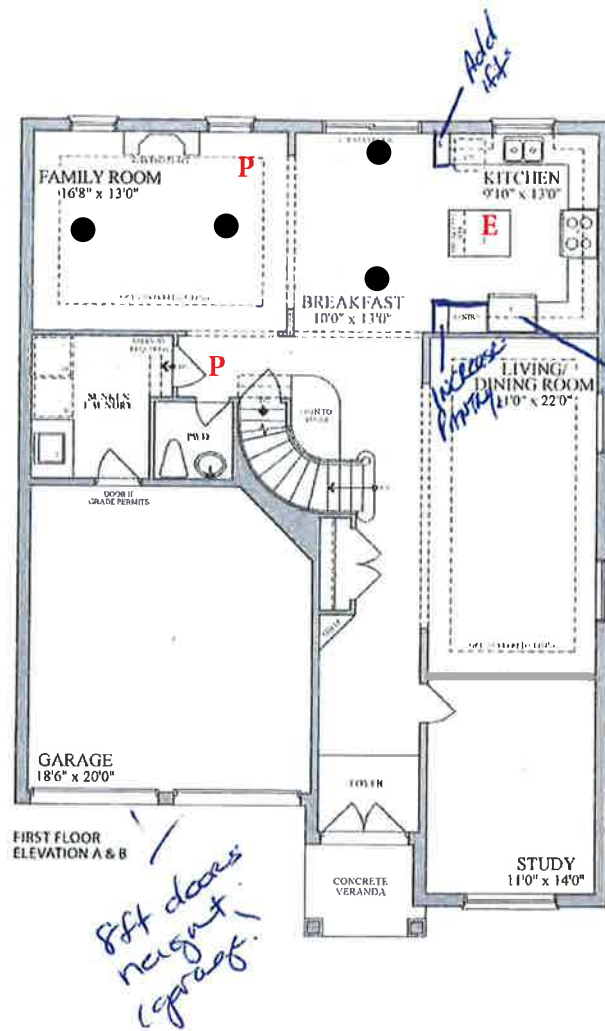

P=POTLIGHT

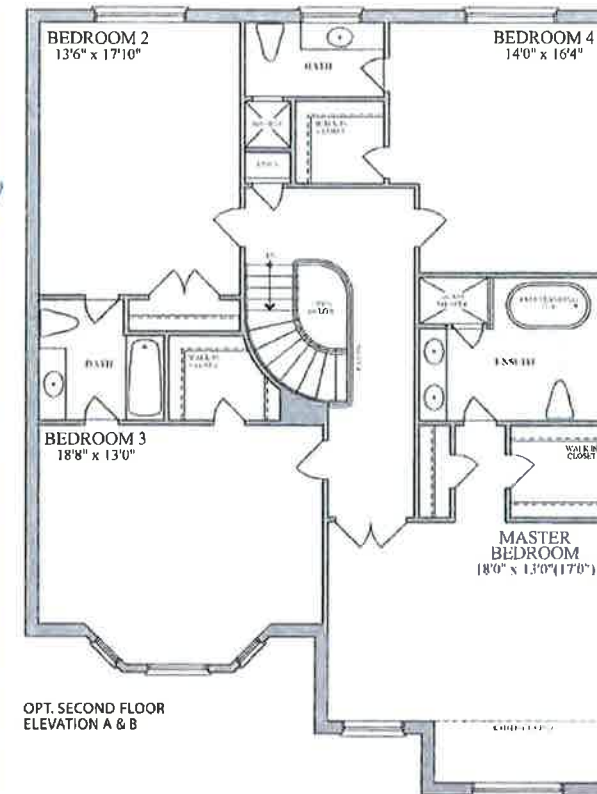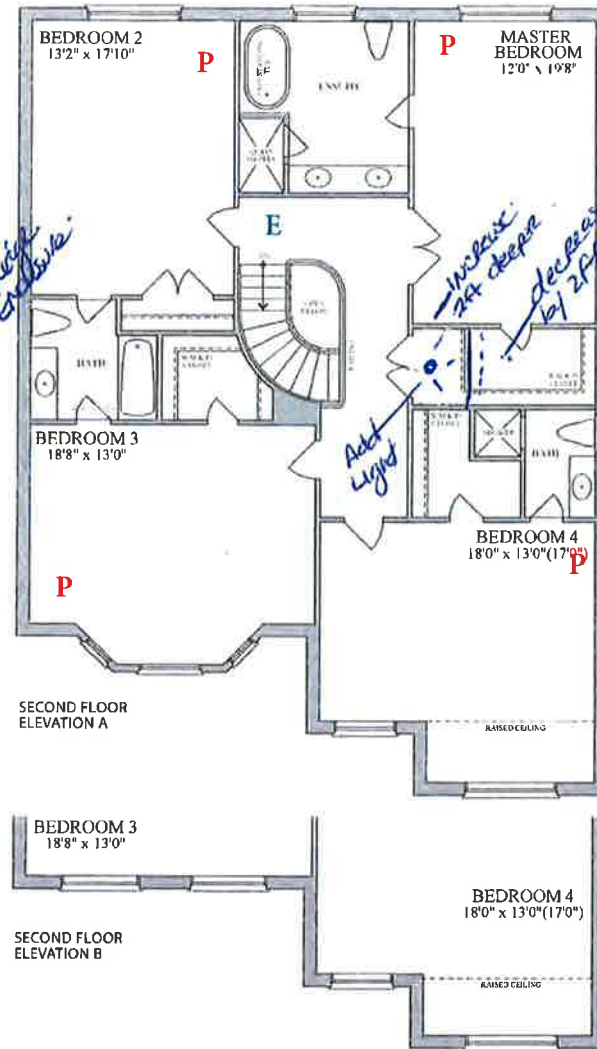

Plans and specifications are subject to change without notice. F & D F. Actual usable floor space may vary from the stated floor area. All renderings are artist's concept.

LOT 2-28, INNISFIL, PE002 and PE003

PURCHASER: Malathy Pararajasingam
Malathy Pararajasingam (7-2-25, 2021 to 2021)