


47'
DESIGNS

The madawaska / Elev. A & B
3190 sq.ft.

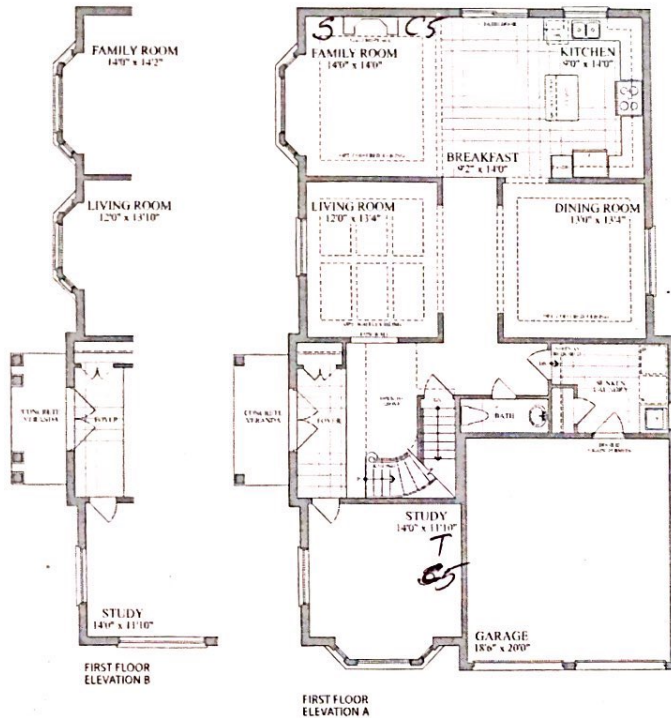

LOT #: 30 PHASE 2


PURCHASER: JOSHY JOB.

PURCHASER: Preetha John,



Prices and specifications are subject to change without notice. E. & O. E. Actual conditions may vary from the submitted drawings. All renderings are artist's conceptions.

John C.
3/12/2021

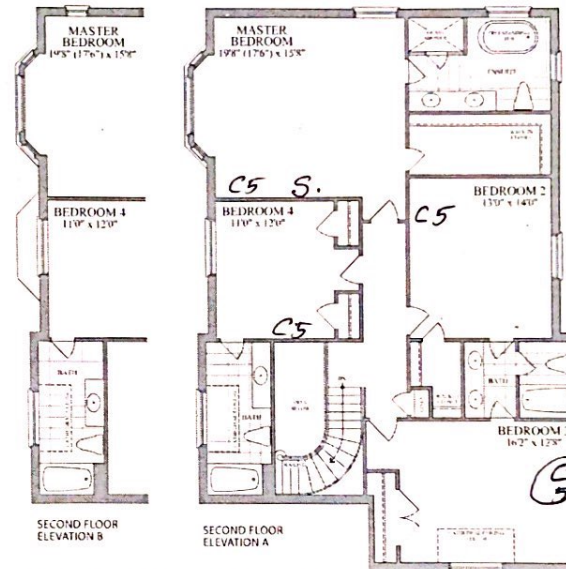

Please indicate the location of the rough-ins on your plan

Description	Symbol on Sketch	Standard Locations
Cable (Rough-in)	C	Family room Or Great Room, all bedrooms, Study/Den/Computer, (as per model)
Cat5	C5	A Cat5 wire can replace the rough-in cable at no additional cost.
Cat6	C6	Upgrade - \$50 per location
Telephone (Rough-in)	T	Kitchen and Primary Ensuite
Smart-Wire (Cat5)	S	Can be installed a Purchaser's desired location

