



LOT 2-62, INNISFIL

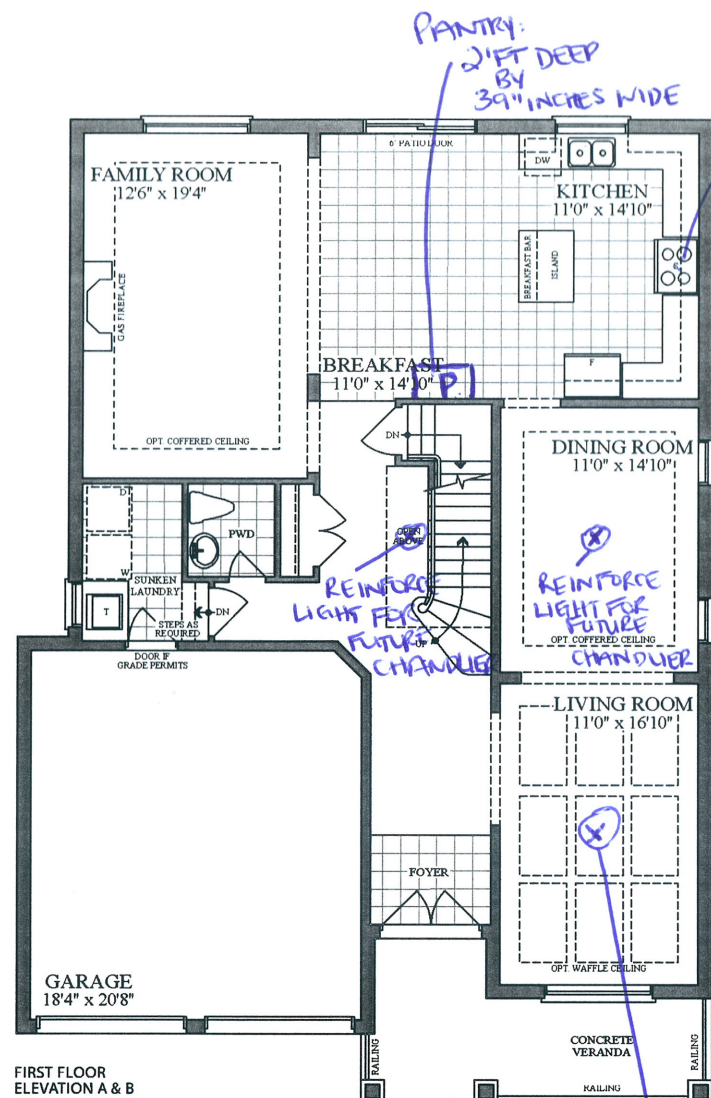


FIRST FLOOR
ELEVATION A & B

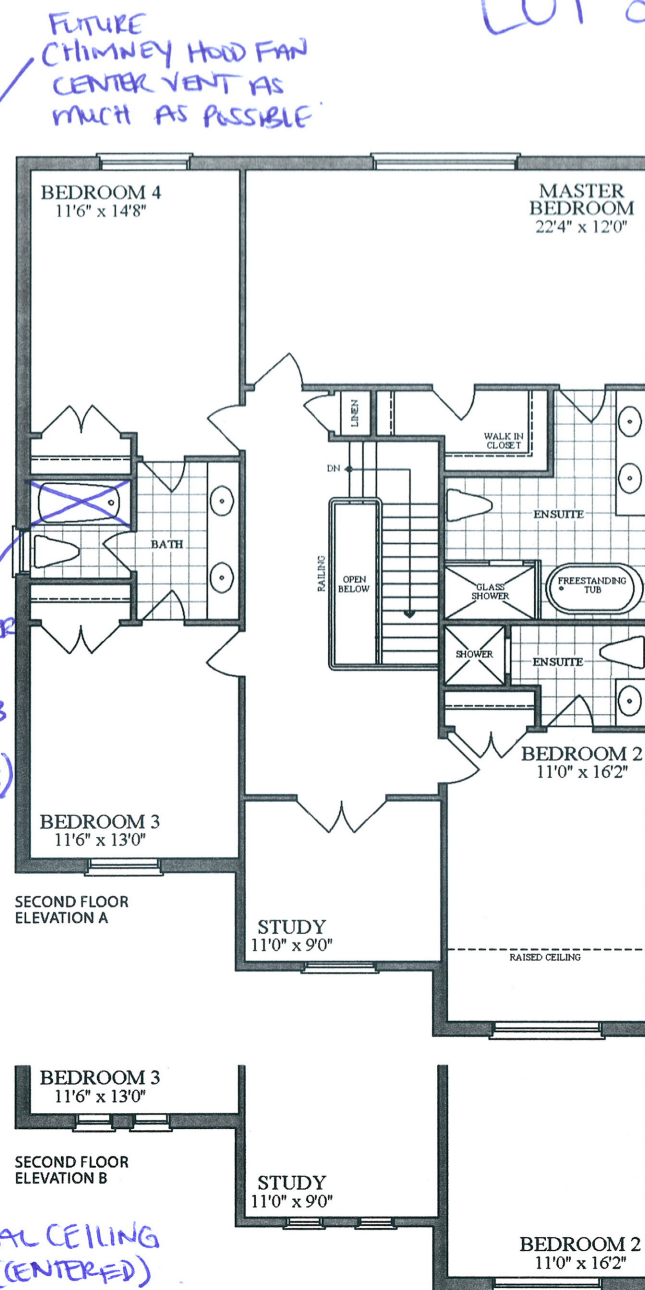

SECOND FLOOR
ELEVATION A

SECOND FLOOR
ELEVATION B

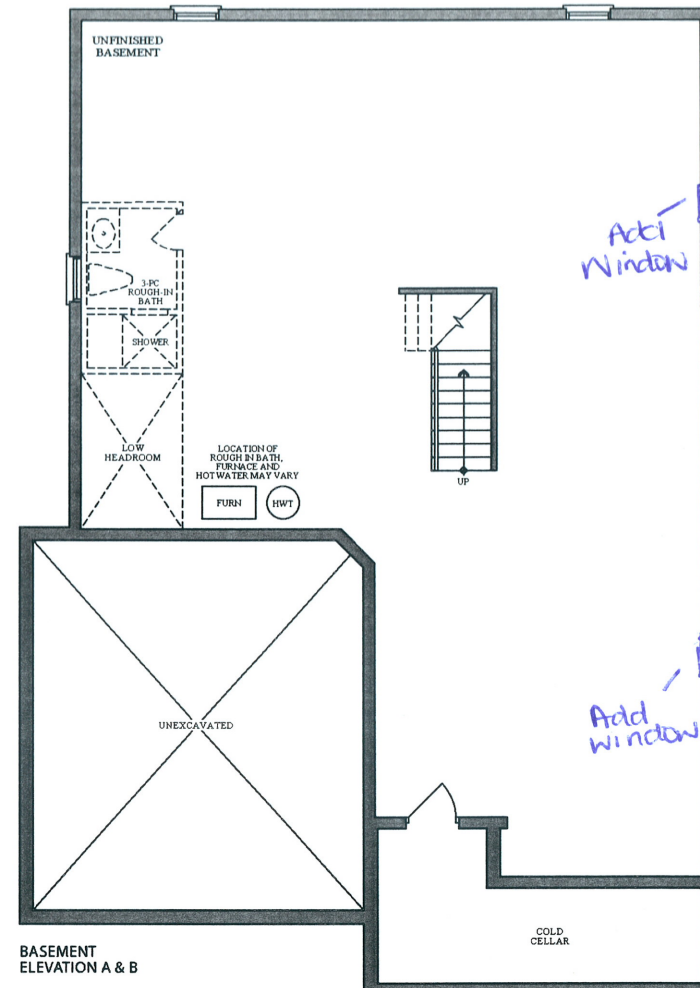

BASEMENT
ELEVATION A & B