
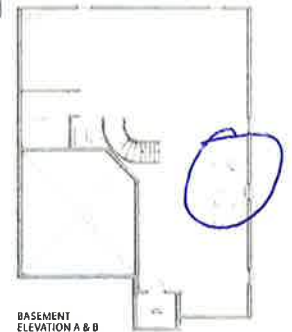


47'
DESIGNS

The nipissing / Elev. A & B
3210 sq.ft.

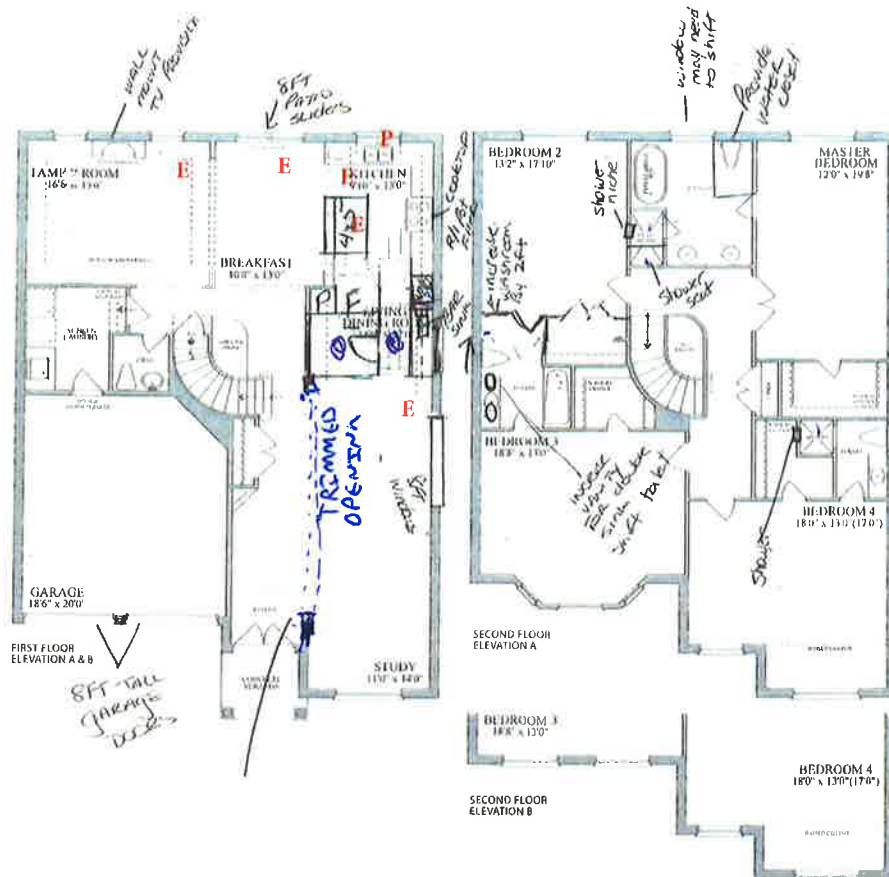

Plans and specifications are subject to change without notice. E & O E. All other details that appear may vary from the stated floor plan. All dimensions are in feet and inches.

LOT 2-63, PH2, INNISFIL, PE002

PURCHASER: _____

PURCHASER: _____