
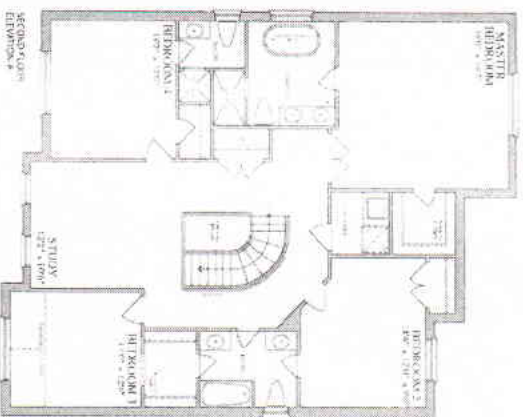


LOT 2-64, INNISFIL, PE002

Purchaser: _____

47' DESIGNS

The Carlyle / Elev. A & B
2950 sq. ft.

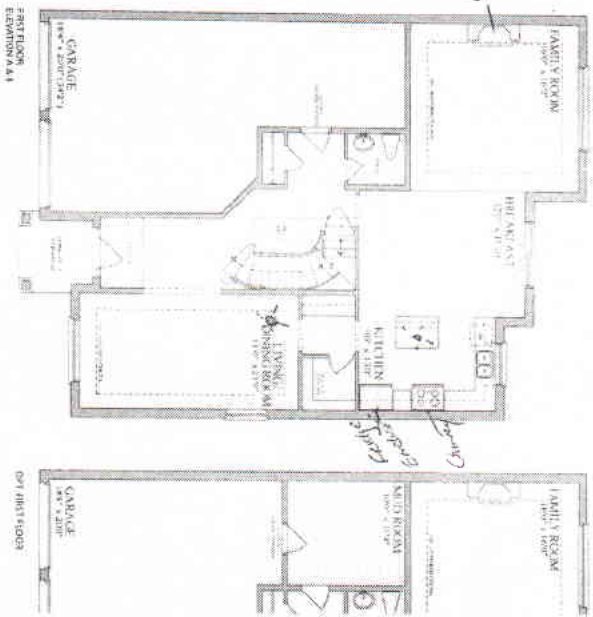

BASMENT ELEVATION A



BASMENT ELEVATION B



BASMENT ELEVATION C



THIRD FLOOR ELEVATION B

[Handwritten signature]



Not to scale. Dimensions are approximate. All dimensions are to the center of the wall unless otherwise noted. All dimensions are to the center of the wall unless otherwise noted.