




LOT 2-671

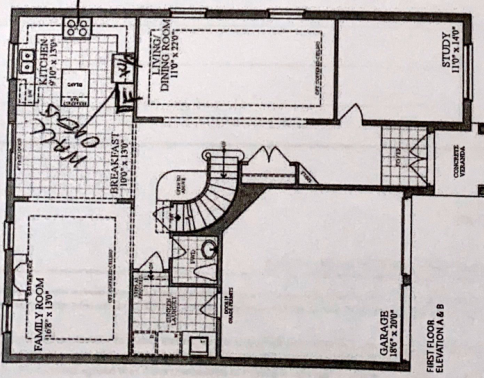


FIRST FLOOR
ELEVATION A & B

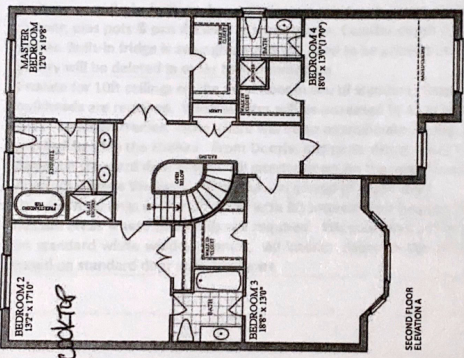


SECOND FLOOR
ELEVATION A

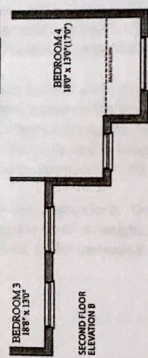

SECOND FLOOR
ELEVATION B

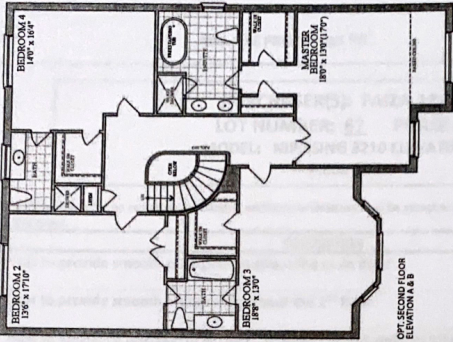

OPT. SECOND FLOOR
ELEVATION A & B

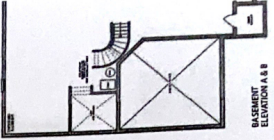

BASEMENT
ELEVATION A & B

- ① Built in Appliances
- ② 10ft ceiling in main
- ③ 9ft ceiling in 2nd floor - 8ft doors

Handwritten signature

Purchaser: _____

Plans and specifications are subject to change without notice. © C.O. E. Model created from plans may vary from the actual floor plan. All measurements are subject to measure.