


**47**  
DESIGNS

The Kahshe / Elev. A & B  
3000 sq.ft.



Lot 2-68

\*\*Walk-up Basement

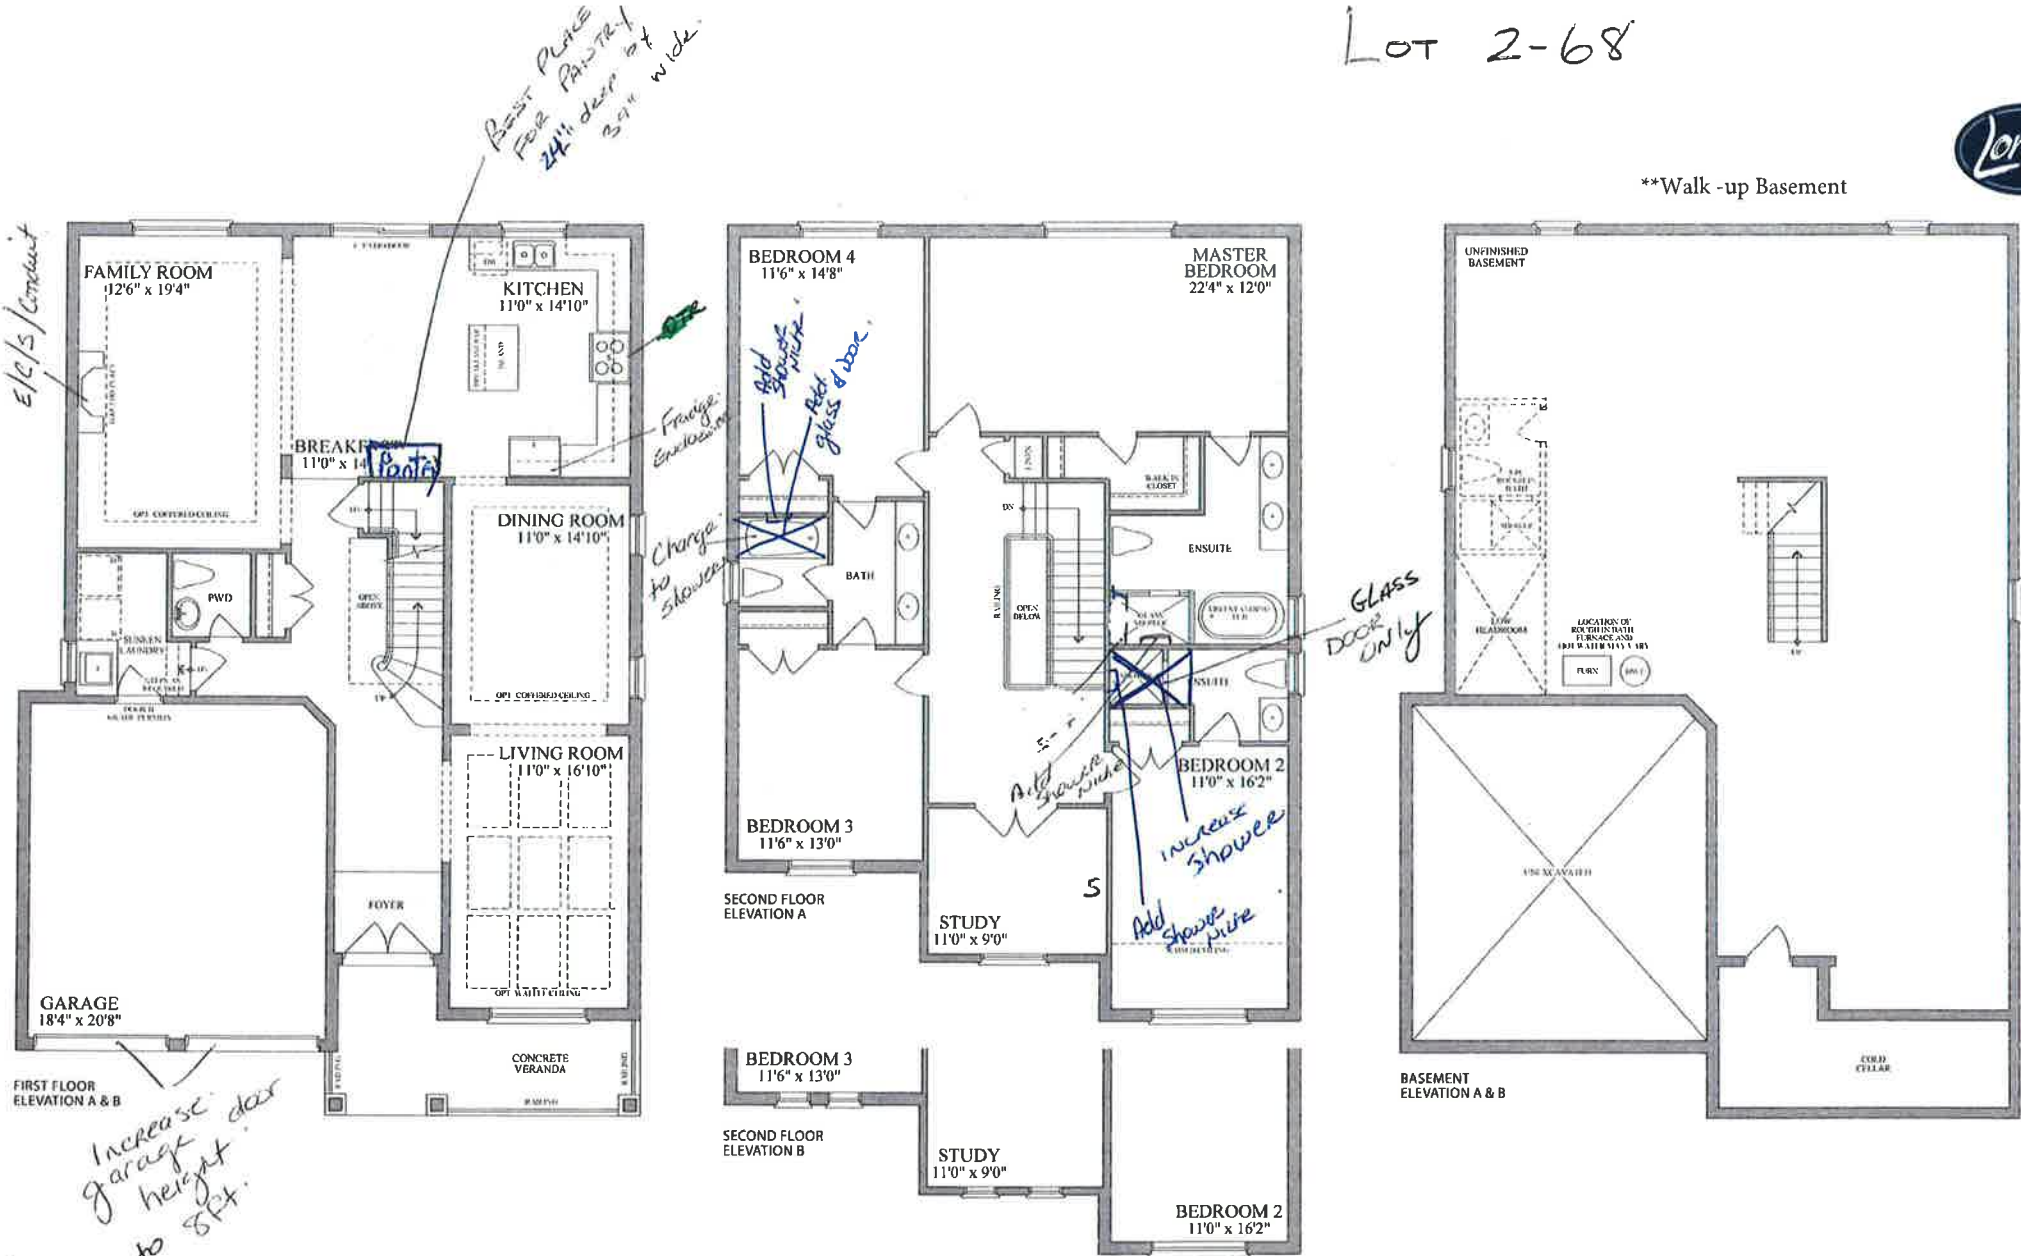

Plans and specifications are subject to change without notice. E & O. E. Actual usable floor space may vary from the stated floor area. All renderings are artist's concept.

Purchaser Initials: KMcKenzie  
Kert McKenzie (Jul 7, 2021 17:48 EDT)

Purchaser Initials: AS  
Aloma Smith (Jul 8, 2021 12:46 GMT-2.5)