



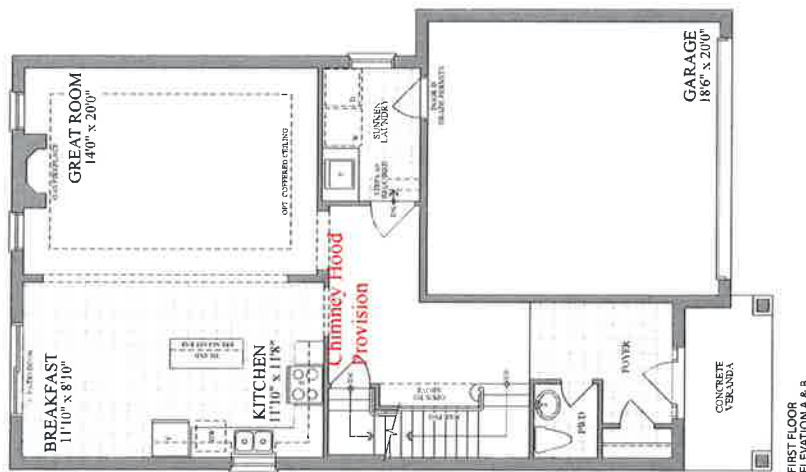


FIRST FLOOR
ELEVATION A & B

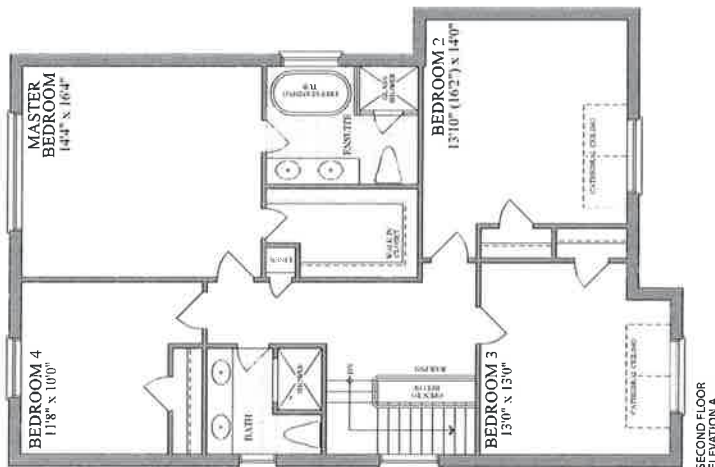

SECOND FLOOR
ELEVATION A



SECOND FLOOR
ELEVATION B

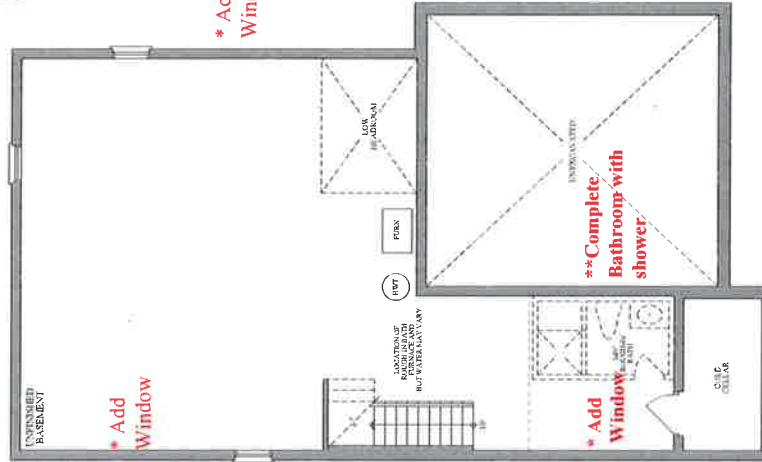

BASMENT
ELEVATION A & B

LOT 5-38, PH5, INNISFIL - PE002

Purchaser: Marlene Tsakalov (Sep 23, 2021 16:40 EDT)

Purchaser: Michael Glitsch (Sep 23, 2021 16:47 EDT)

Plans and specifications are subject to change without notice. A.C.D.E. Actual square foot area may vary from the stated floor area. All measurements are given in Imperial units.