
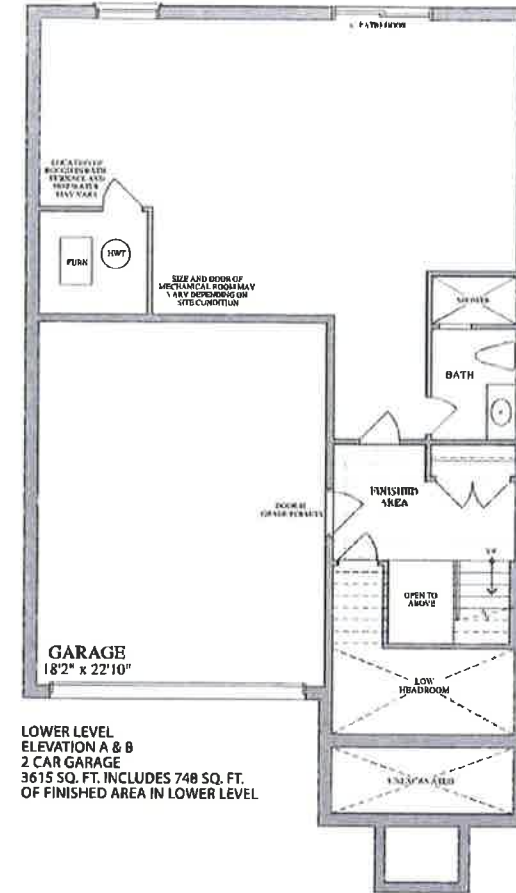
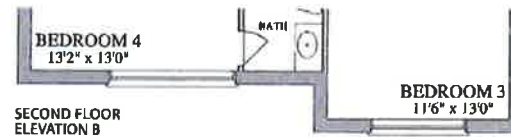
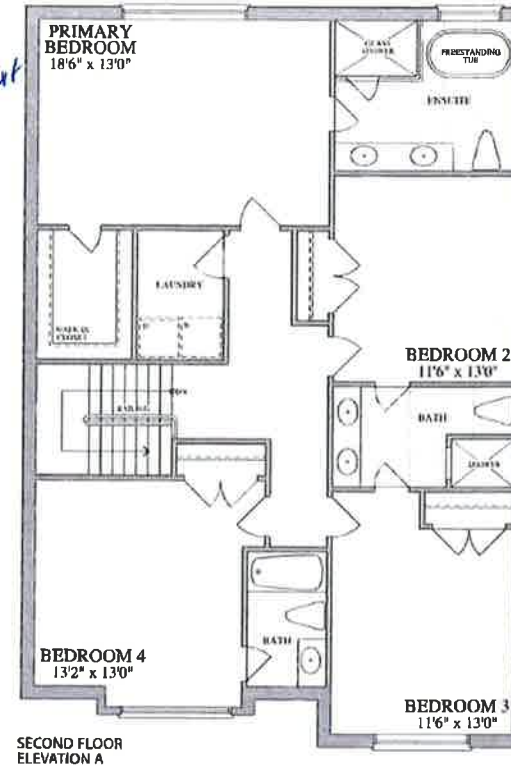
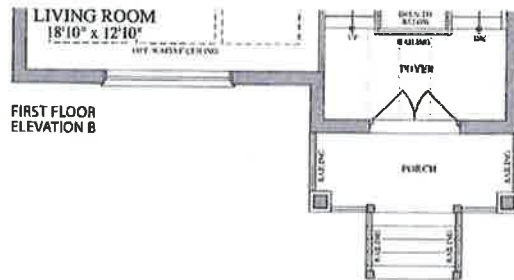


38'
DESIGNS

The Superior / Elev. A & B
includes 748 sq. ft. of finished area in lower level

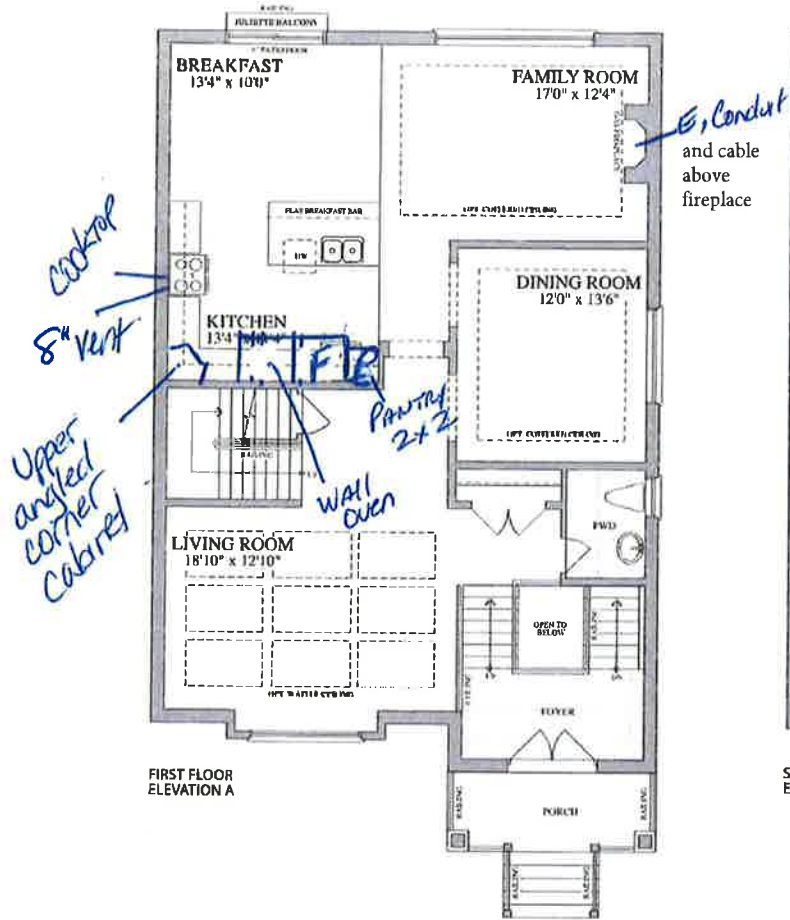

LOWER LEVEL
ELEVATION A & B
2 CAR GARAGE
3615 SQ. FT. INCLUDES 748 SQ. FT.
OF FINISHED AREA IN LOWER LEVEL

LOT 5-45, PH5, INNISFIL, PE003, SKETCH

PURCHASER: Hemi sheth (Nov 23, 2021 19:15 EST)

PURCHASER: _____