



LOT 5-51, INNISFIL

38'  
DESIGNS


The Buckhorn / Elev. A & B  
1800 sq.ft.

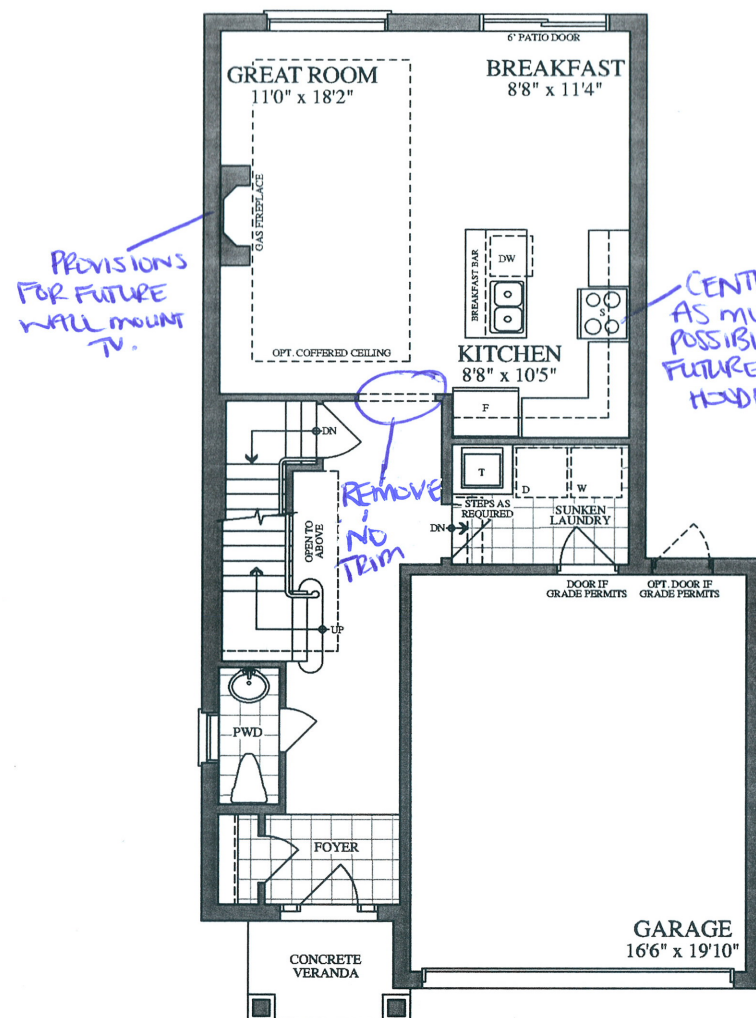


FIRST FLOOR  
ELEVATION A & B

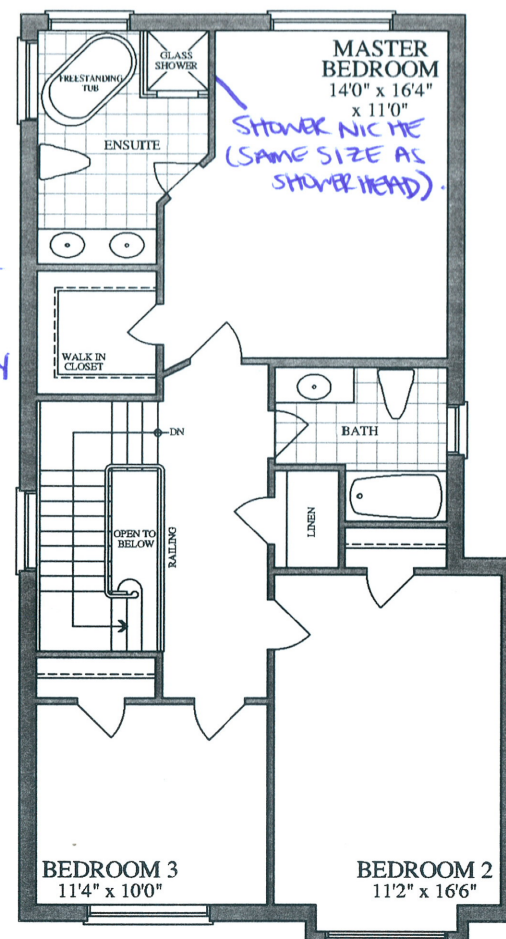

SECOND FLOOR  
ELEVATION A

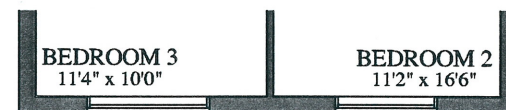

SECOND FLOOR  
ELEVATION B

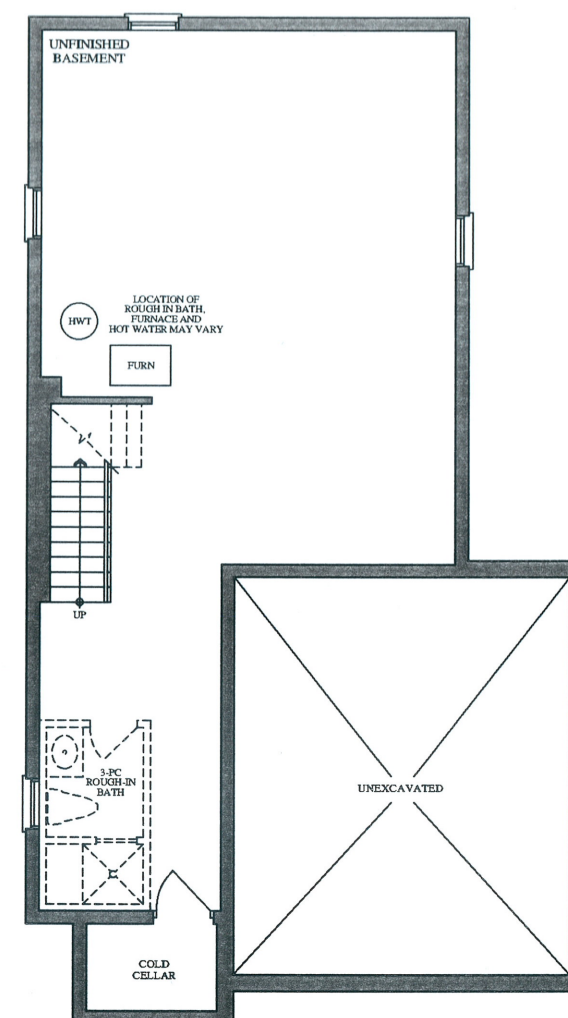

BASEMENT  
ELEVATION A & B