



The Kahshe / Elev. A & B
3000 sq.ft.

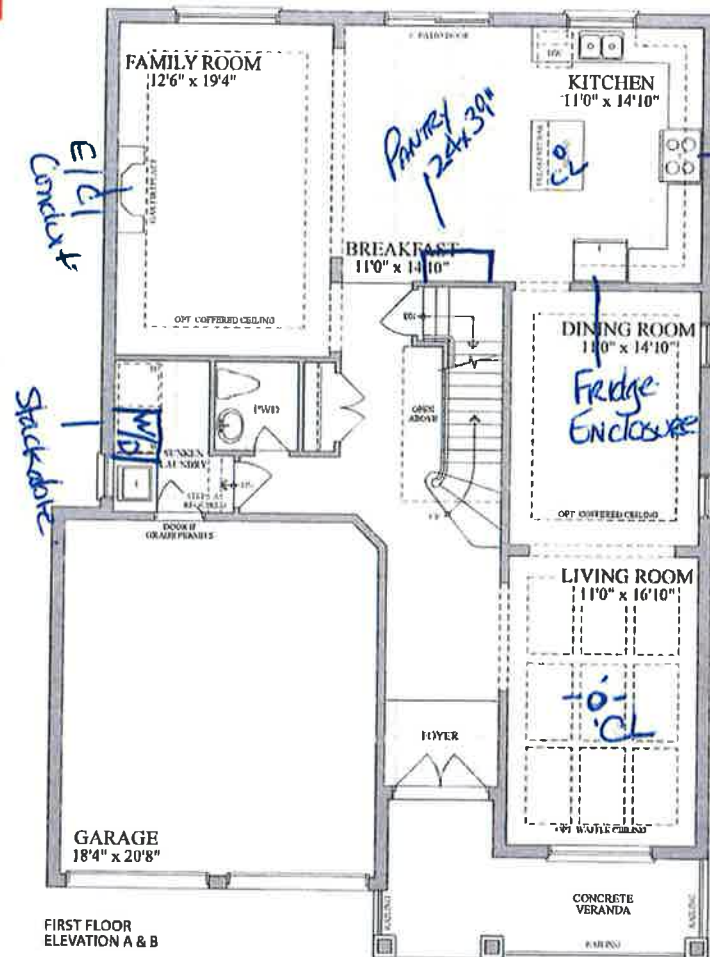


FIRST FLOOR
ELEVATION A & B

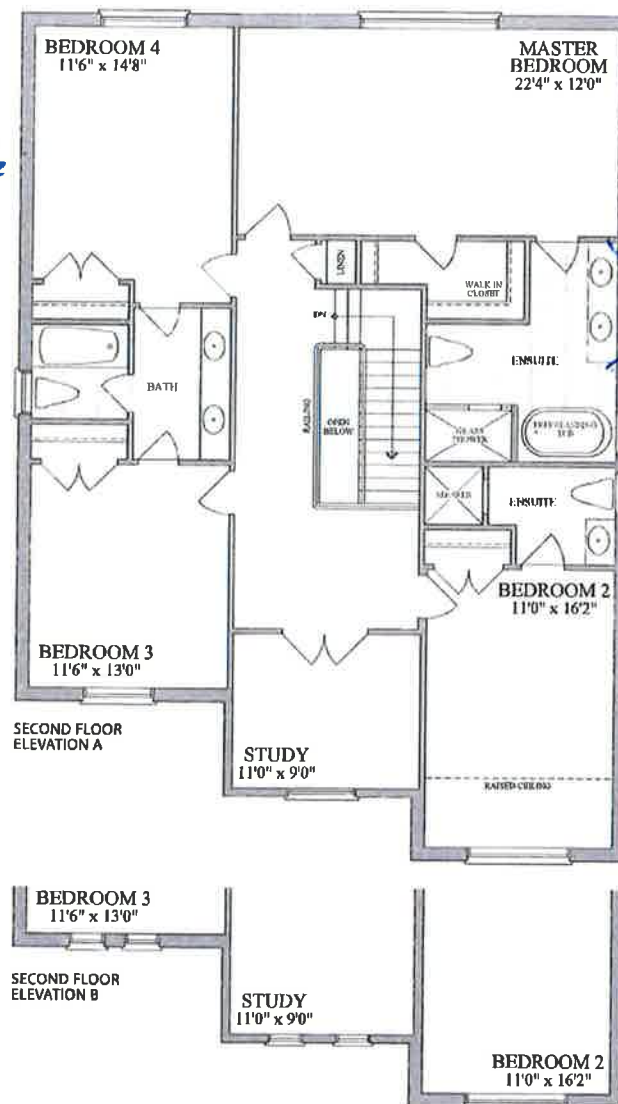

SECOND FLOOR
ELEVATION A

SECOND FLOOR
ELEVATION B

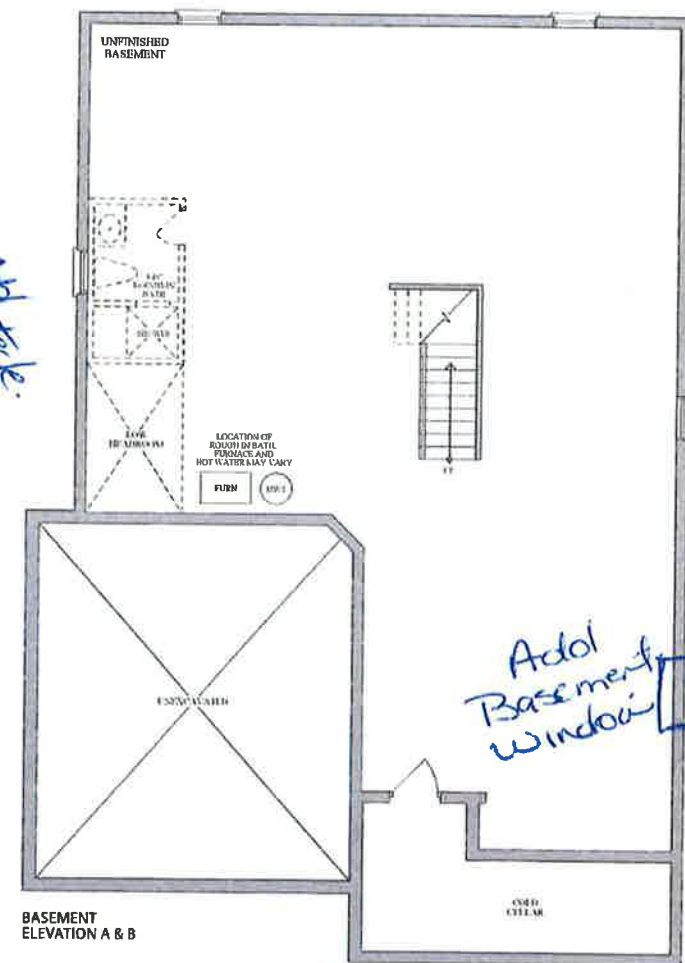

BASEMENT
ELEVATION A & B

LOT 5-56, PH5, INNISFIL, PE002

Madiha Shaikh

PURCHASER: Madiha Shaikh (Nov 24, 2021 12:01 EST)

PURCHASER: _____