


47th
DESIGNS





The Carlyle / Elev. A & B
2950 sq.ft.

E/c/s
VAC MOUNT

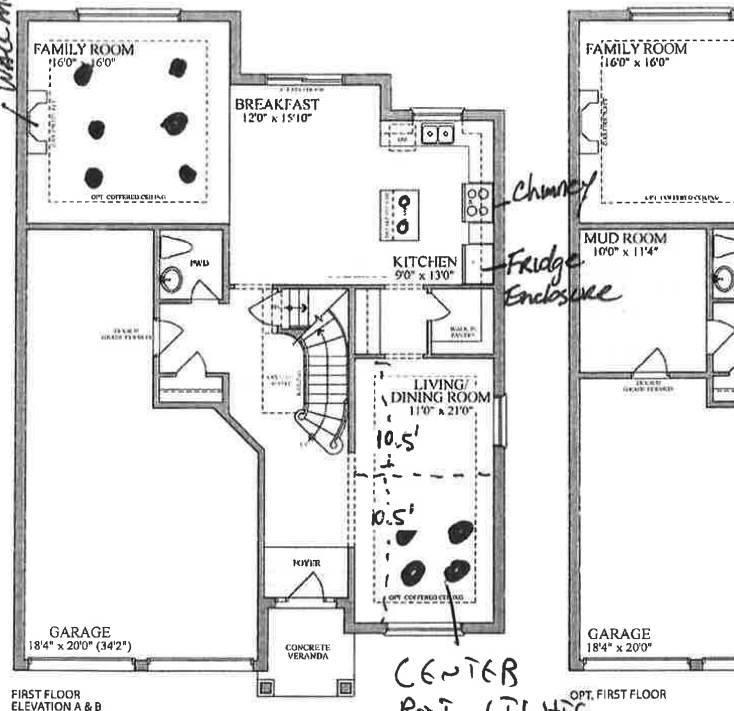

CENTER
POT LIGHTS
TO AREA

LOT 5-66, PE#002

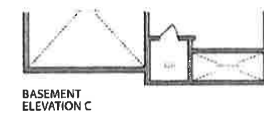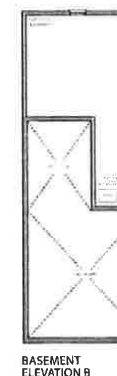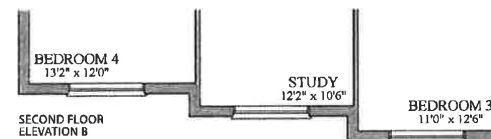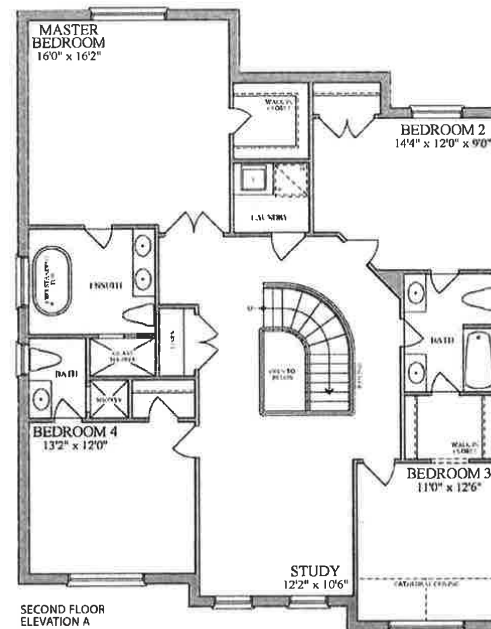

Plans and specifications are subject to change without notice. E & O E. Actual usable floor space may vary from the stated floor area. All measurements are artist's concept.