


47'
DESIGNS

The Kahshe / Elev. A & B
3000 sq.ft.

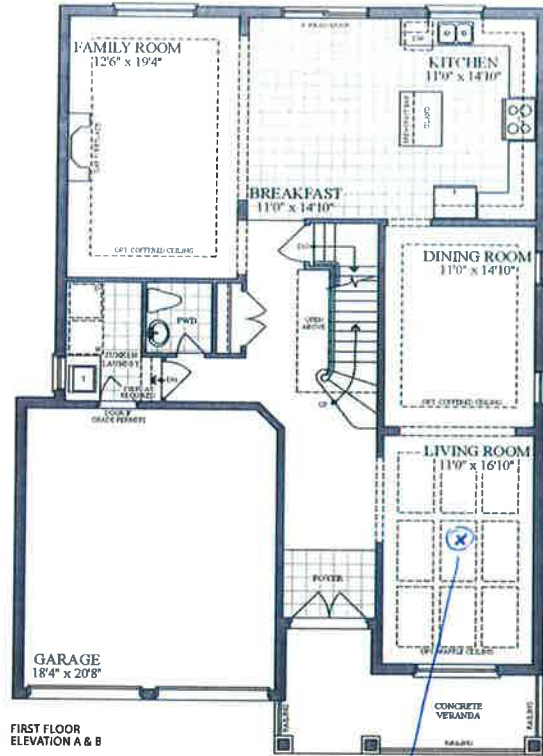


FIRST FLOOR
ELEVATION A & B



SECOND FLOOR
ELEVATION A

SECOND FLOOR
ELEVATION B

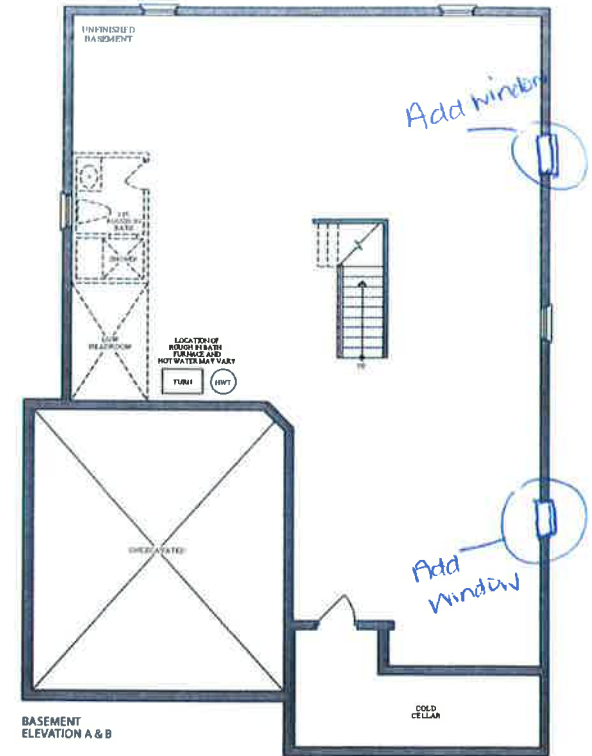

BASEMENT
ELEVATION A & B

LOT 5-69, Innisfil



Plans and specifications are subject to change without notice. E.A.D.E. Actual results from space may vary from the stated floor area. All renderings are artist's concept.